
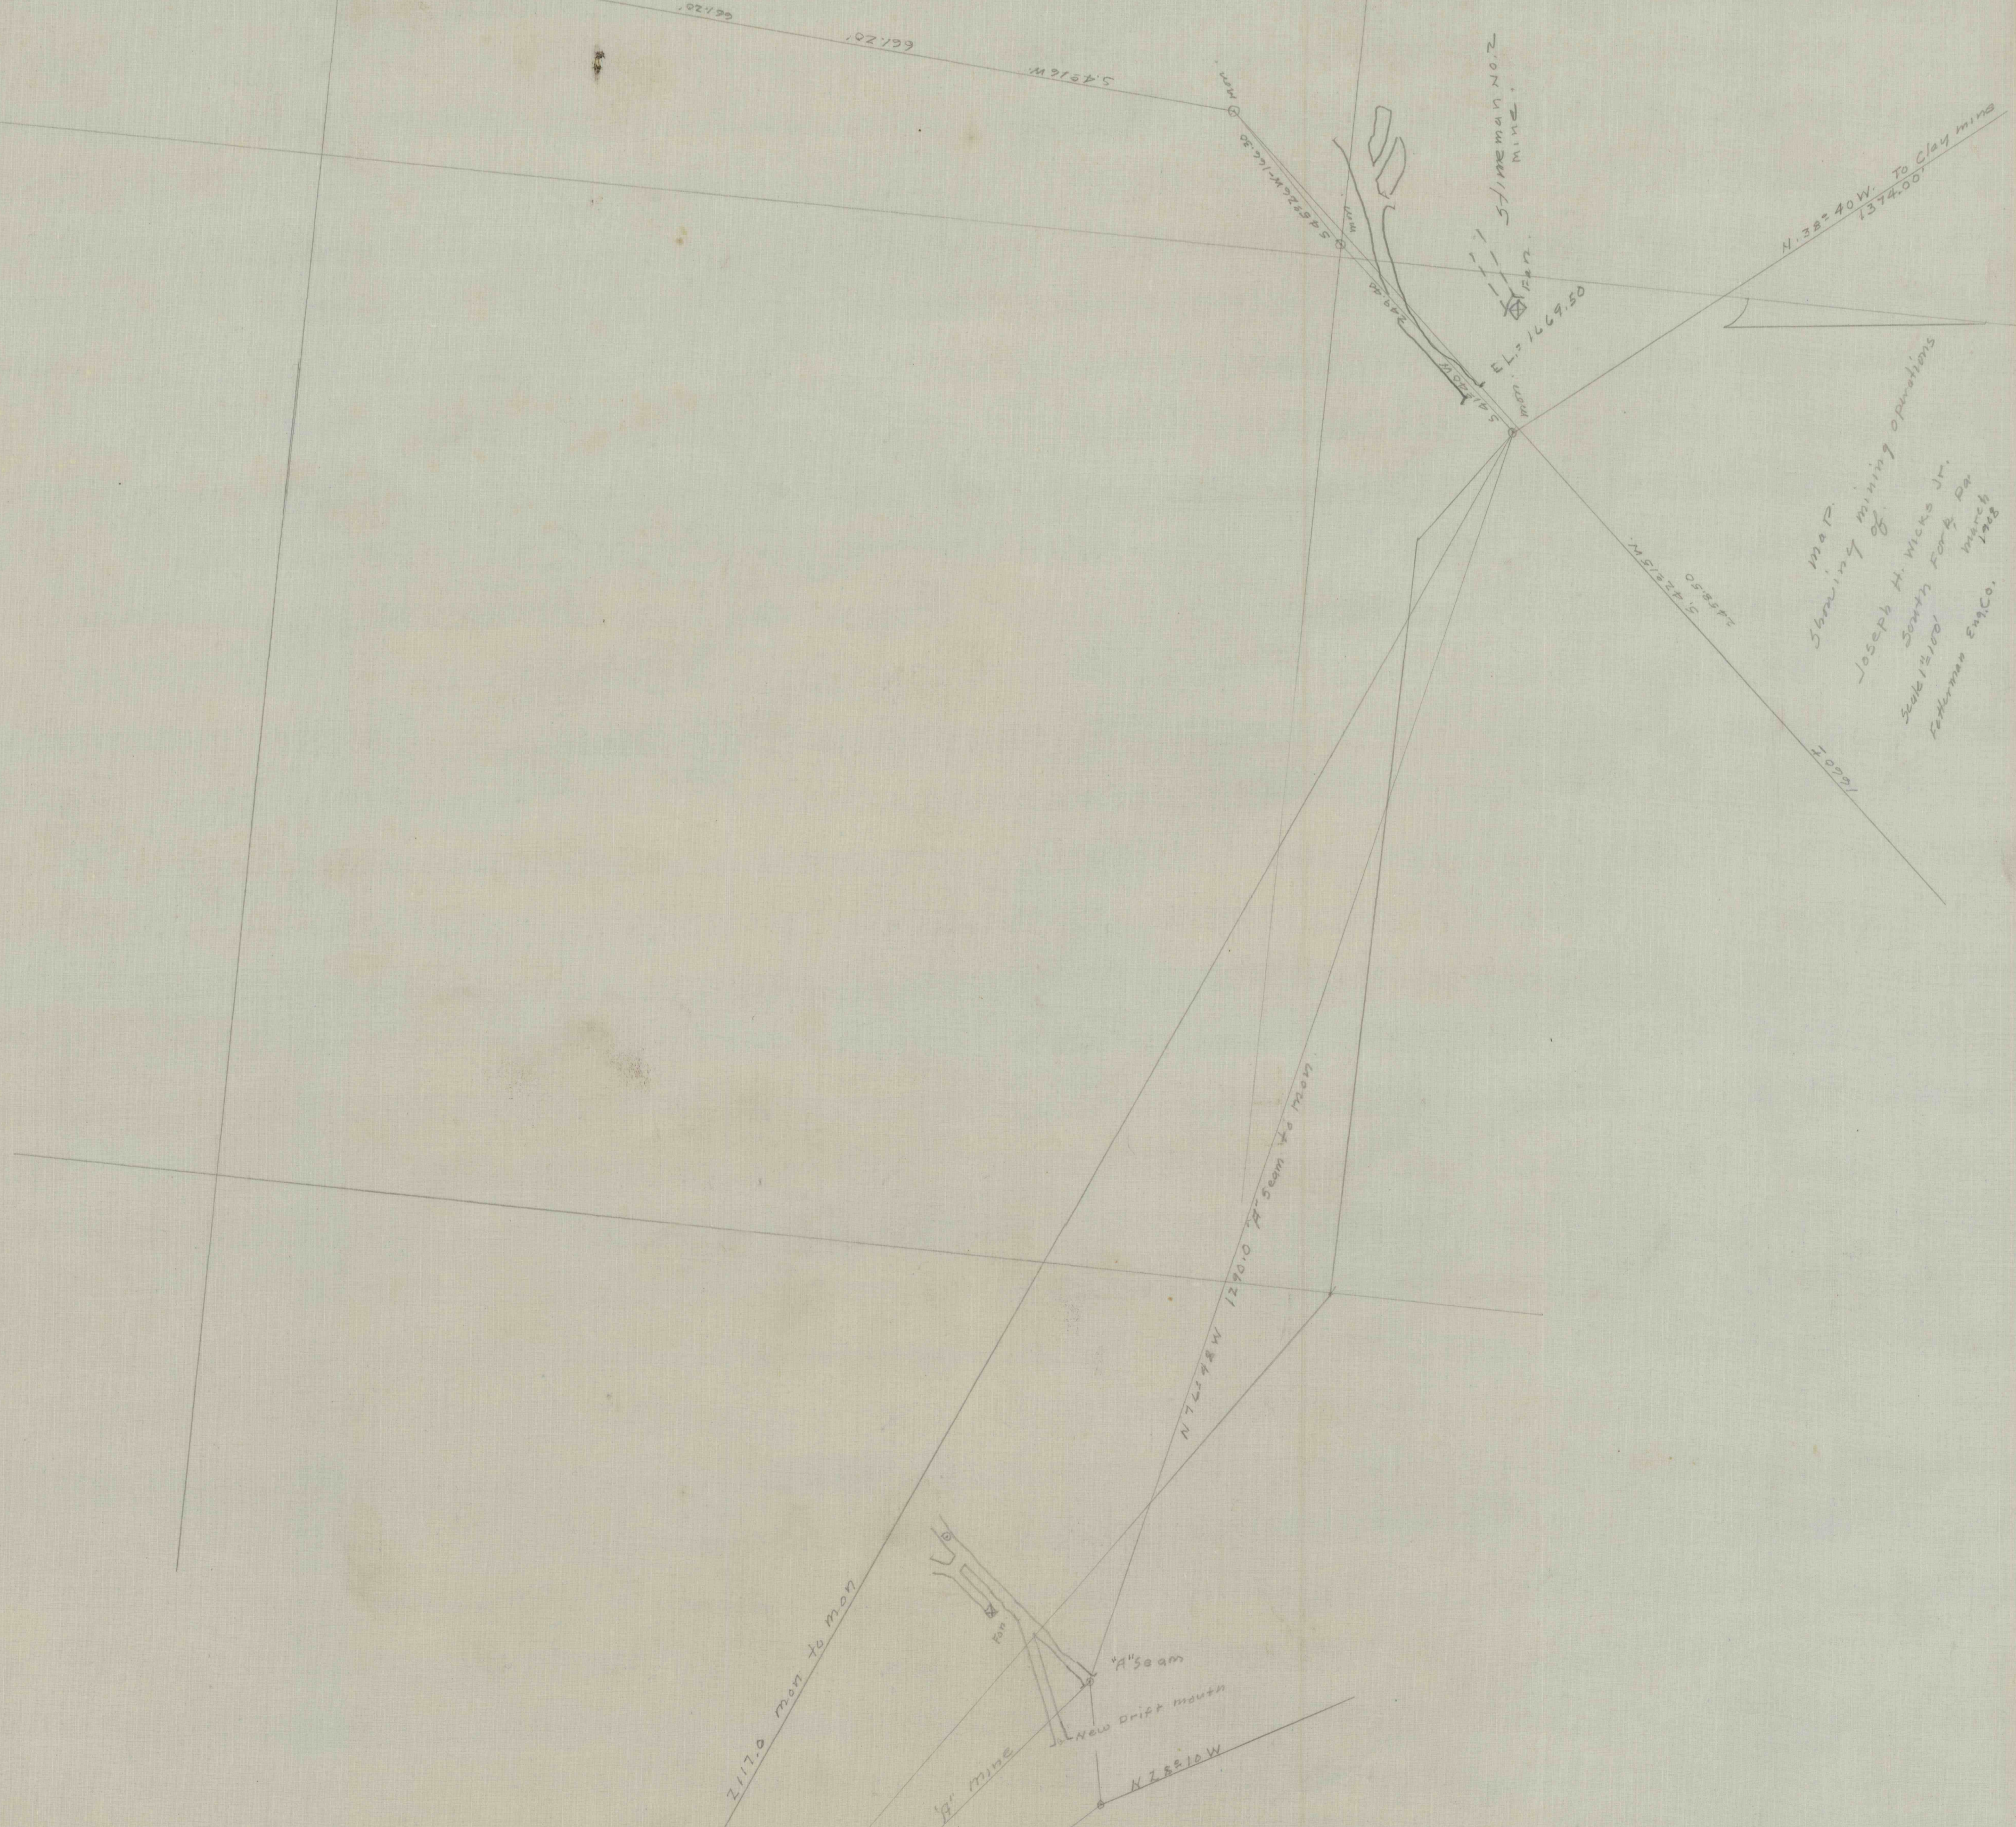


+ 1488.10
Elev on E' beam.

1517.50
1515.00
1513.50
(mean)

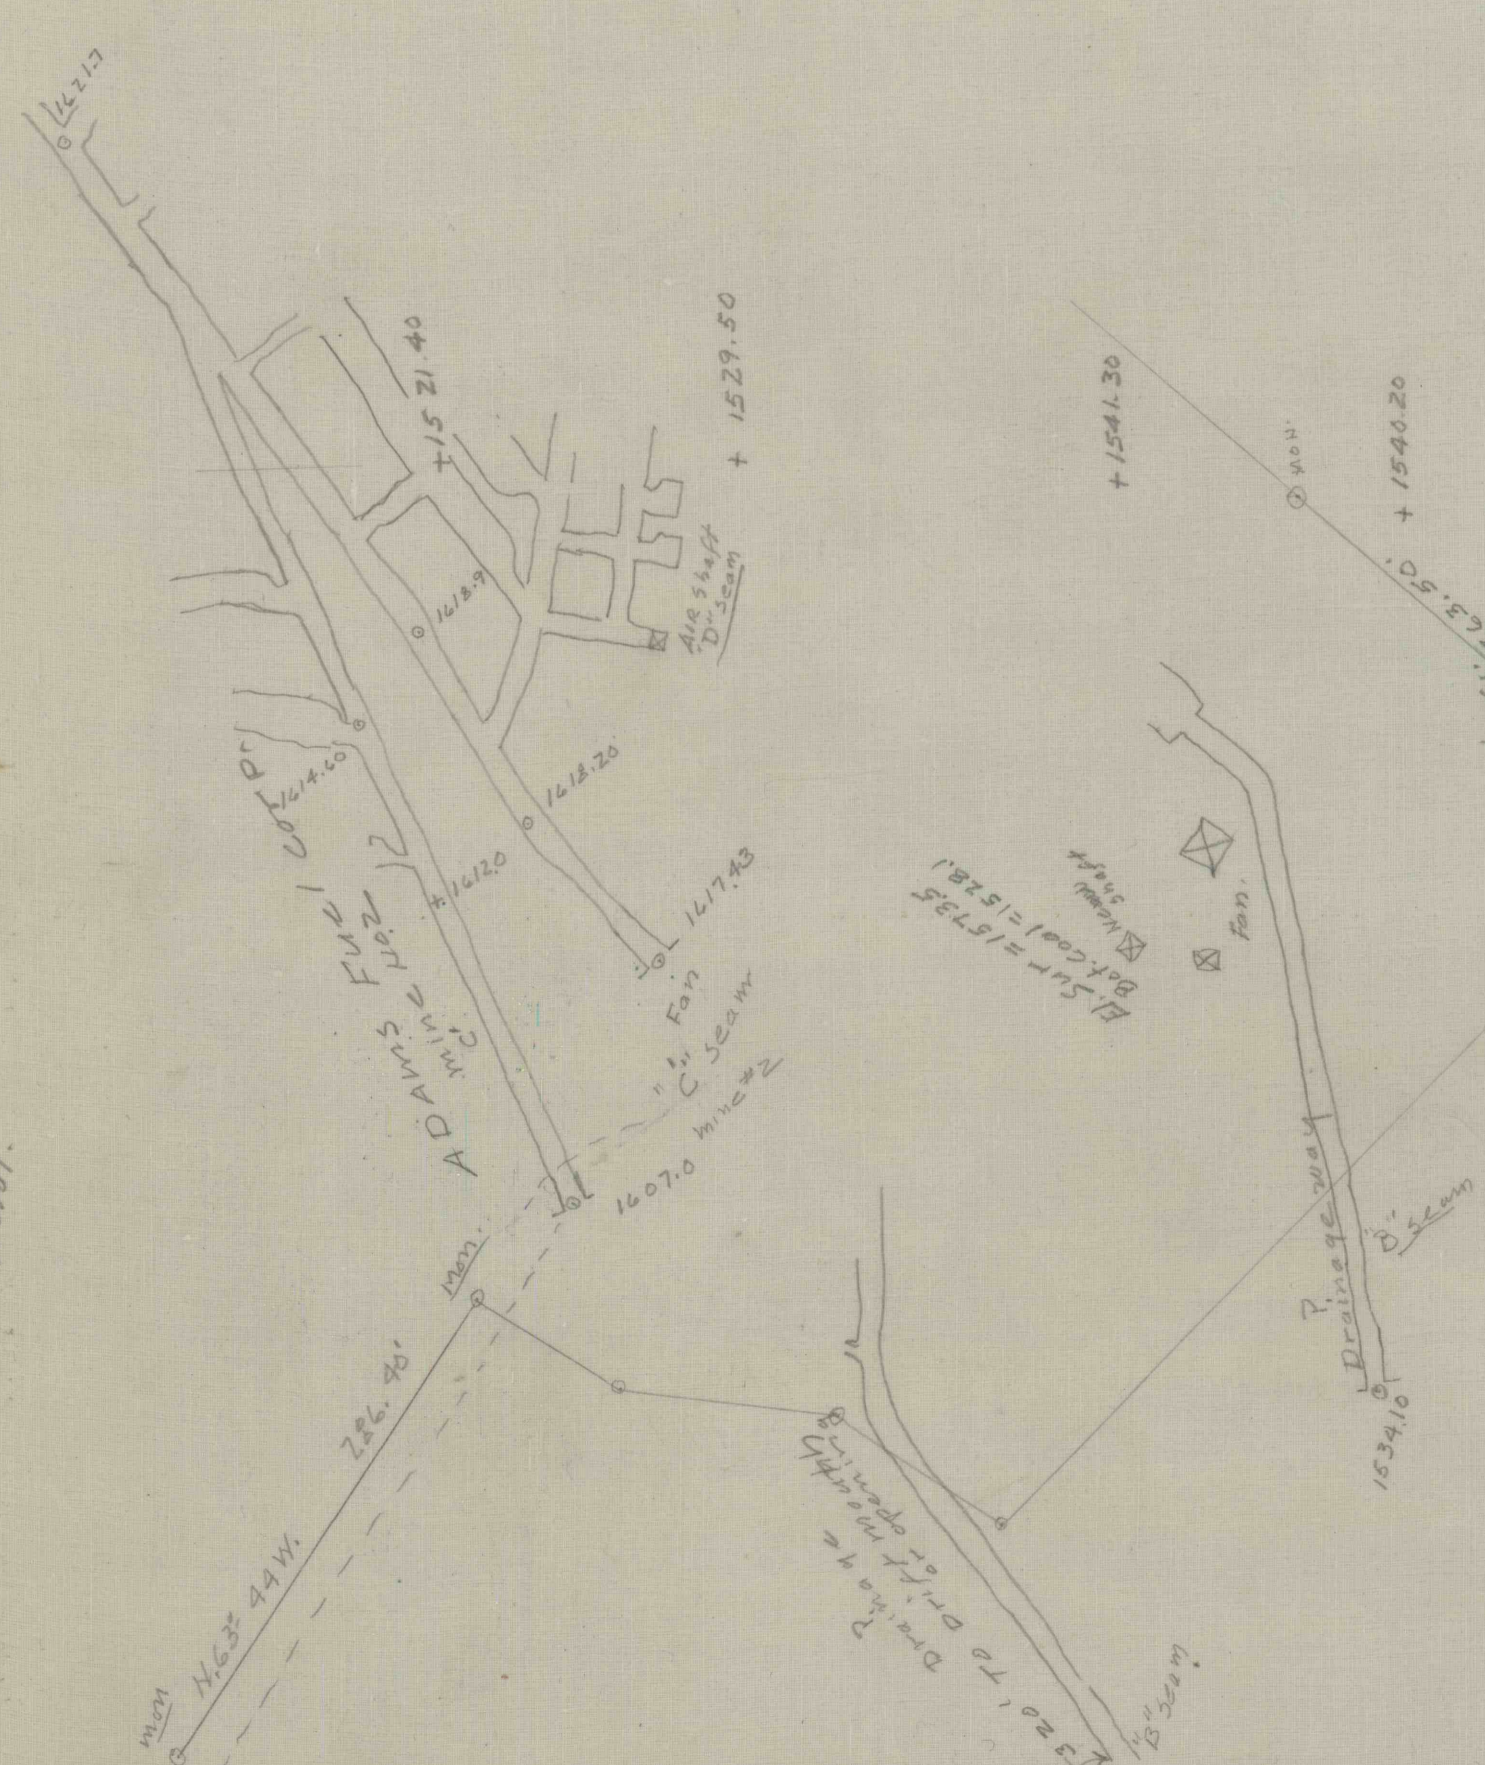

Map
Showing mining operations
