


Map
SHOWING MINES OF
ROCKWILLE COAL CO. & C. A. STINEMAN
IN PROPERTY OF
GEORGE B. STINEMAN ESTATE
South Fork Pa.
SEPT. 1910. FETTERMAN ENG. CO.
SCALE 1"=100'

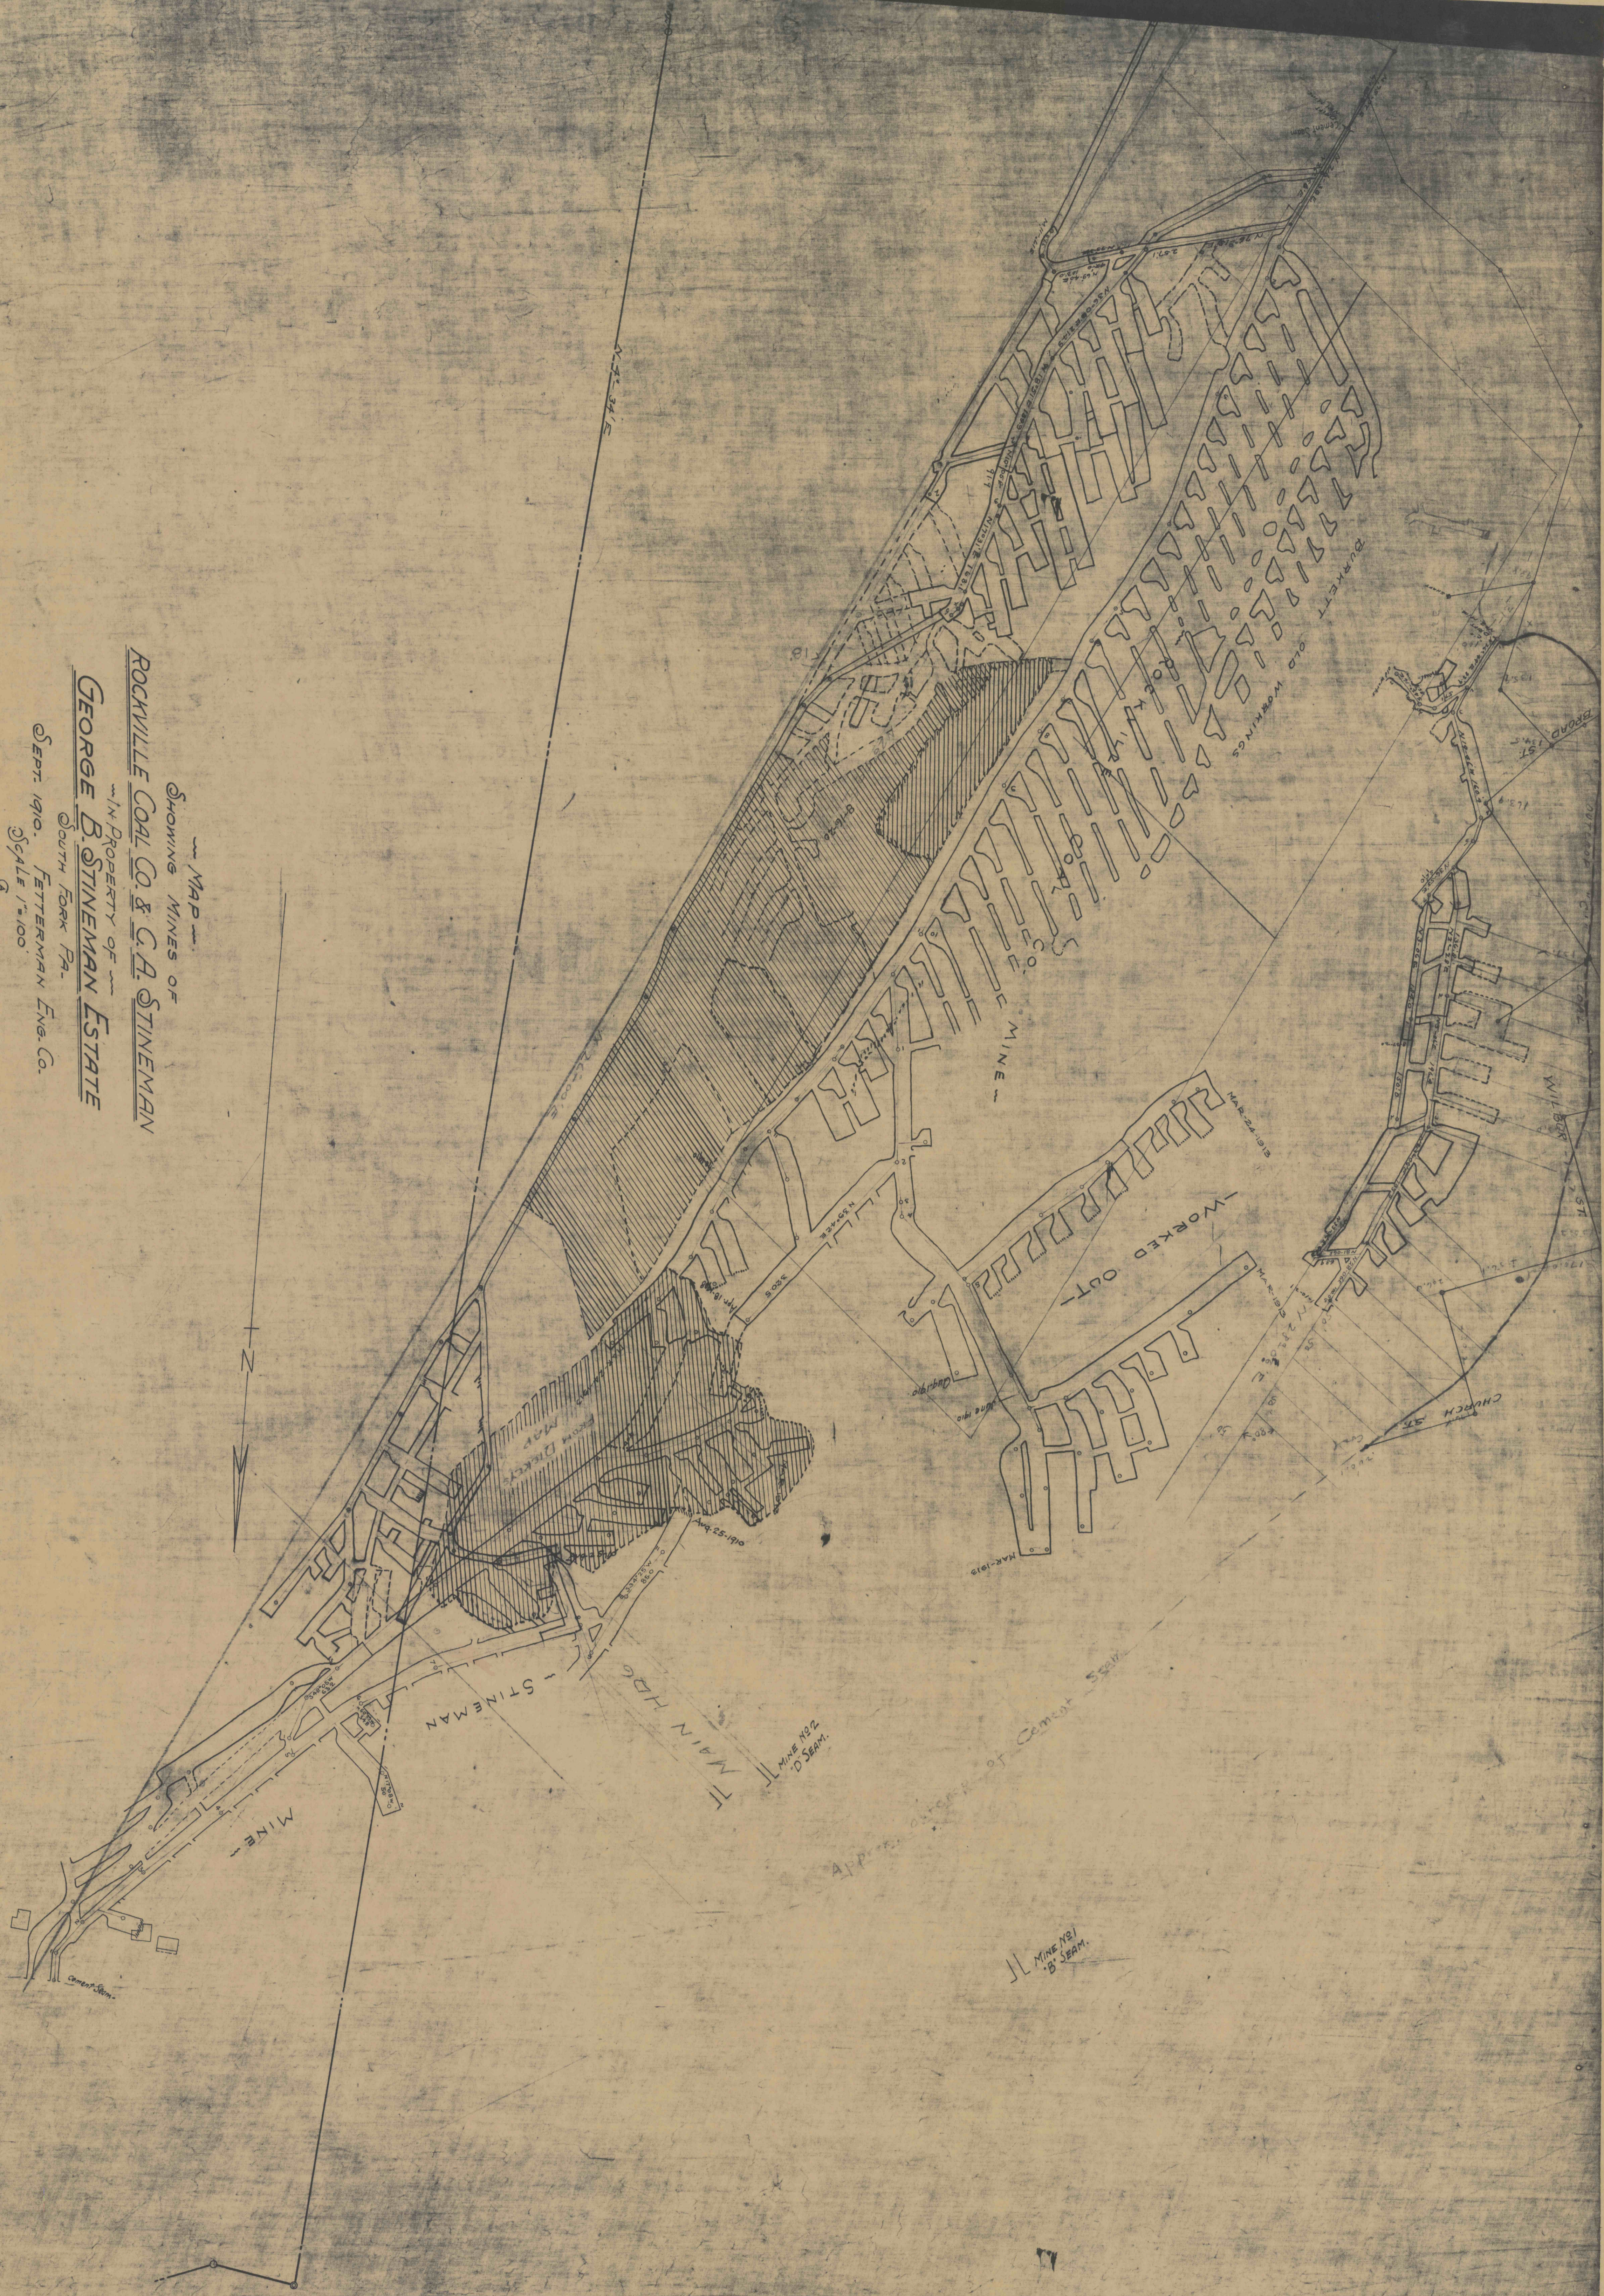




