


55-30

57-11
55-30
3-41

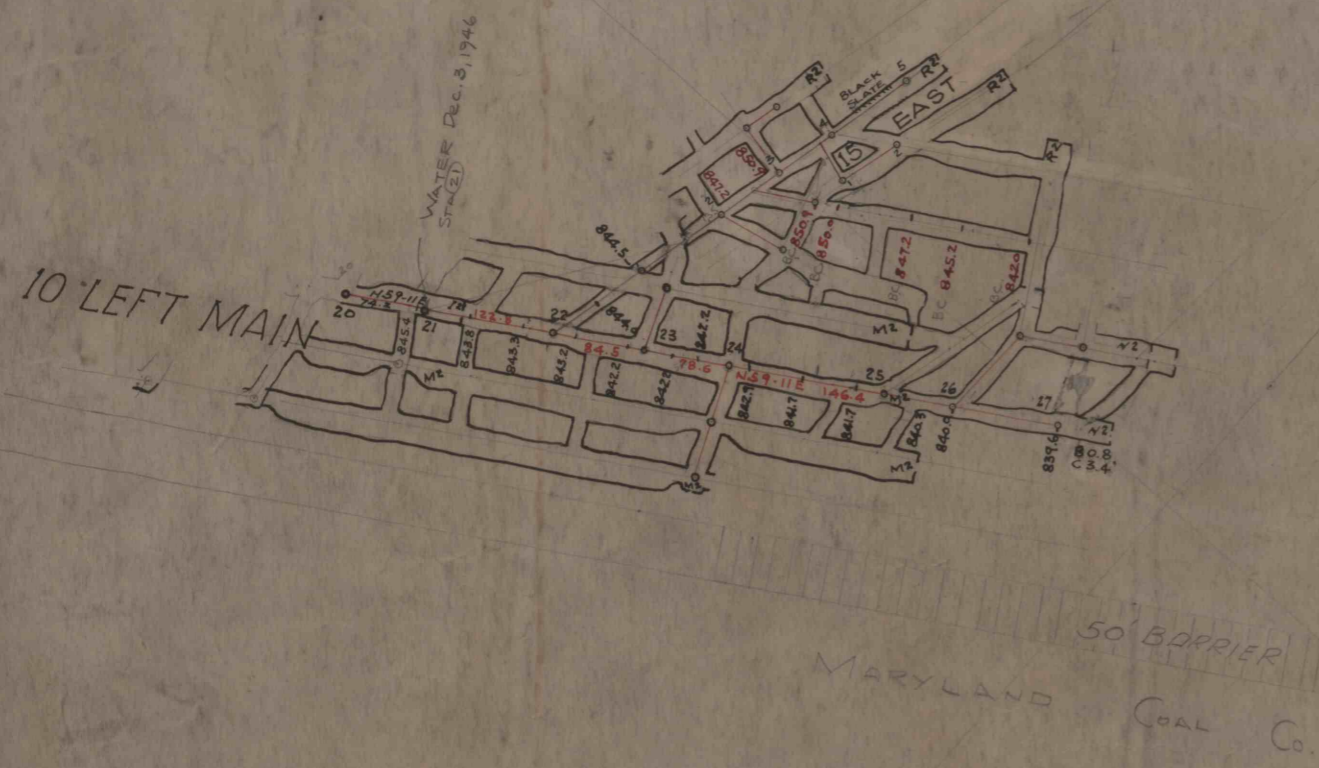

R² = DEC 2, 1946

Rolled
with
ET-112

No. 4
10 LEFT MAIN

E11000

S55000

S4000
E12000

Y J: 45° E