

LANTZY

KILDEA



ROBERT KILDEA

WILLIAMS FORSMAN

JOHN SOMMERVILLE

JOHN WHITED

D. R. GOOD

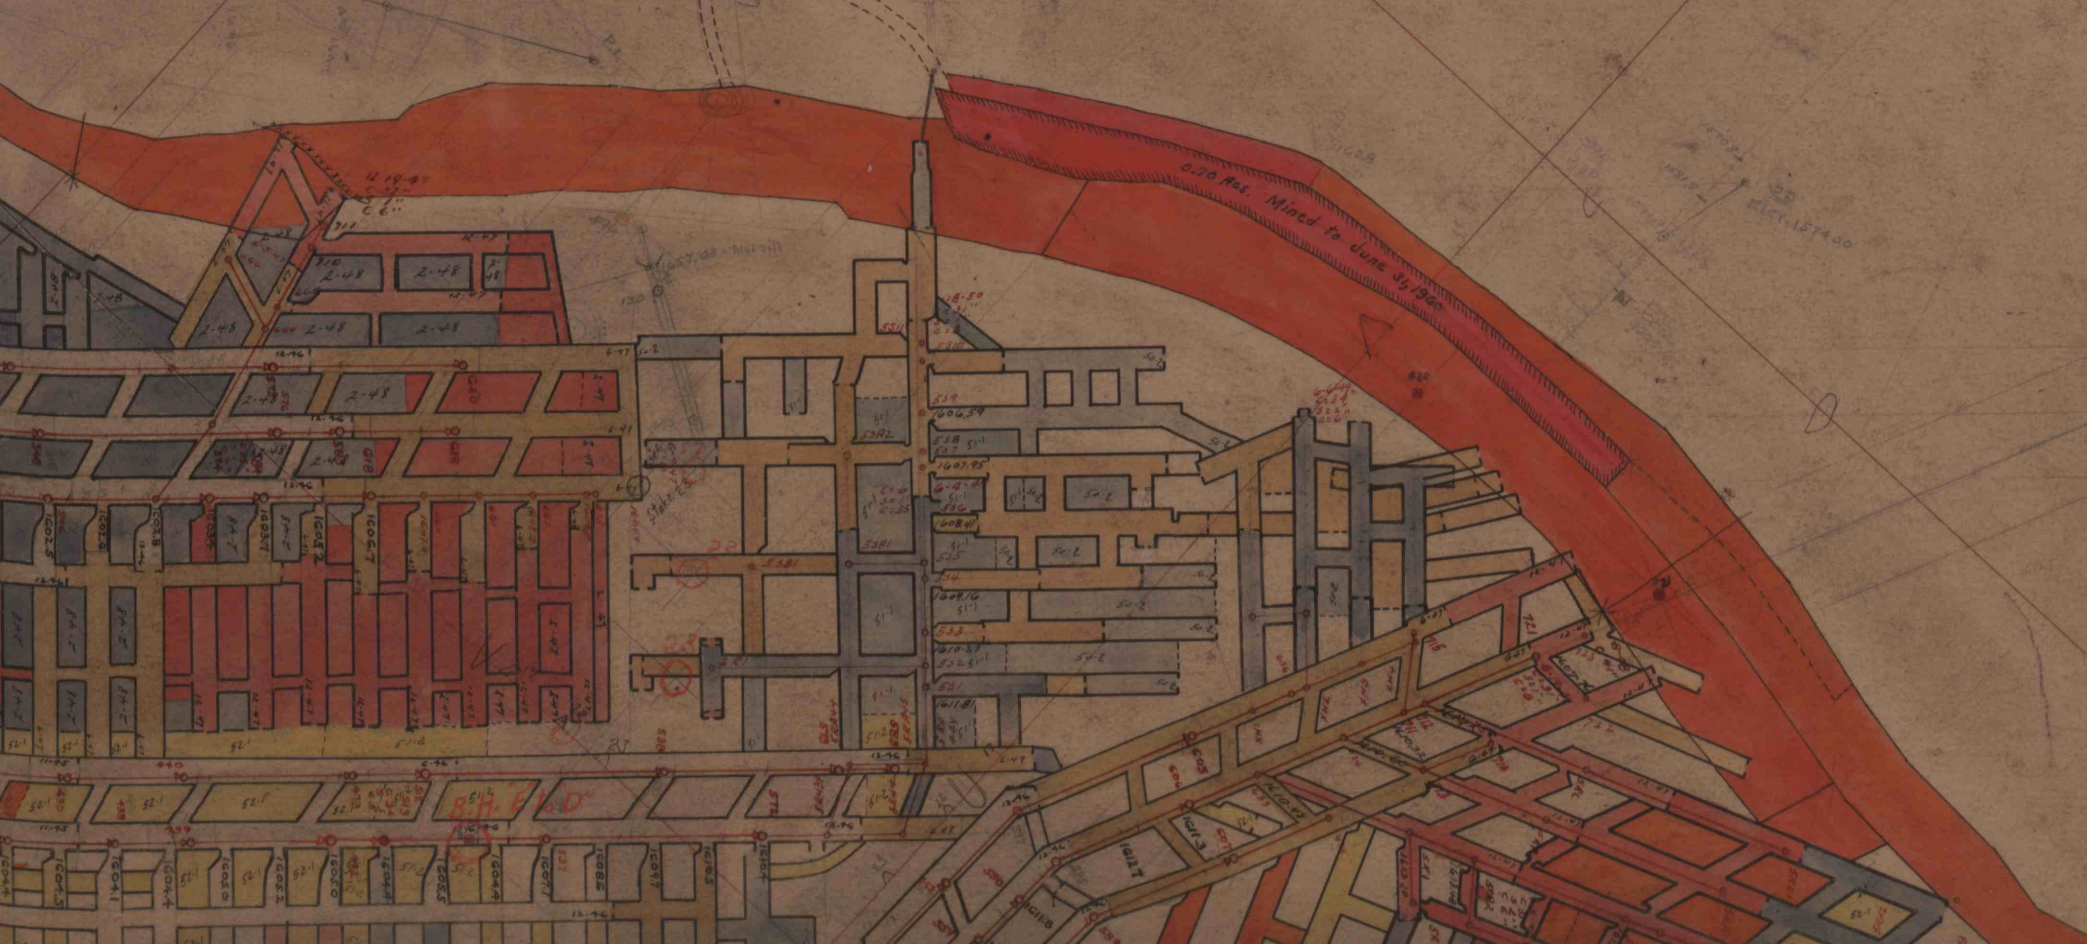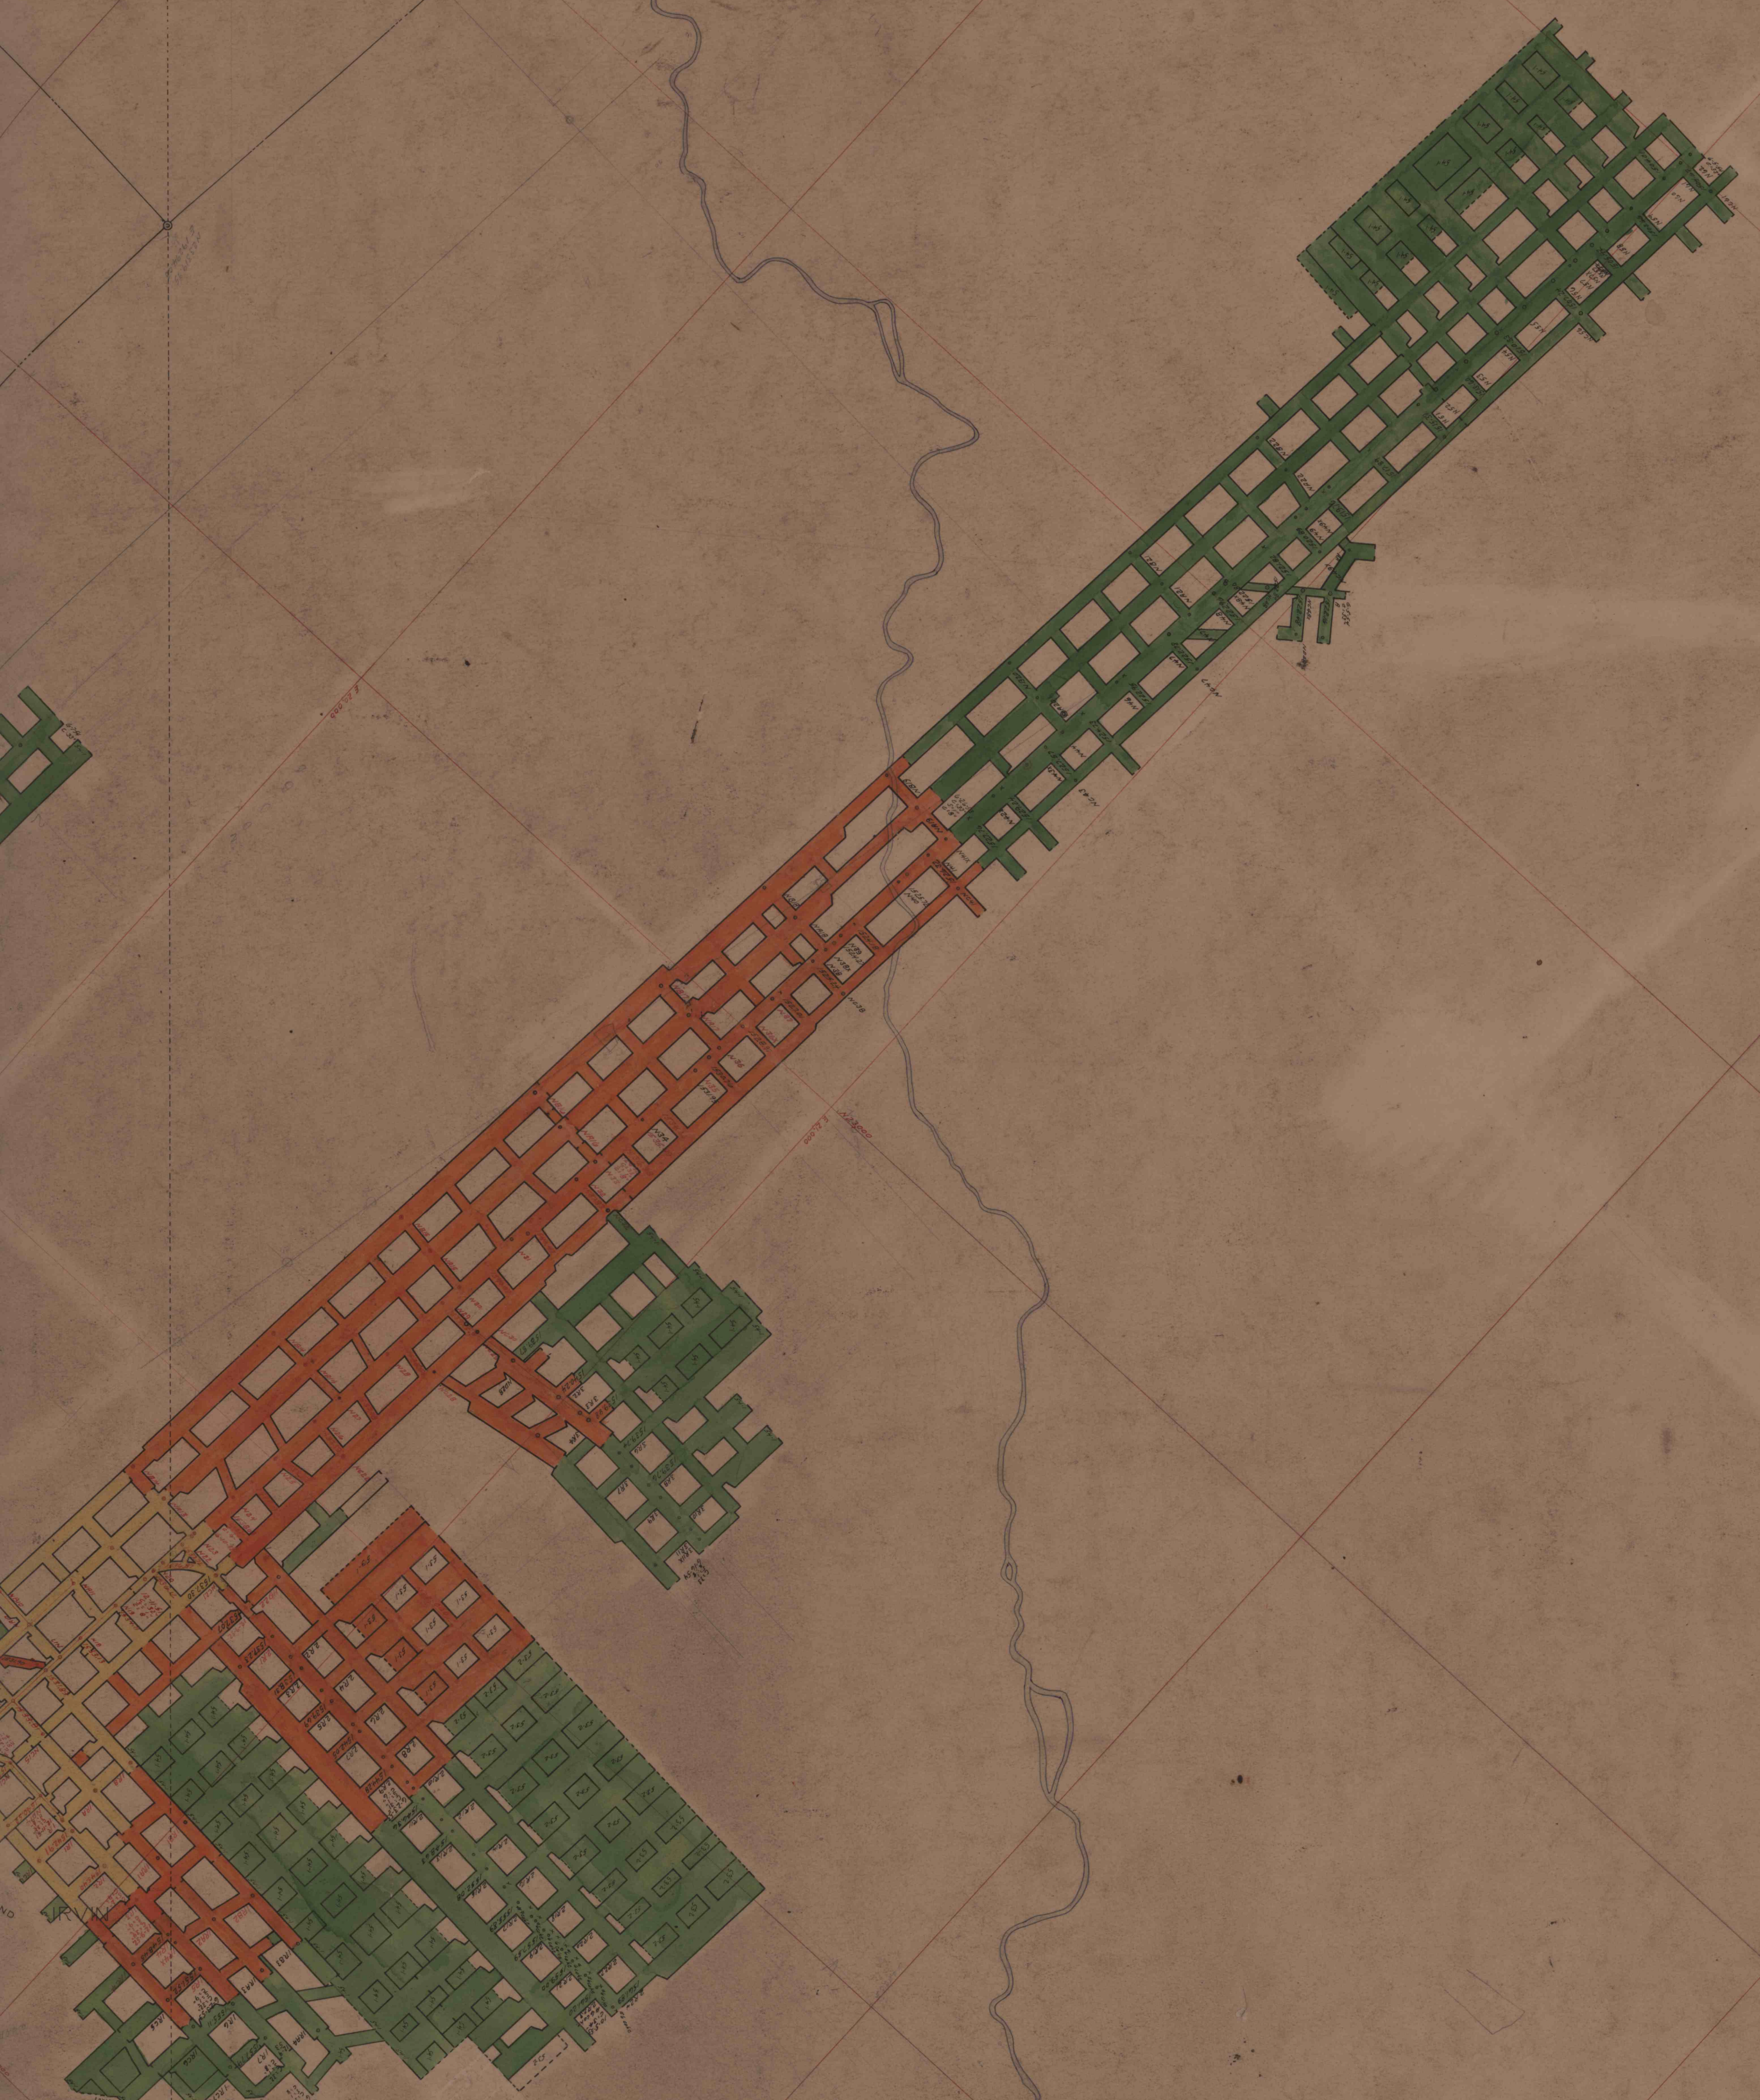

SUMMARY OF 1/4 SECTION

SECTION	AREA	OWNER
1		
2		
3		
4		