

Sec # 3  
224

4A Vent. BH  
Surface 1310.31  
B. Coal 693.00

SHANNON MINING COMPANY  
SHANNON MINE  
BOX 364  
BOBTOWN, PA 15315

Greene County  
Scale: 1" = 100'

Dunkard, Perry, Greene, Whiteley Twp.  
Survey Date: 7-1-92


Engineer  
T. J. FERENCI  
7-15-92 To 1-15-93

**Legend**

- Contemplated Mining
- Subsidence Control Boundary
- Permit Boundary
- Mining Completed Area
- Support Area
- Previous 6 Month Mining Area
- Surface Property Owners
- Support Area After Mining
- Structures Protected Pre 4-27-86
- Structures Not Protected
- Structures No Longer in Existence

**Notes:**

1. Mineral Ownership (Pgh Seam) - LTV Steel Company
2. Surface Ownership - See Computer Data Sheet

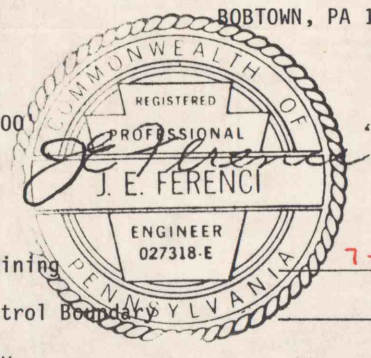

DAVID M. GARRISON

SEC # 3  
224