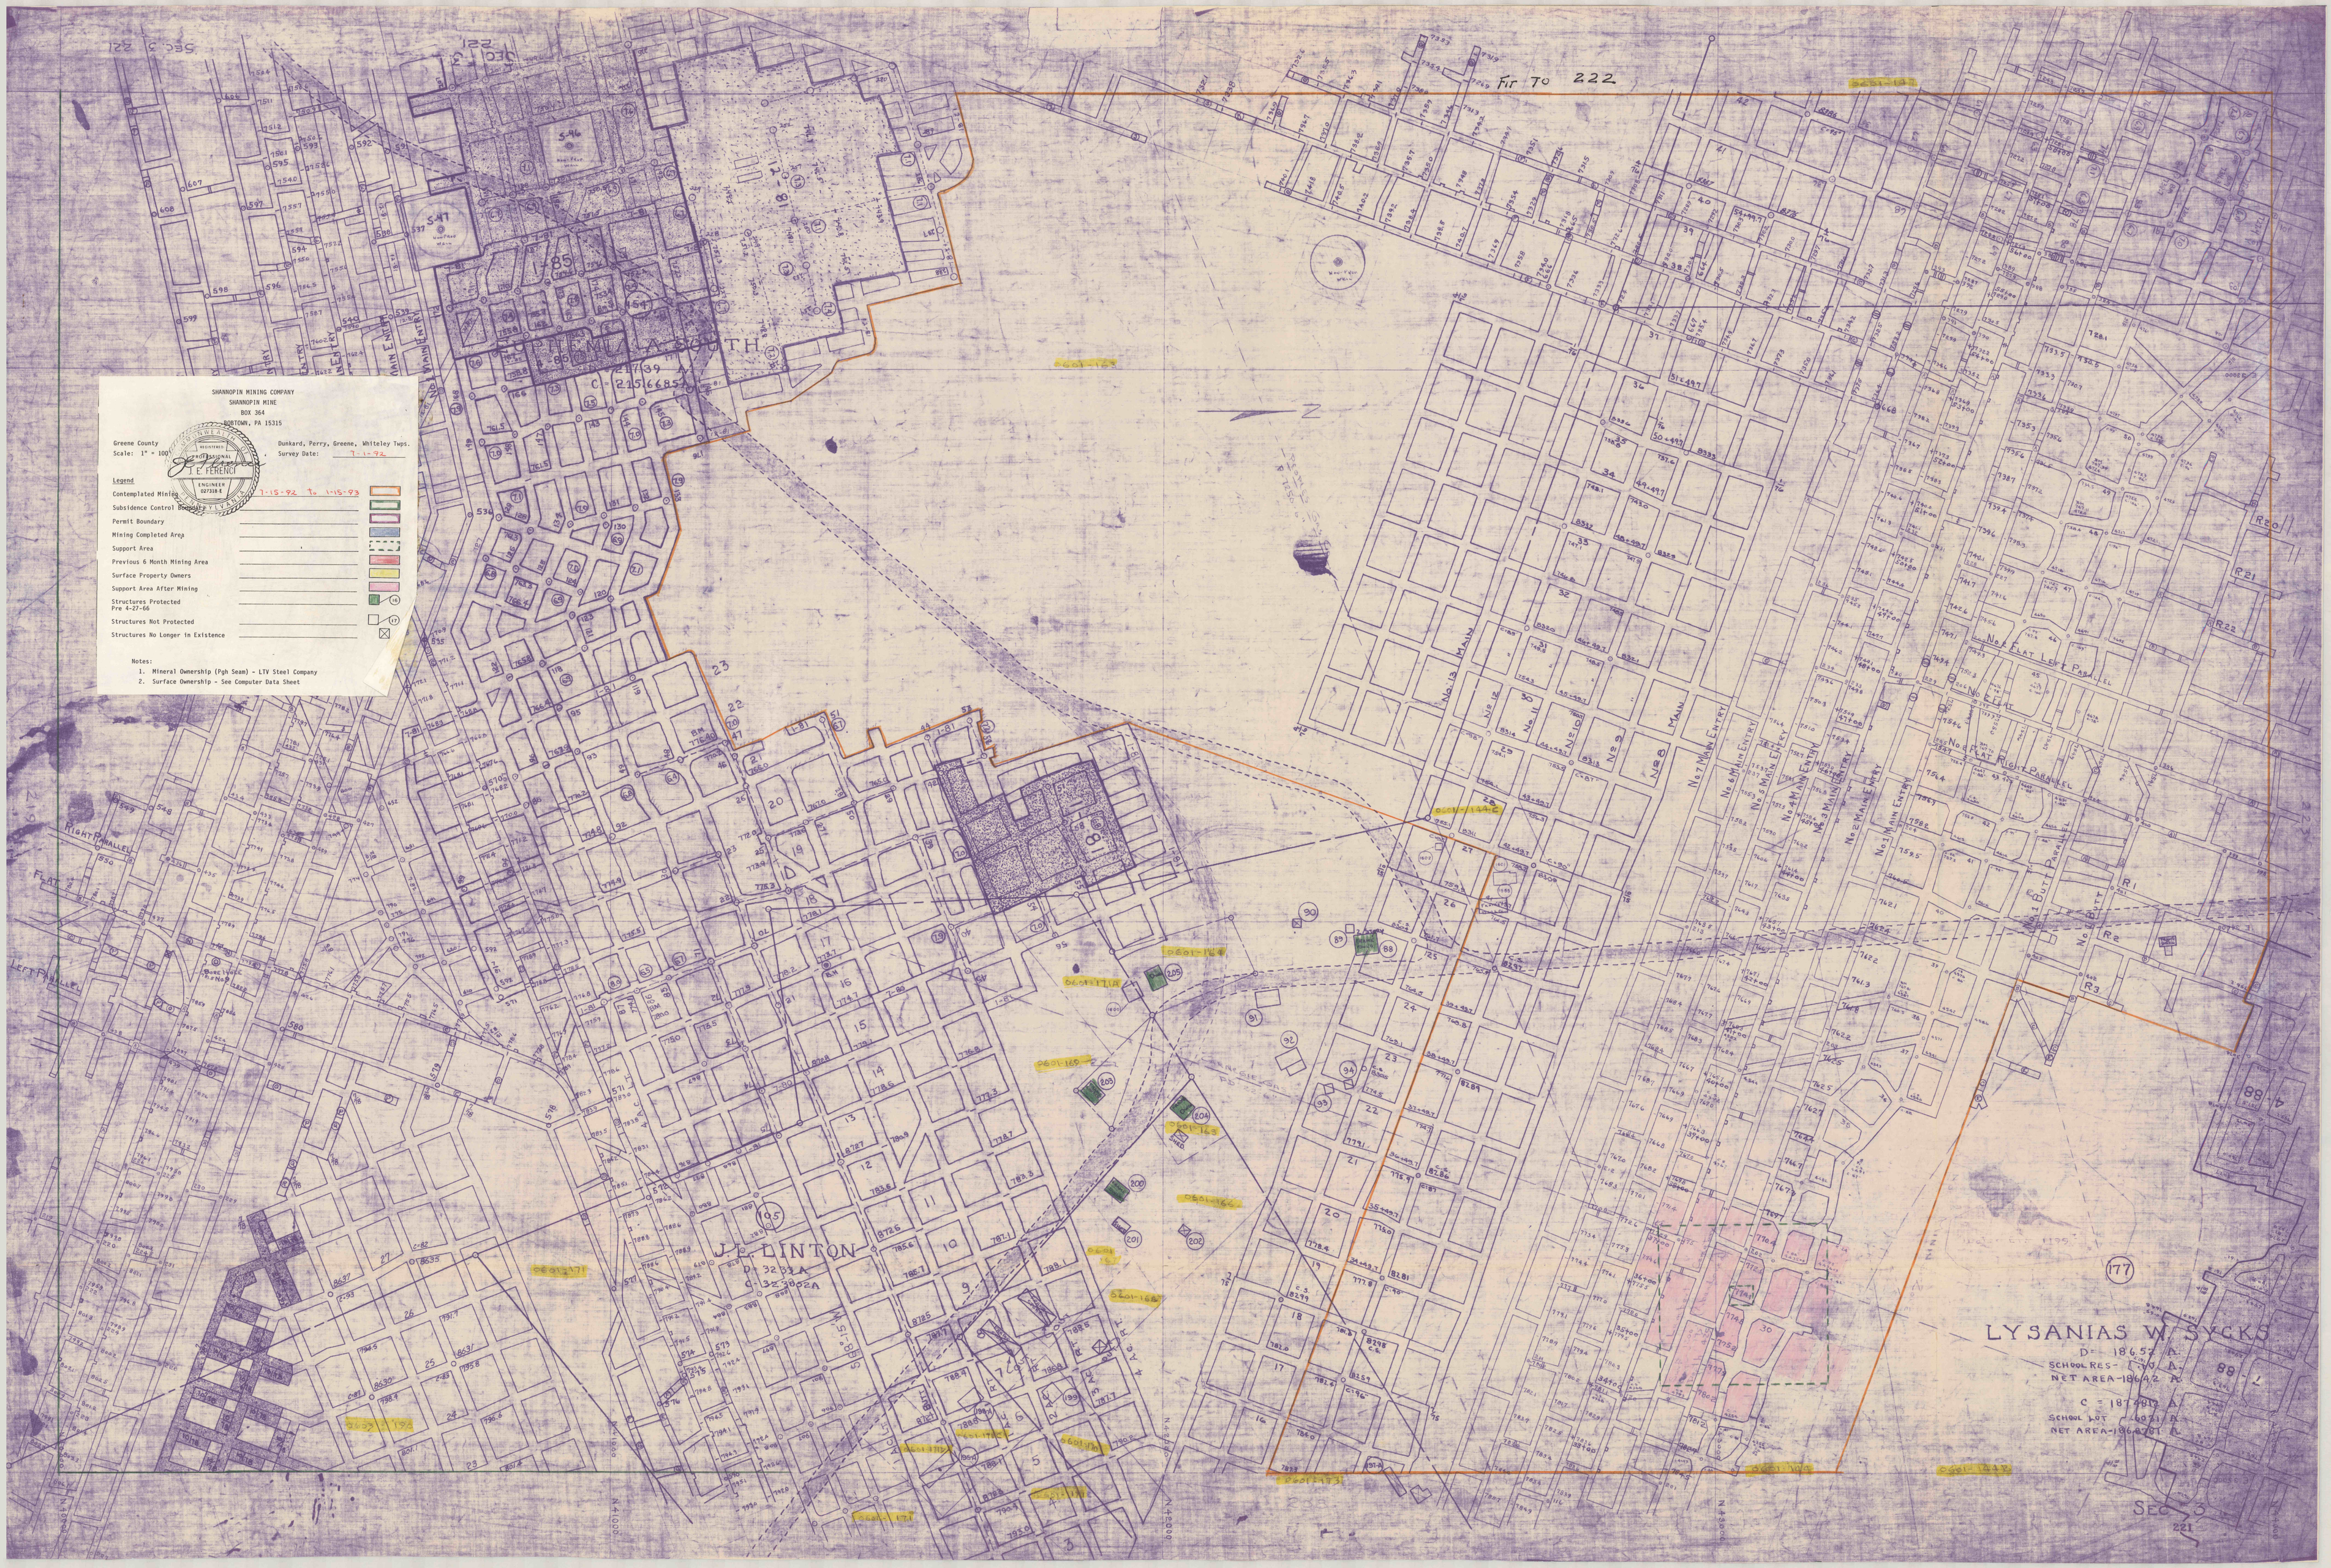
SHANNOPIN MINING COMPANY
SHANNOPIN MINE
BOX 364
BOBTOWN, PA 15315
Greene County
Scale: 1" = 100'
Dunkard, Perry, Greene, Whiteley Twps.
Survey Date: 7-1-92
J. E. FERENCI
ENGINEER
027318-E
Legend
Contemplated Mining 7-15-92 To 1-15-93
Subsidence Control Boundary
Permit Boundary
Mining Completed Area
Support Area
Previous 6 Month Mining Area
Surface Property Owners
Support Area After Mining
Structures Protected Pre 4-27-66
Structures Not Protected
Structures No Longer in Existence
Notes:
1. Mineral Ownership (Pgh Seam) - LTV Steel Company
2. Surface Ownership - See Computer Data Sheet
Fit To 222
EUPHEMIA A. SOUTH
J. L. LINTON
LYSANIAS W. SYCKS
D = 18652 A.
SCHOOL RES - 1.10 A.
NET AREA - 18642 A.
C = 1874812 A.
SCHOOL LOT - 6021 A.
NET AREA - 1868781 A.
SEC 3
221