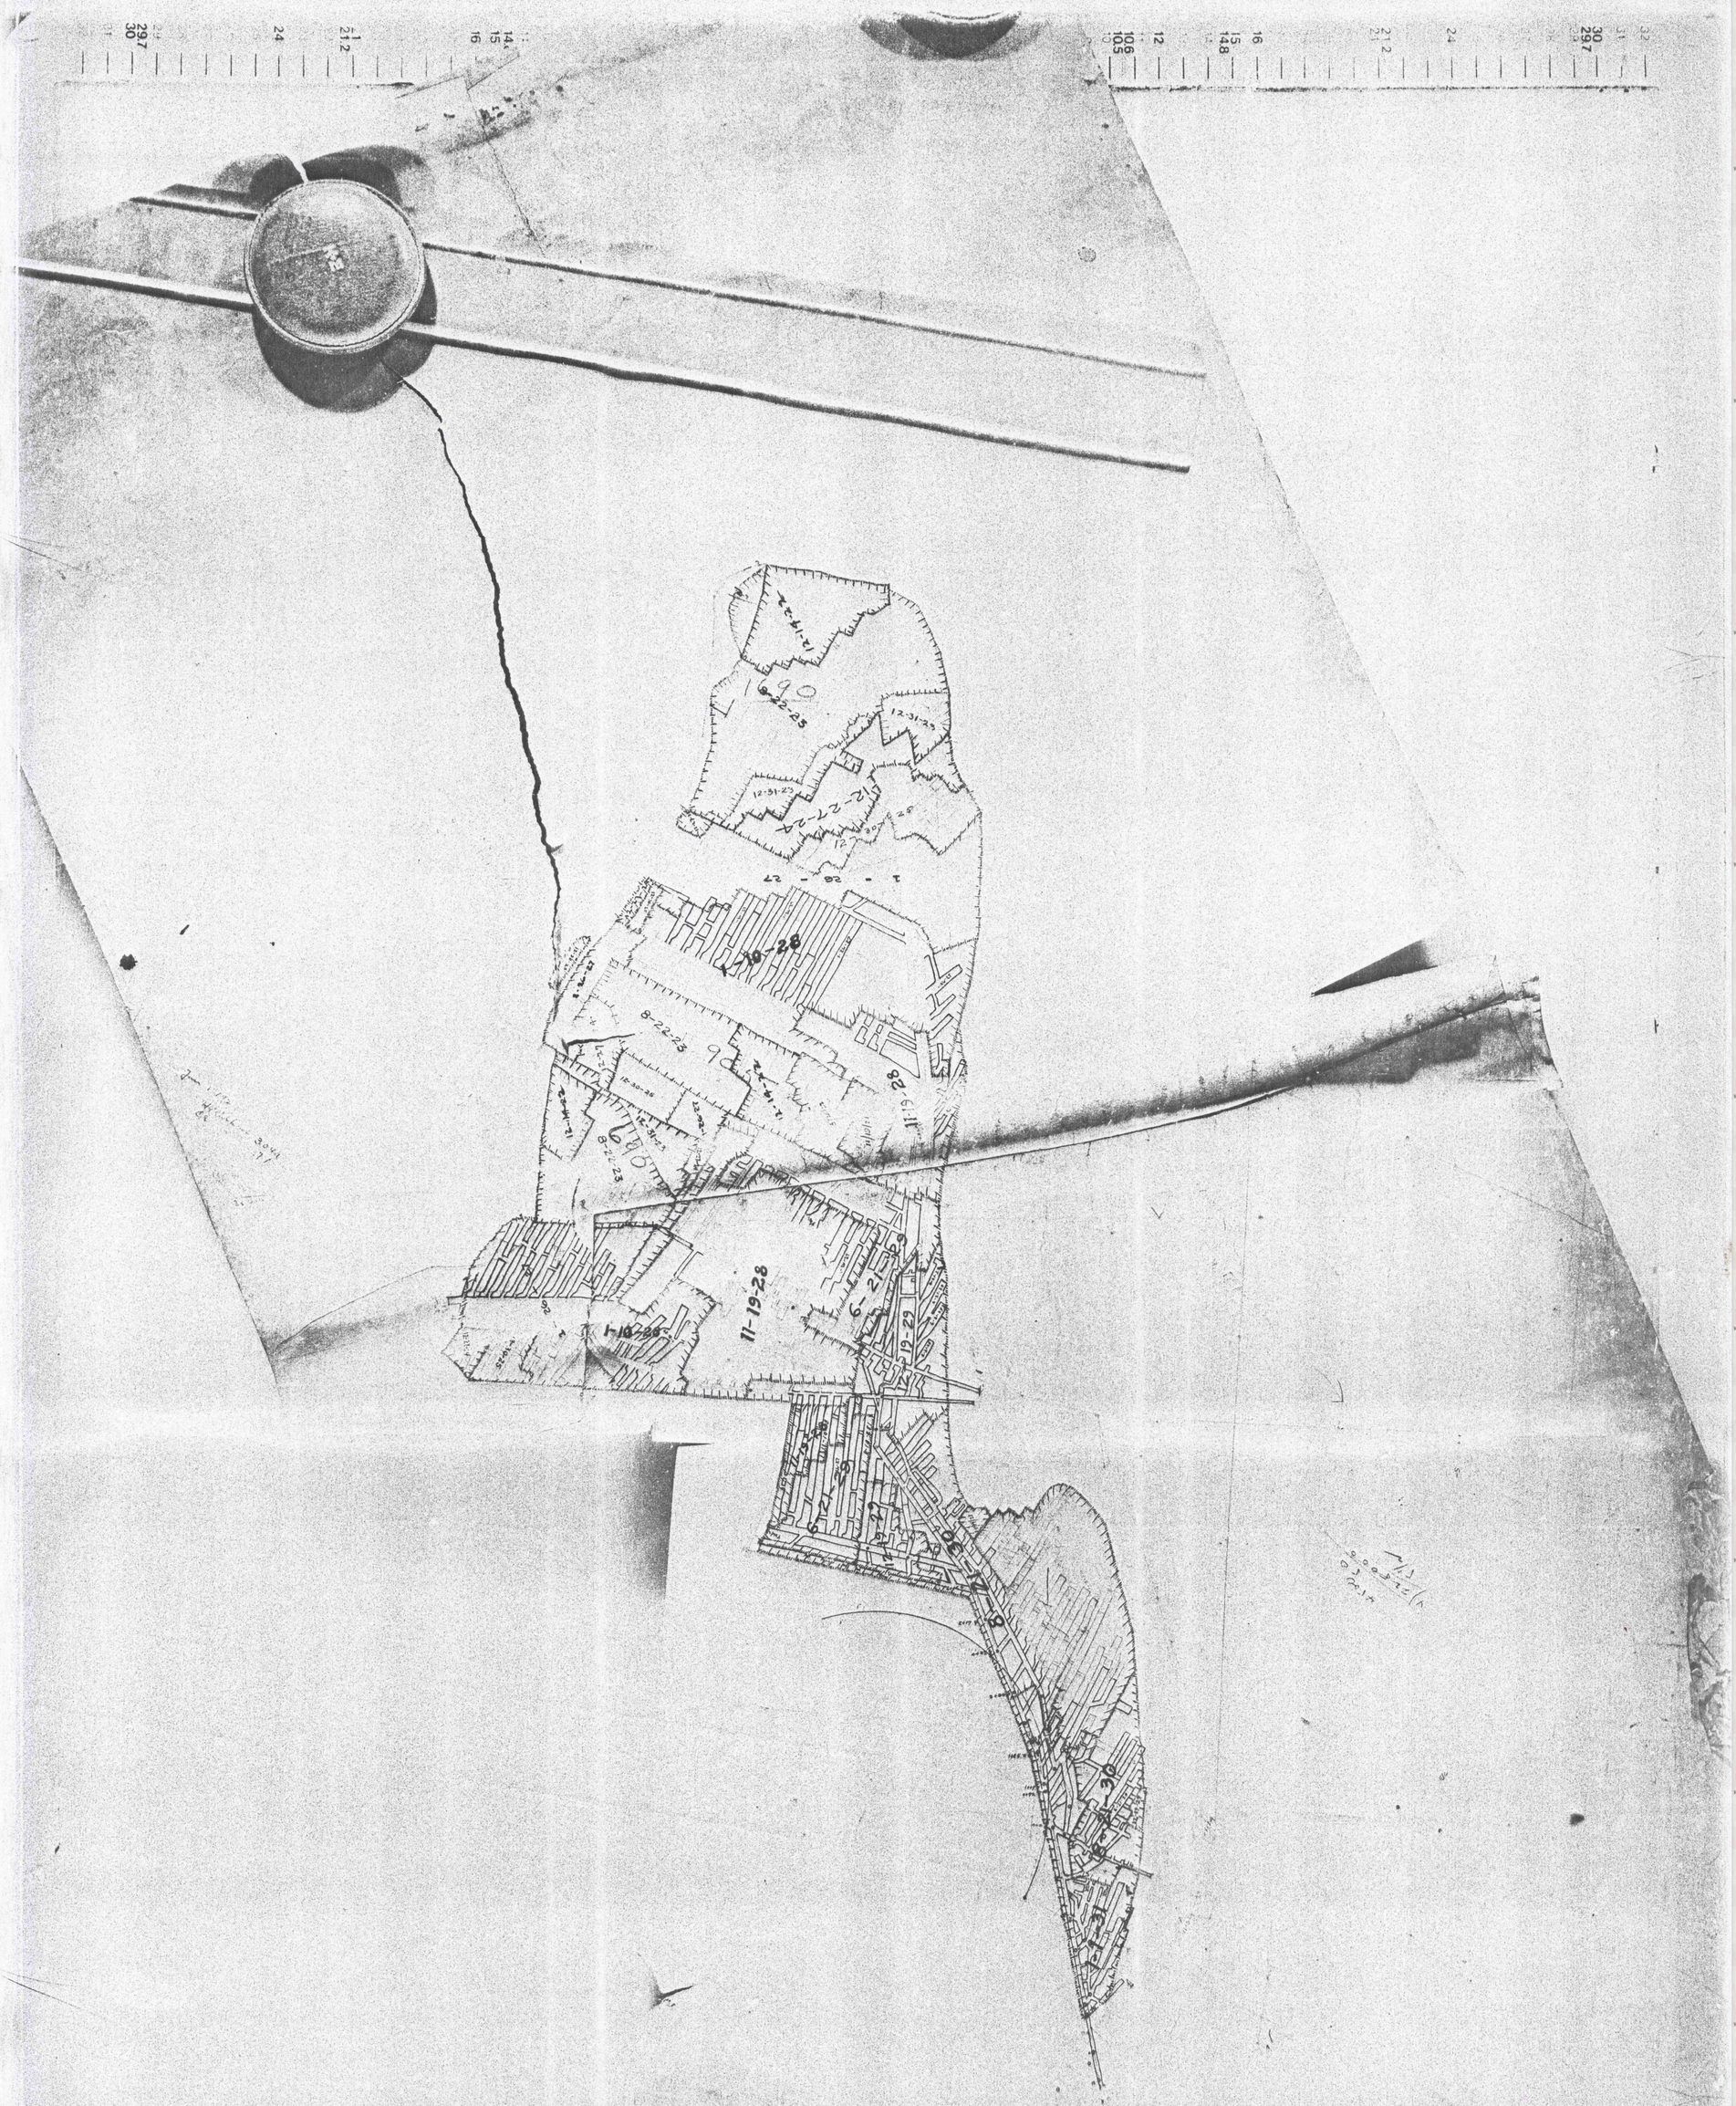
11-19-28
1-19-28
6-27-29
6-27-30
