


SURFACE
HEIRS OF DAVID DUNN
COAL
SALTSBURG COAL MINING CO.

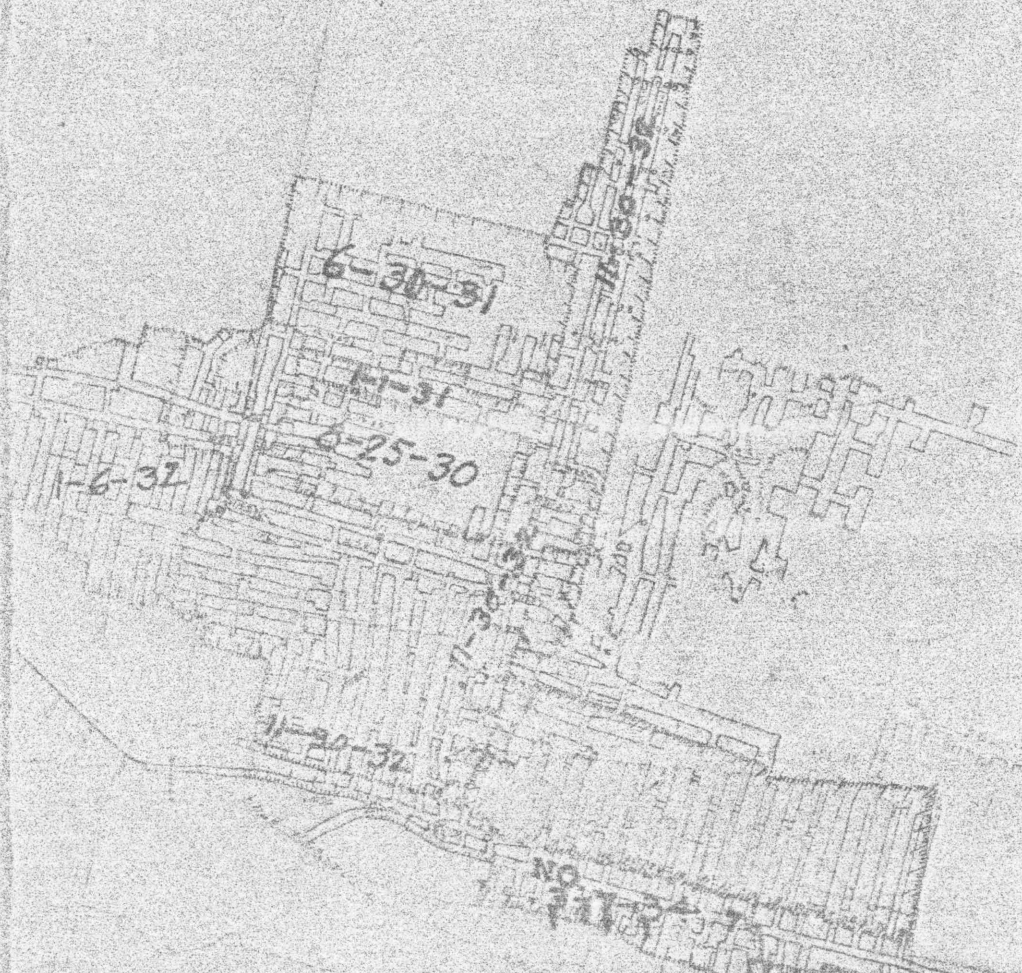

N M & D
G E - 8322 A C R E S
A L - 4324 A C R E S

U. S. H. N. M. A. R. T. Z.
