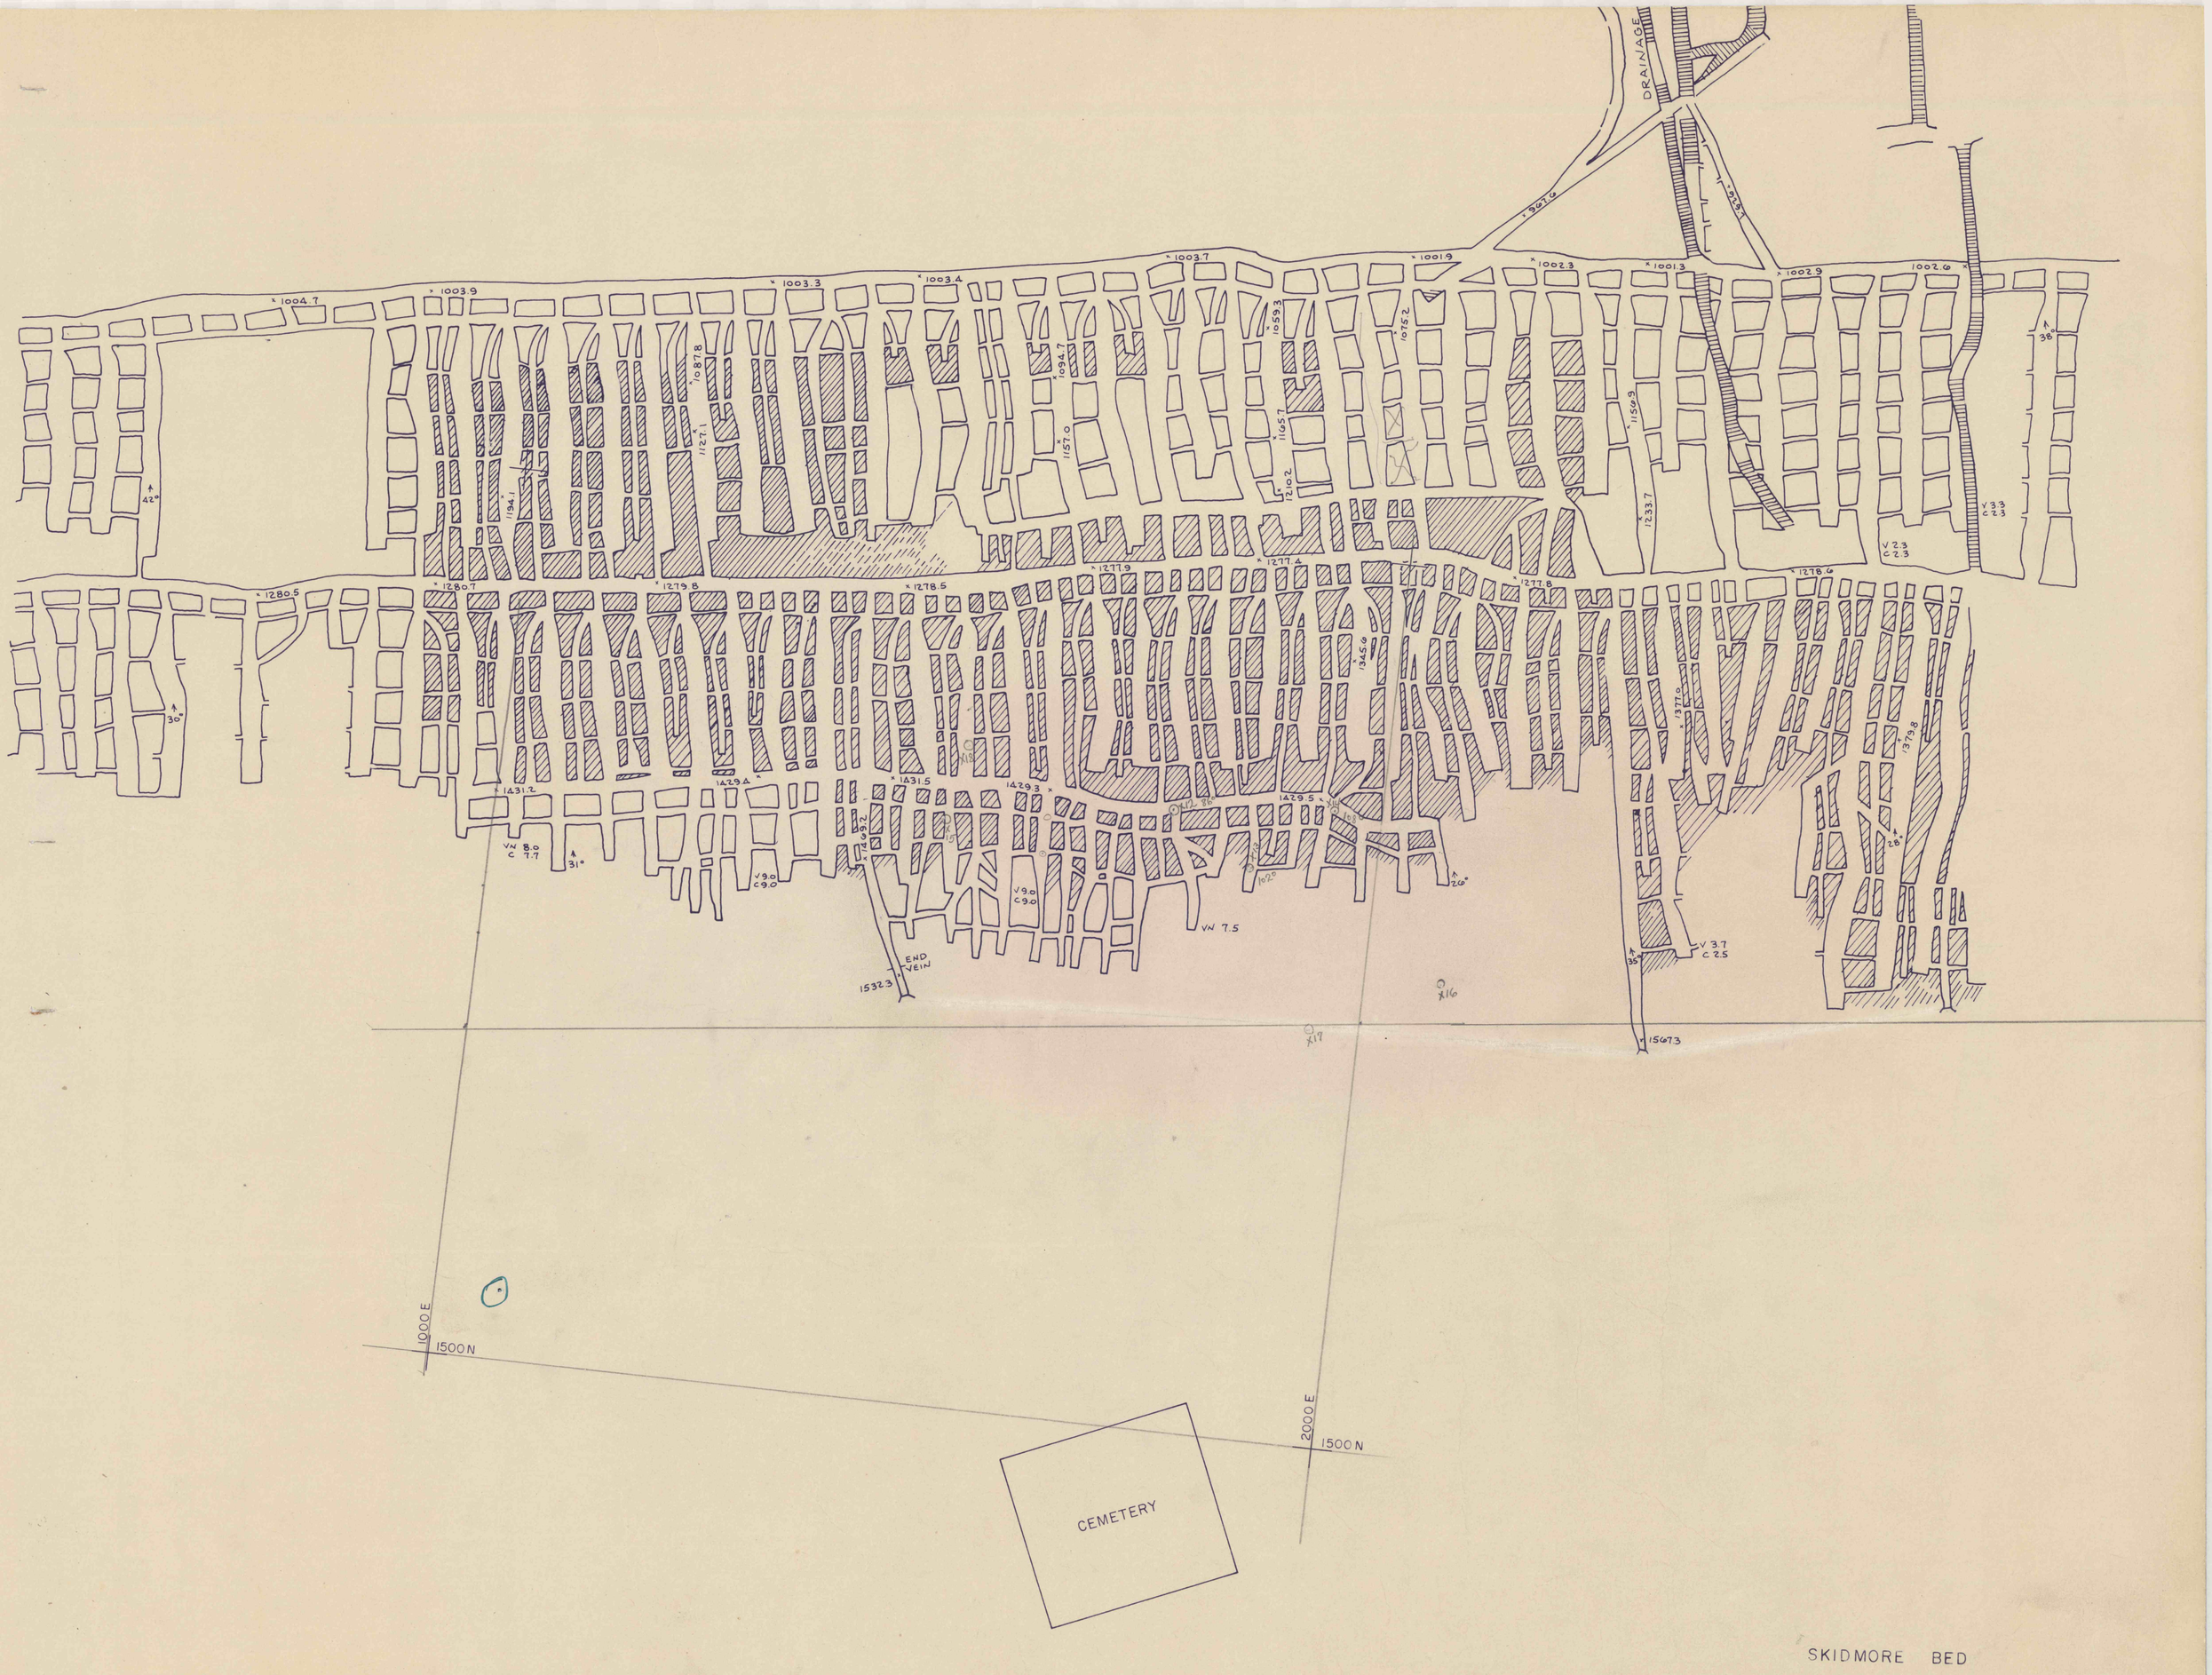
DRAINAGE
1004.7
1003.9
1003.3
1003.4
1003.7
1001.9
1002.3
1001.3
1002.9
1002.6
1280.5
1280.7
1279.8
1278.5
1277.9
1277.4
1277.8
1278.6
1431.2
1429.4
1431.5
1429.3
1429.5
1532.3
END VEIN
1567.3
1000 E
1500 N
2000 E
1500 N
CEMETERY
SKIDMORE BED