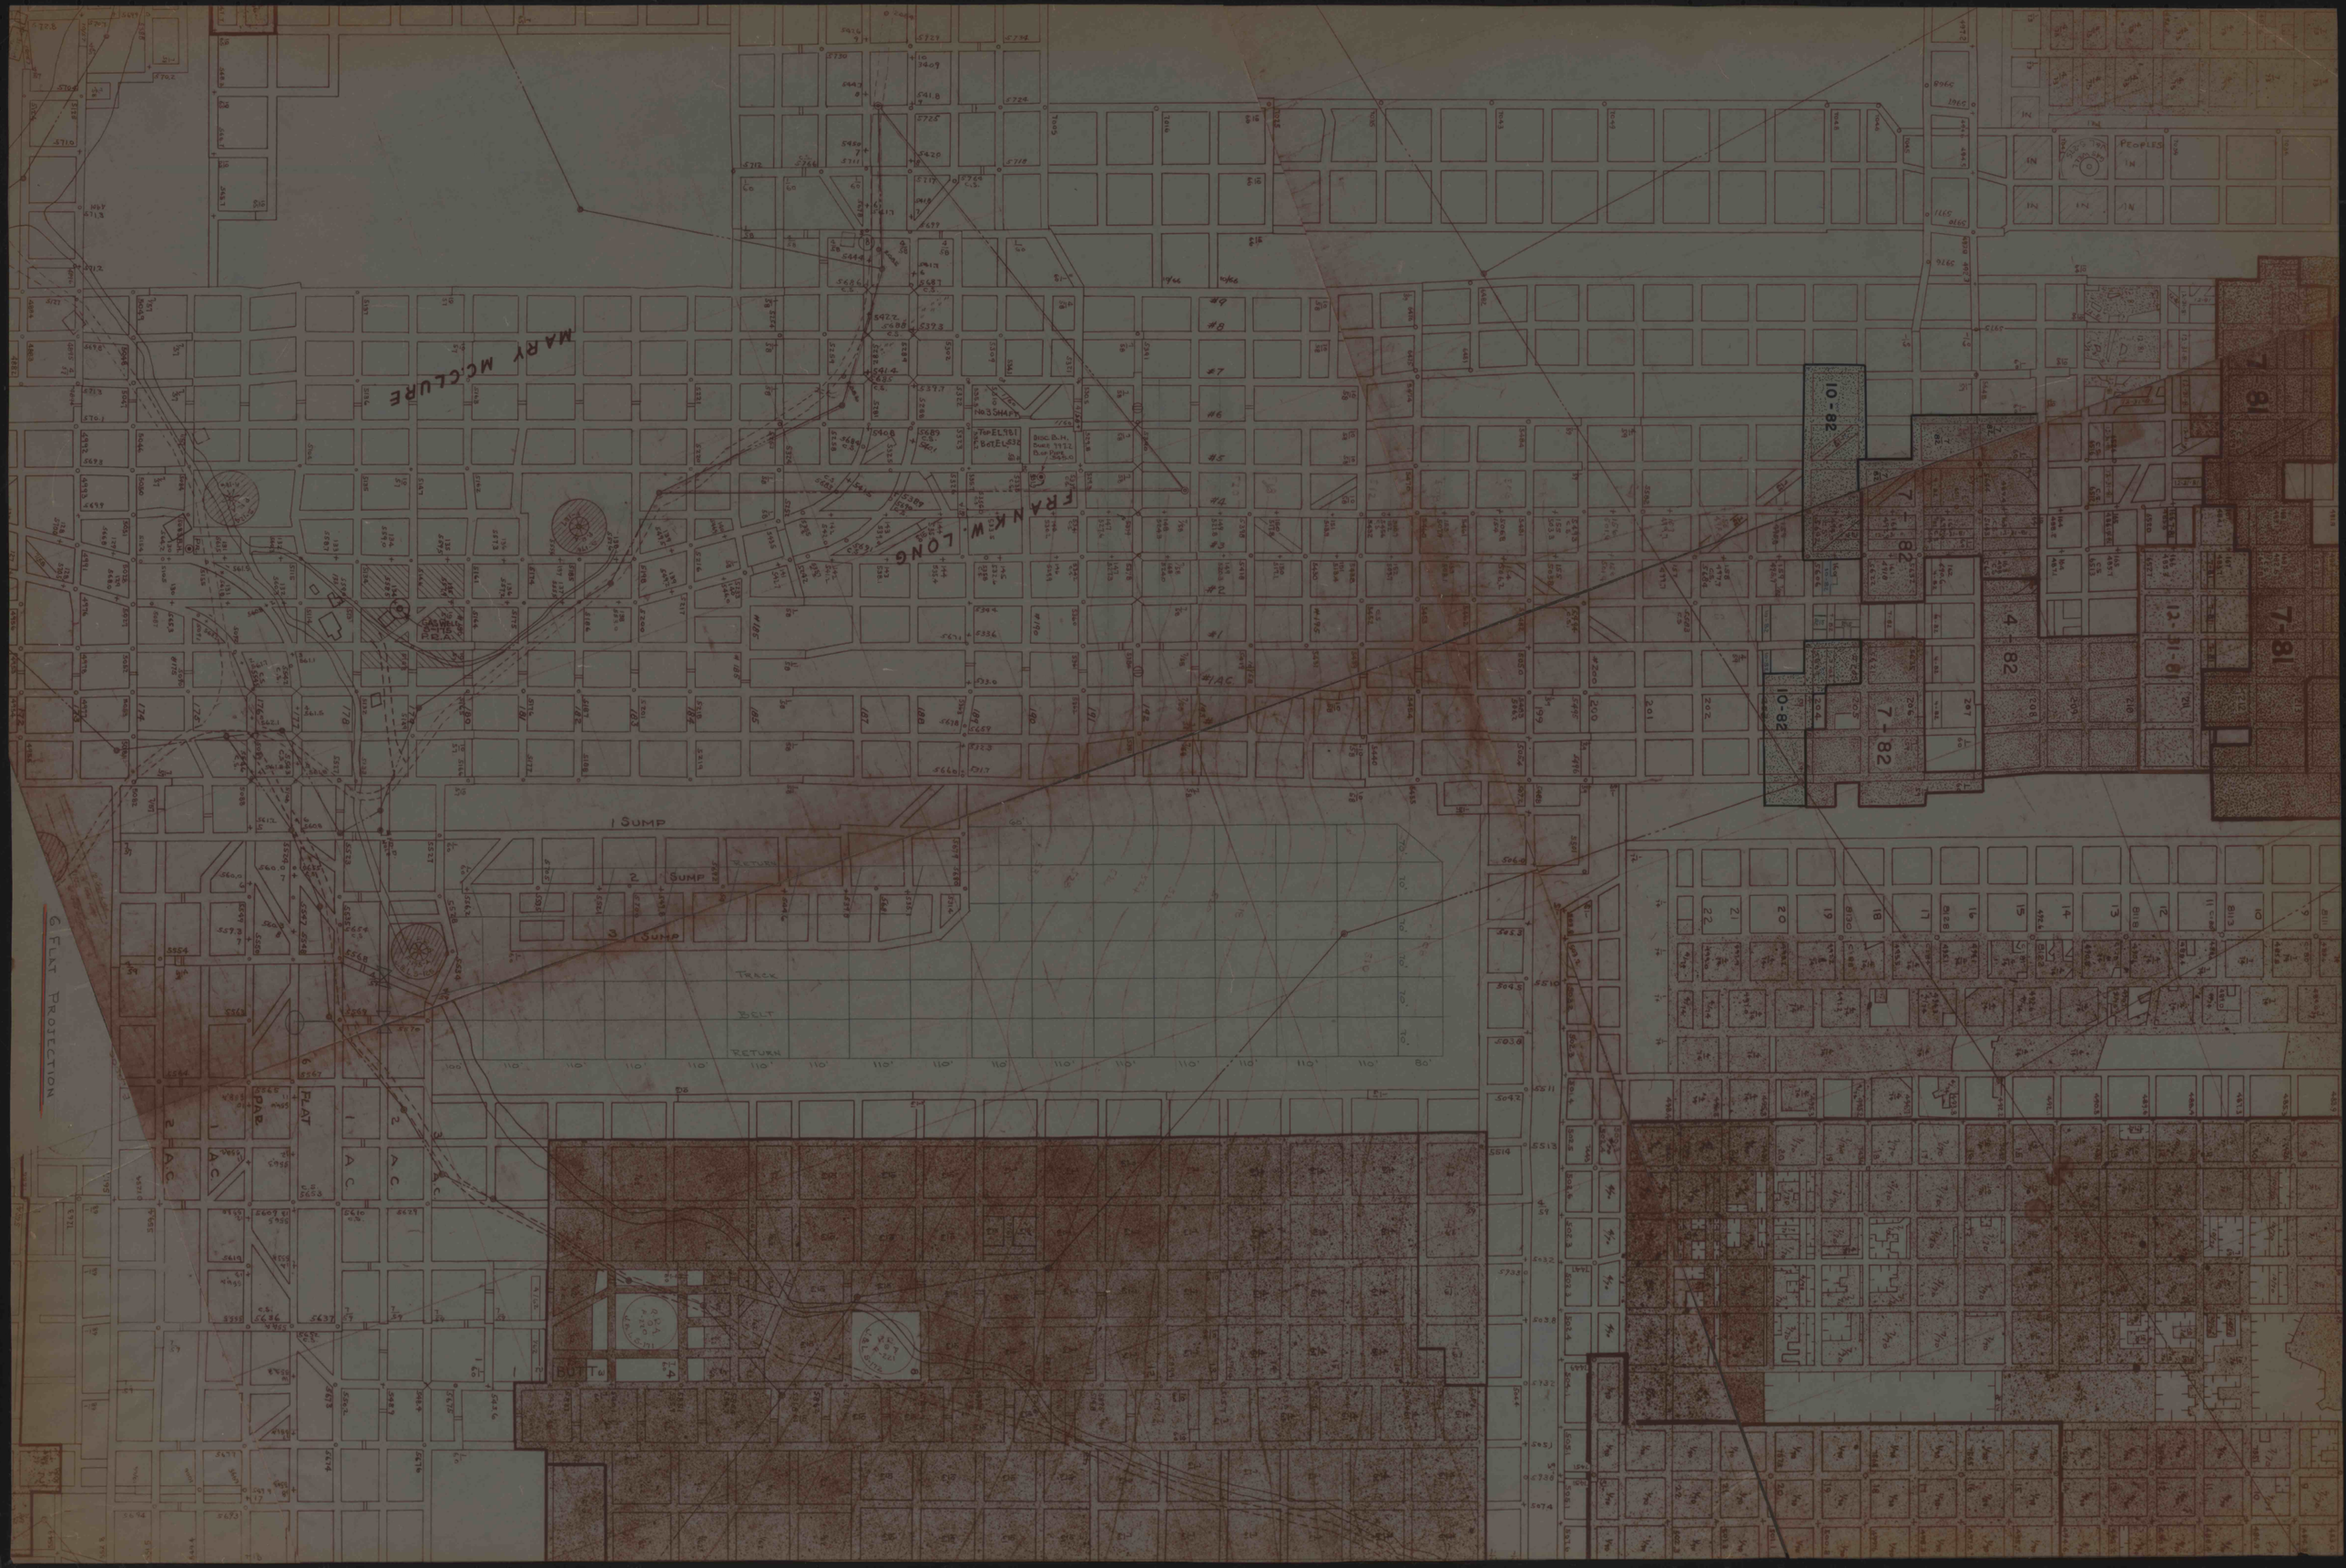
MARY MCCLURE
FRANK W. LONG
#3 SUMP
TOP EL 981
BOT EL 932
1 SUMP
2 SUMP
3 SUMP
RETURN
TRACK
BELT
RETURN
6 FLAT PROTECTION
FLAT
PAT.
10-82
7-82
4-82
12-81-6
7-81