


Sec #2  
210

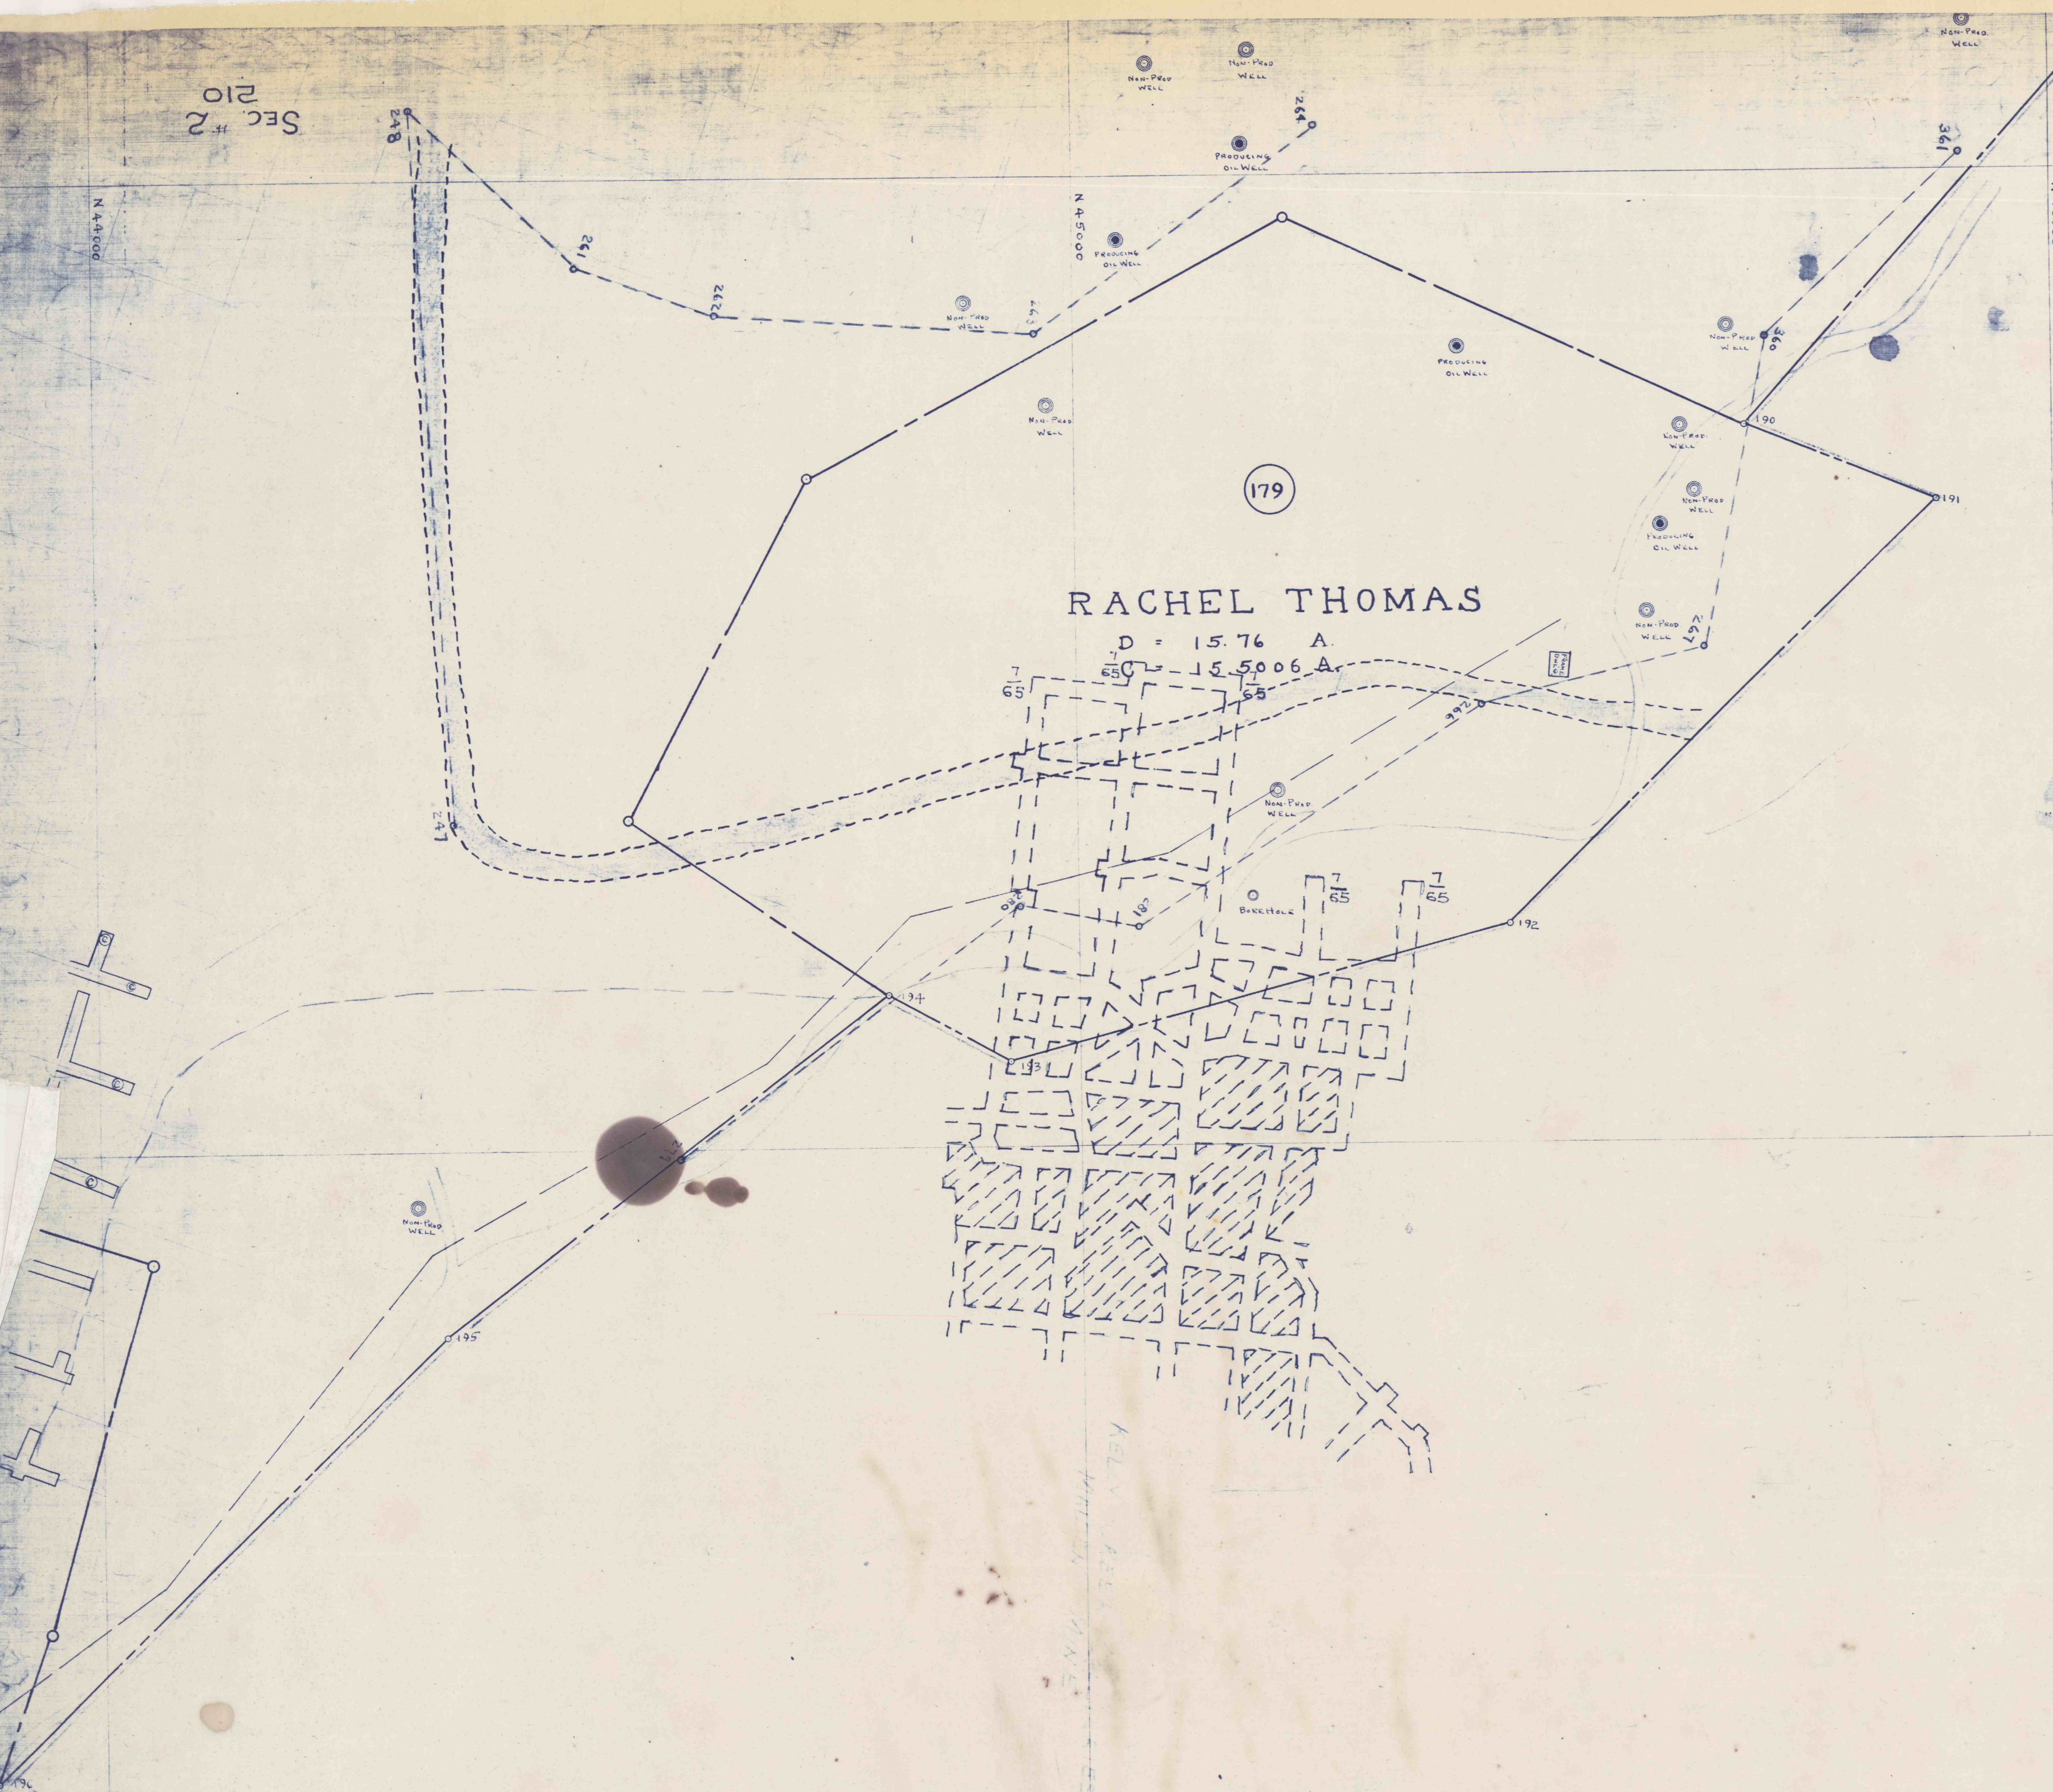

RACHEL THOMAS

D = 15.76 A  
C = 15.5006 A

SEC #2  
210