

ORIGINAL LOCATION OF CROP FIRE, BROUGHT TO ATTENTION OF BUREAU 1947

NO EVIDENCE OF FIRE IN THIS AREA  
BENNETT MINE ABANDONED

W.B. CARR

DIRECTION FIRE IS TRAVELING

APPROXIMATE LOCATION OF HOLES DRILLED BY BUREAU - APPROX. 200 HOLES

PRESENT LOCATION OF FIRE IS IN GRID OF DRILL HOLES

LATROBE COAL CO.

HEIRS  
M'BRIDE

FURNACE SHAFT  
6" HOLE IN SEAL  
USE RESERVED IN SALE OF SURFACE  
FROM JOHN KROME  
SALE 5-29-42  
Use of Ass. Surface Sold to  
Jacob Green  
6-11-1918

MAXIMUM WATER LEVEL ELEV. 1000'  
MINIMUM WATER LEVEL ELEV. 990'


LATROBE COAL CO. OPENING SEALED BY BUREAU OF MINES

ESTIMATE LOCATION OF WATER SEAL ELEV. 975'

OPENING SEALED BY BUREAU OF MINES

ROCK SLOPE SEALED

2

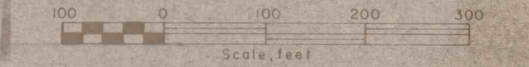

MONASTERY MINE

PRINT SHOWING APPROXIMATE LOCATION OF MINE FIRE OUTLINED YELLOW - U.S. STEEL COAL

UNLEY TWP.  
SCALE 1" = 100'

WESTMORELAND CO., PA.  
JAN. 23, 1957