


N 39000

N 40000

N 41000

N 42000

PAR 9 FLAT

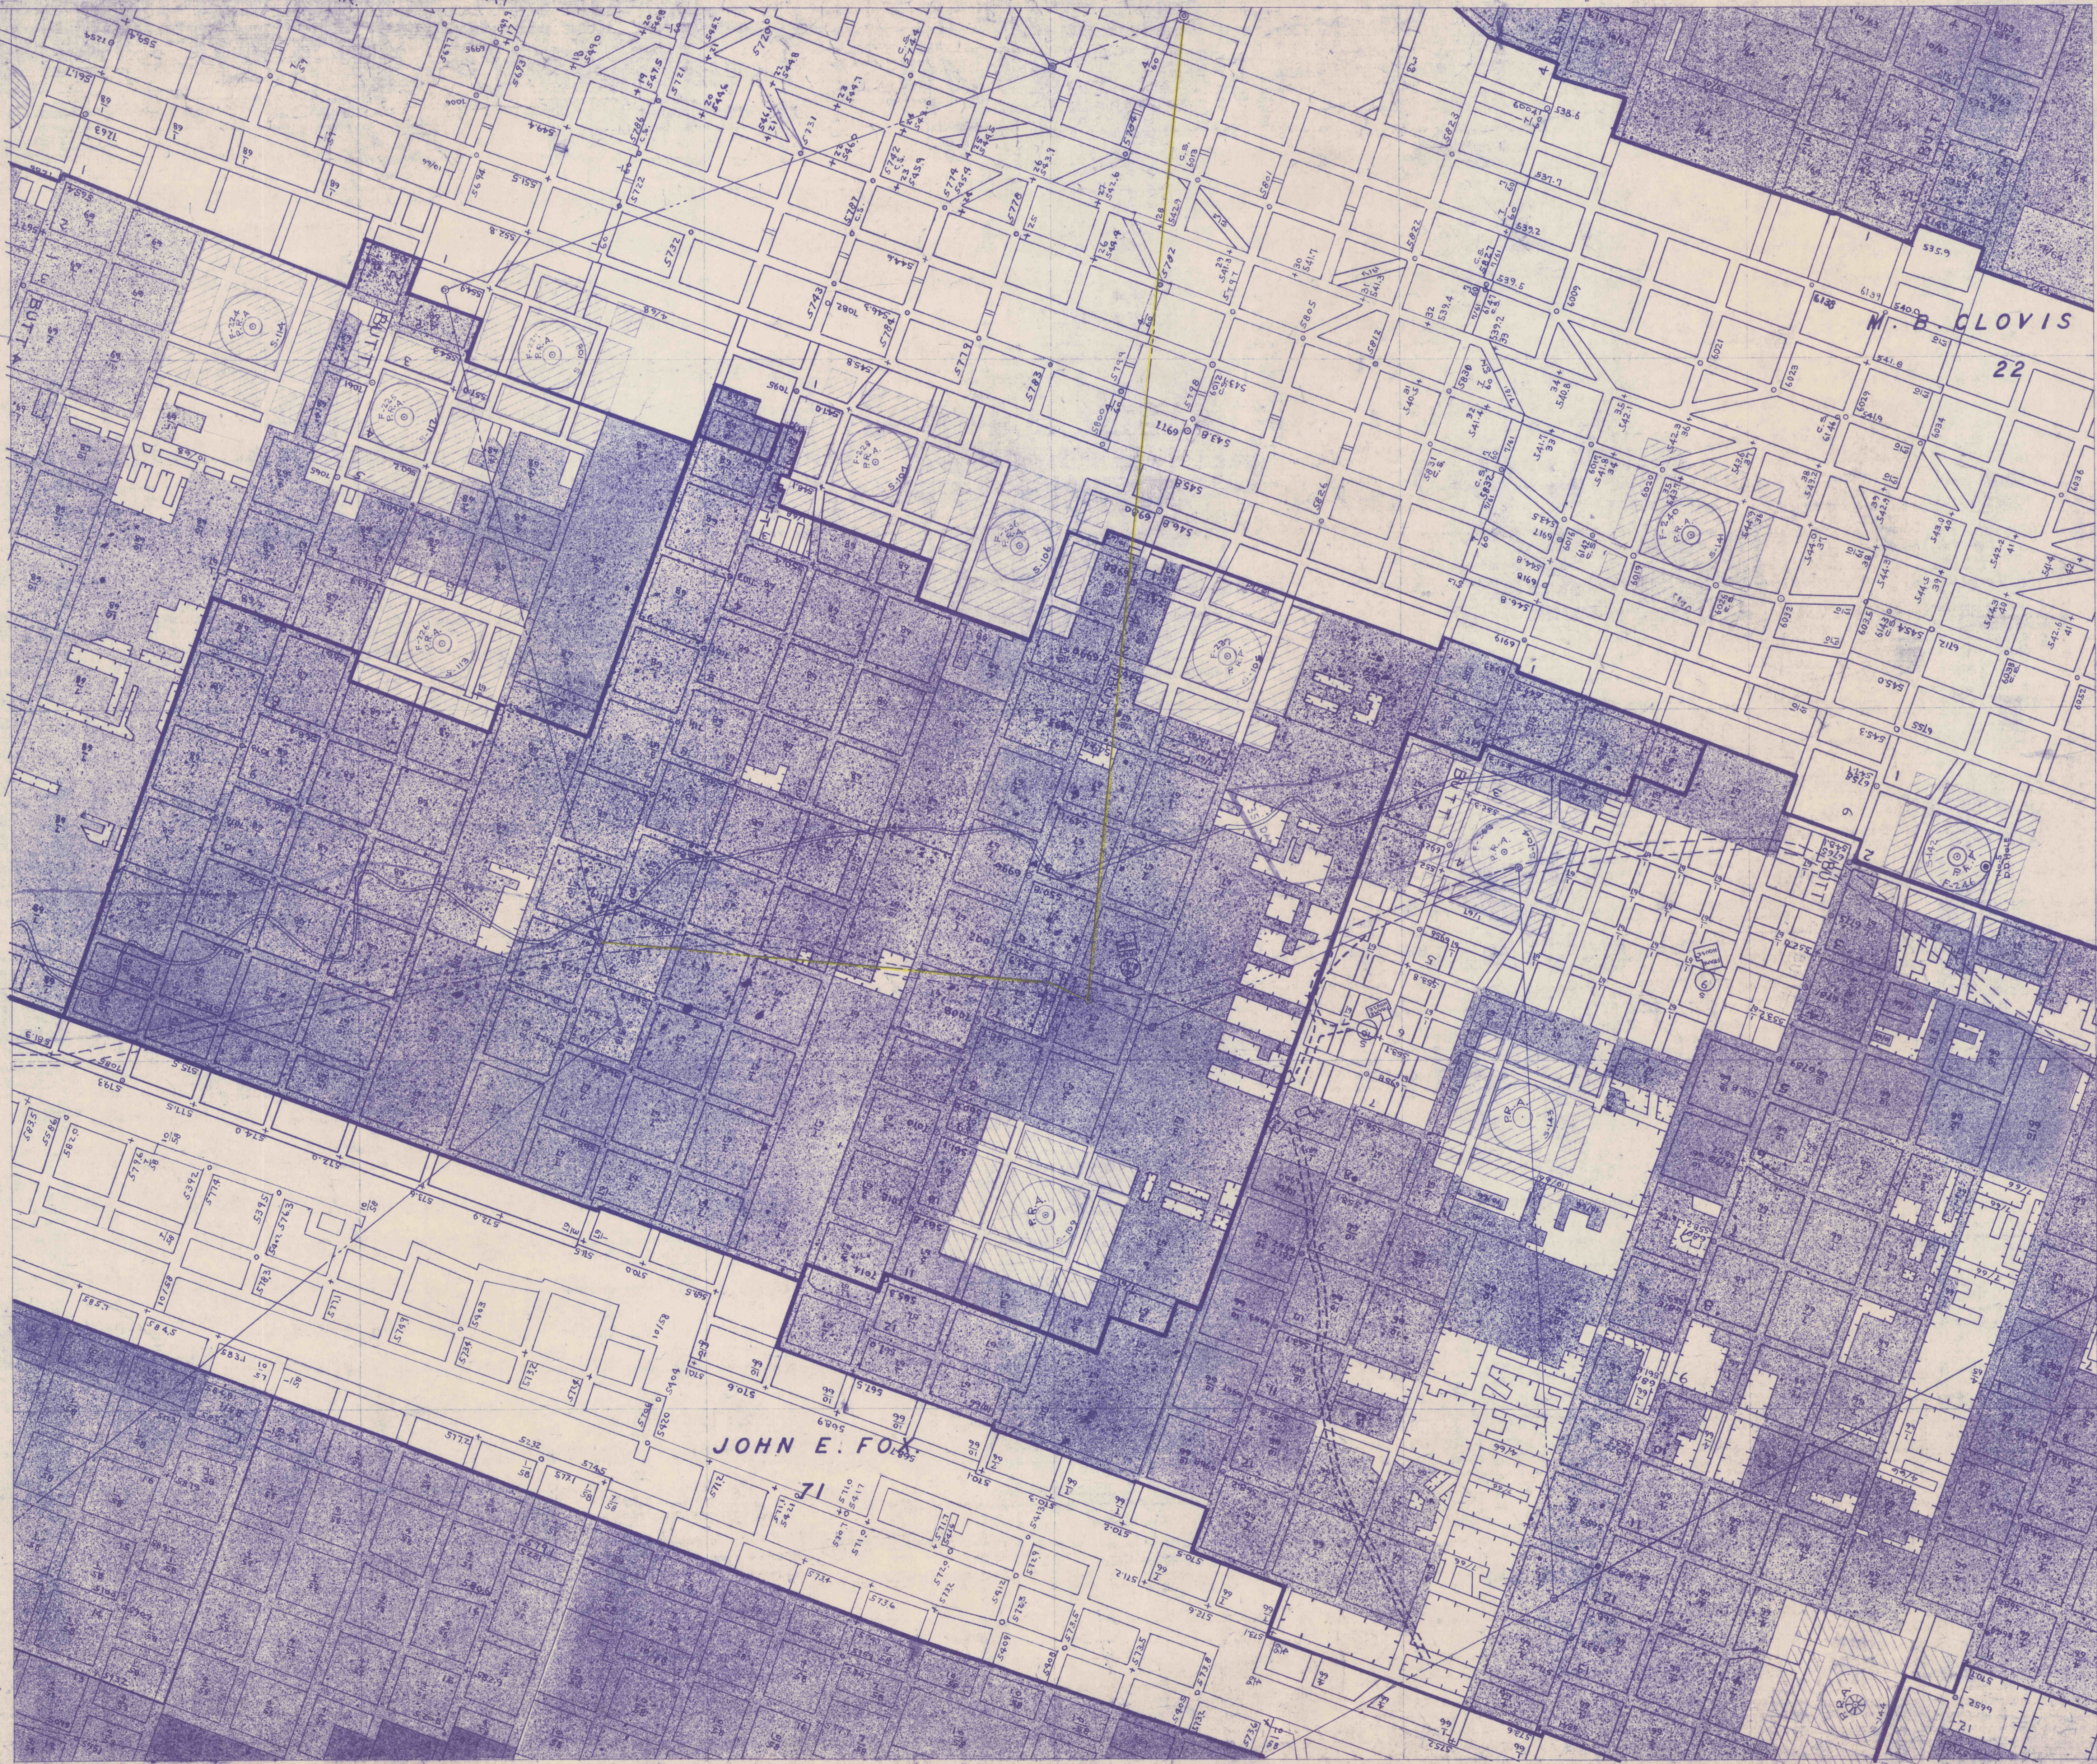

E 21000

E 22000