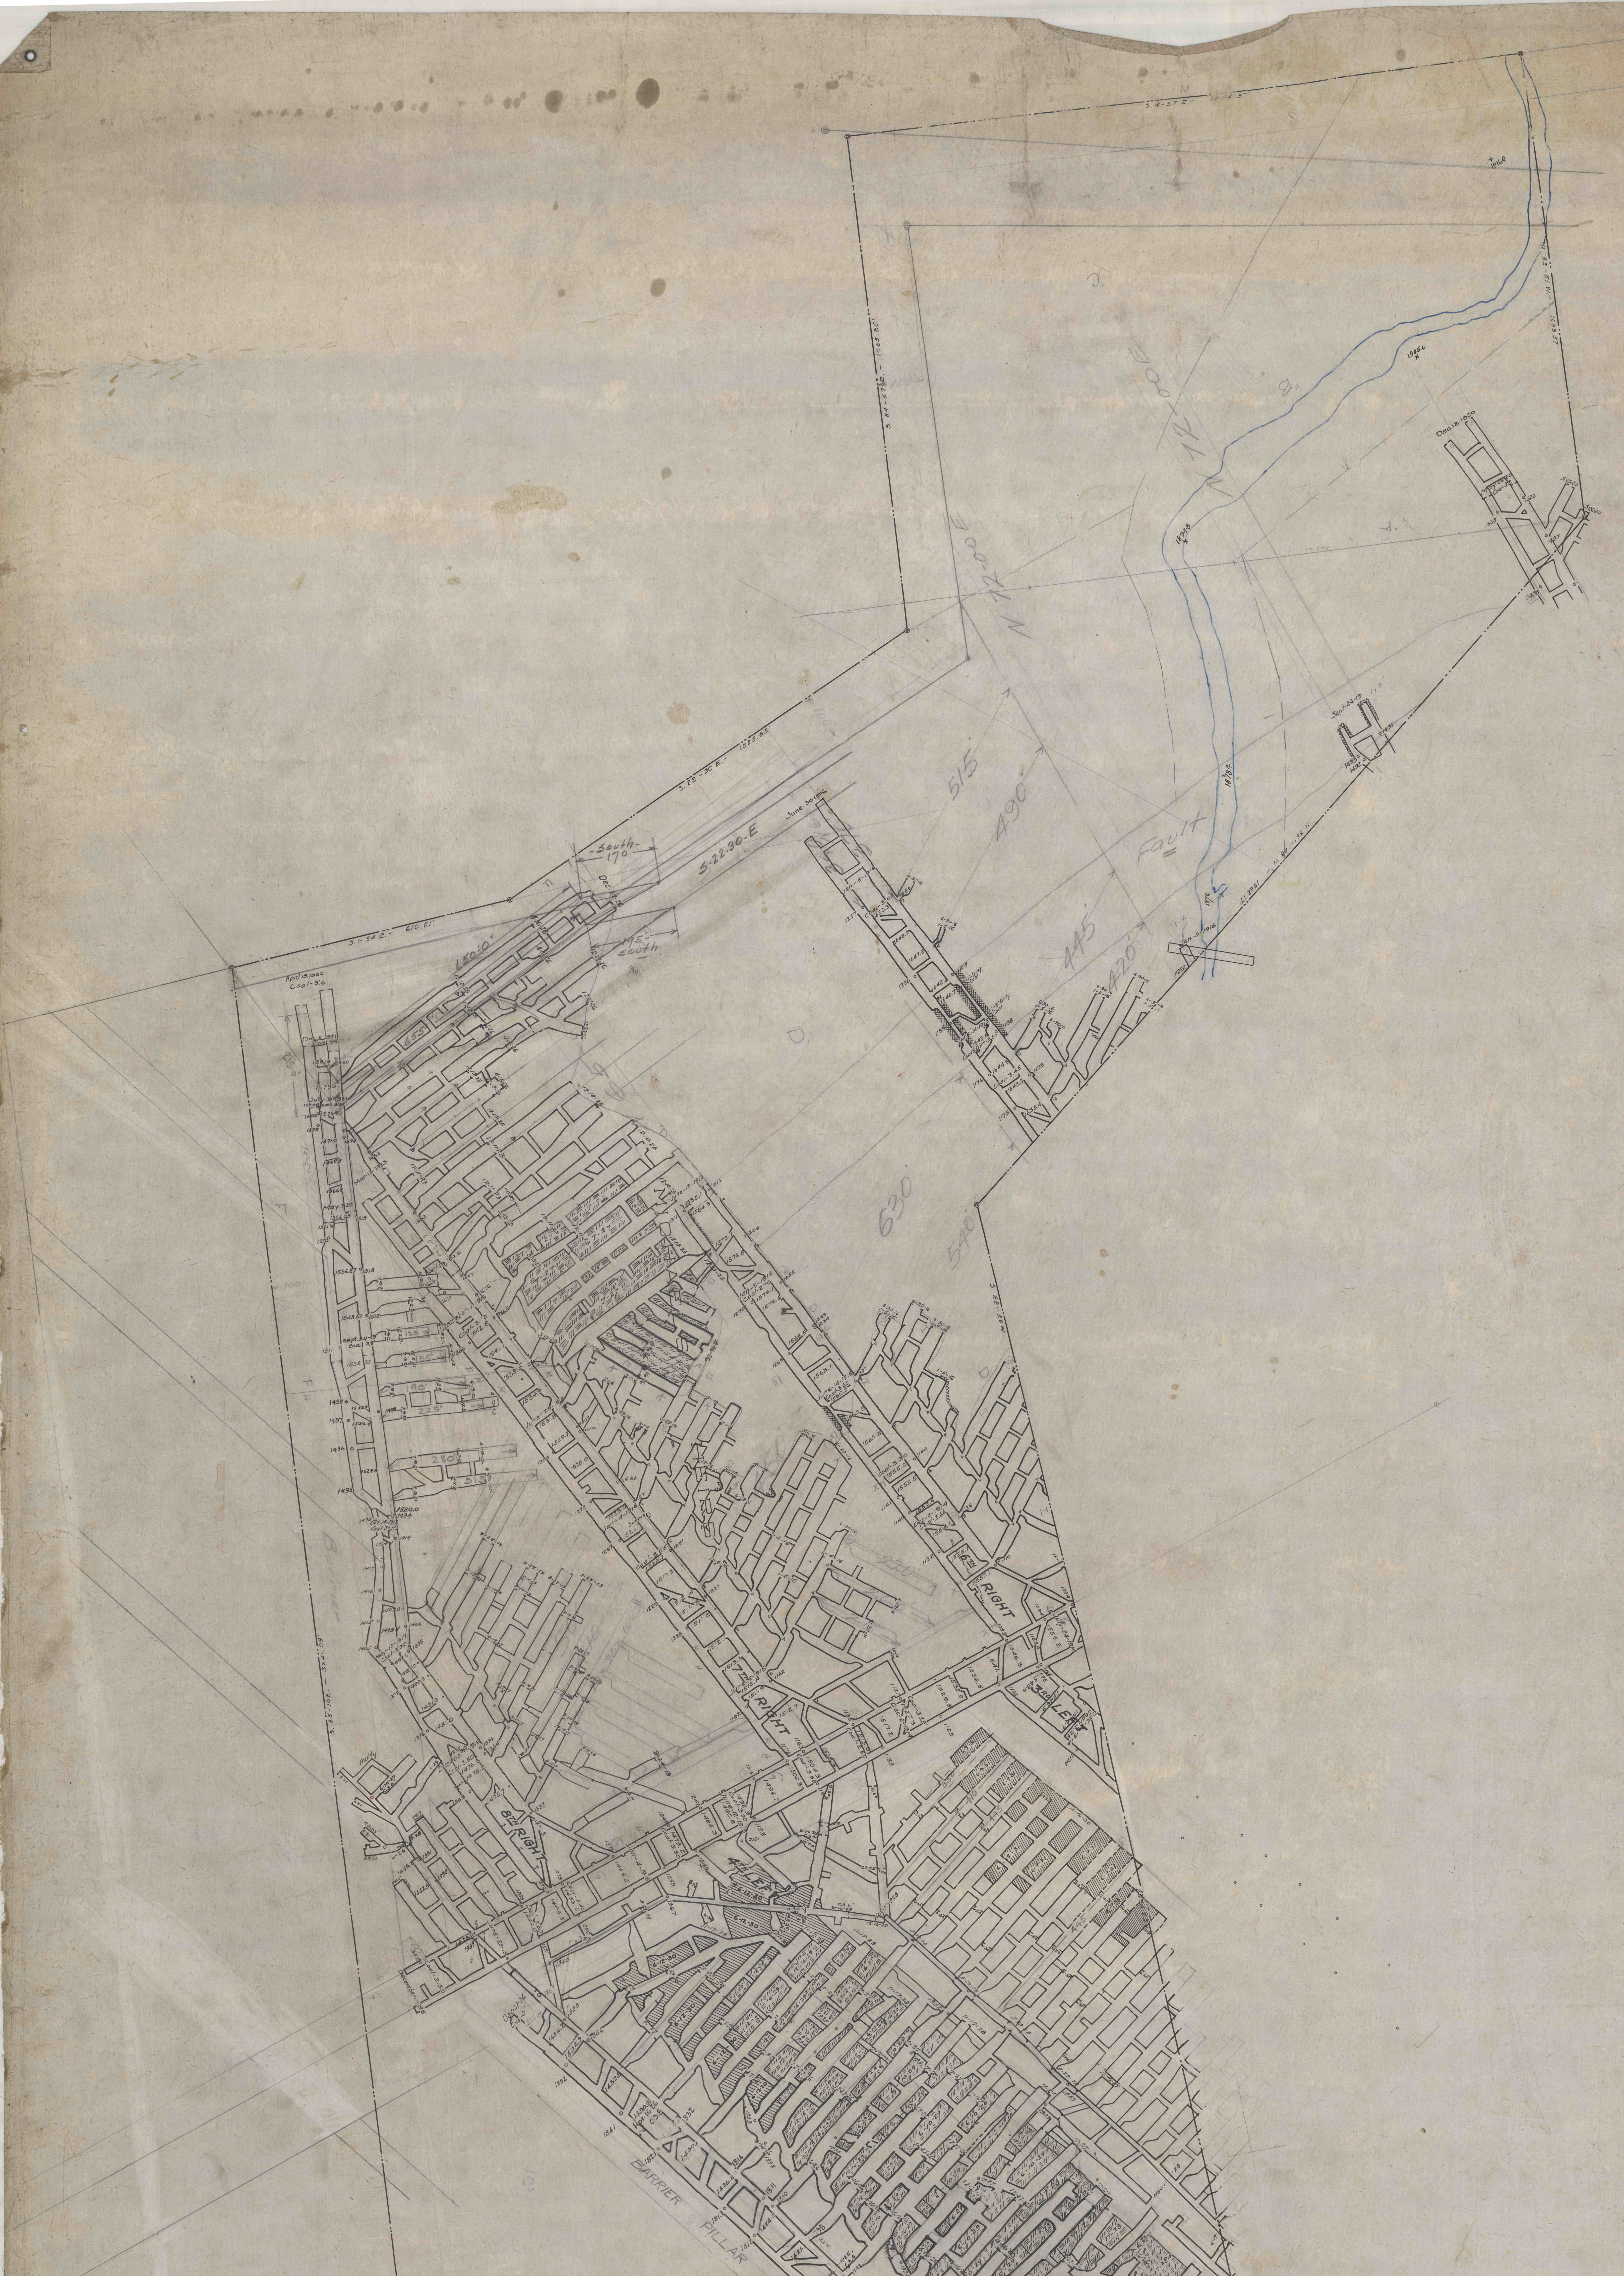
M
S. 4-57 E. - 1264.57'
S. 84-57 E. - 1065.80'
N. 85-51 W. - 1003.57'
S. 22-30 E. - 1025.85'
S. 1-54 E. - 610.01'
S. 85-10 E. - 3241.09'
N. 2-54 E. - 1790.36'
N. 36-48 W. - 1961.17'
S. 88-26 W.
N 72-00 E
N 72-00 E
B
A
D
F
F H
Fault
515
490'
445
420'
630
540'
-South- 170
195- south
S-22-30-E
650'0"
655
June-30-1916
Dec-28-26
April 19.1922 Coal-3'6
Dec-2-1921 Coal 3'5
July-9-1921 Coal-3.0
May-7-20
Sept-24-19 Coal 3.8
Oct-19-1917 Coal 3'10
May-10-1917 Coal-3.90
215.0'
125'
155'
190'
225'
280'
315
220'
Jan-5-1916 Coal-3.00
1'-Dirty Coal
1'-8" Dirty Coal
Dec-2-1914 Coal-3.66
June-14-1915 Coal-3.60
June-22-1916
Jan-4-1916
June-13-1916
December-1-1916 Coal-3.10
December-9-1916 Coal-3.50
June-29-1916
December-1-1916
Jan-4-1916
Faulty
Dec-18-1920
May-26-20 Coal-3.8
5-26-20
Sept-24-19
1916.0
1905.6
1894.8
1878.4
1876
8th RIGHT
7th RIGHT
6th RIGHT
3rd LEFT
4th LEFT
6-12-30
11-17-28
12-16-29
6-10-29
12-16-30
350
410
445
BARRIER PILLAR