

N 48000

N 47000


N 46000

N 45000

FIT TO 271

SHAN. SEC. 12
N 269

FIT TO 268

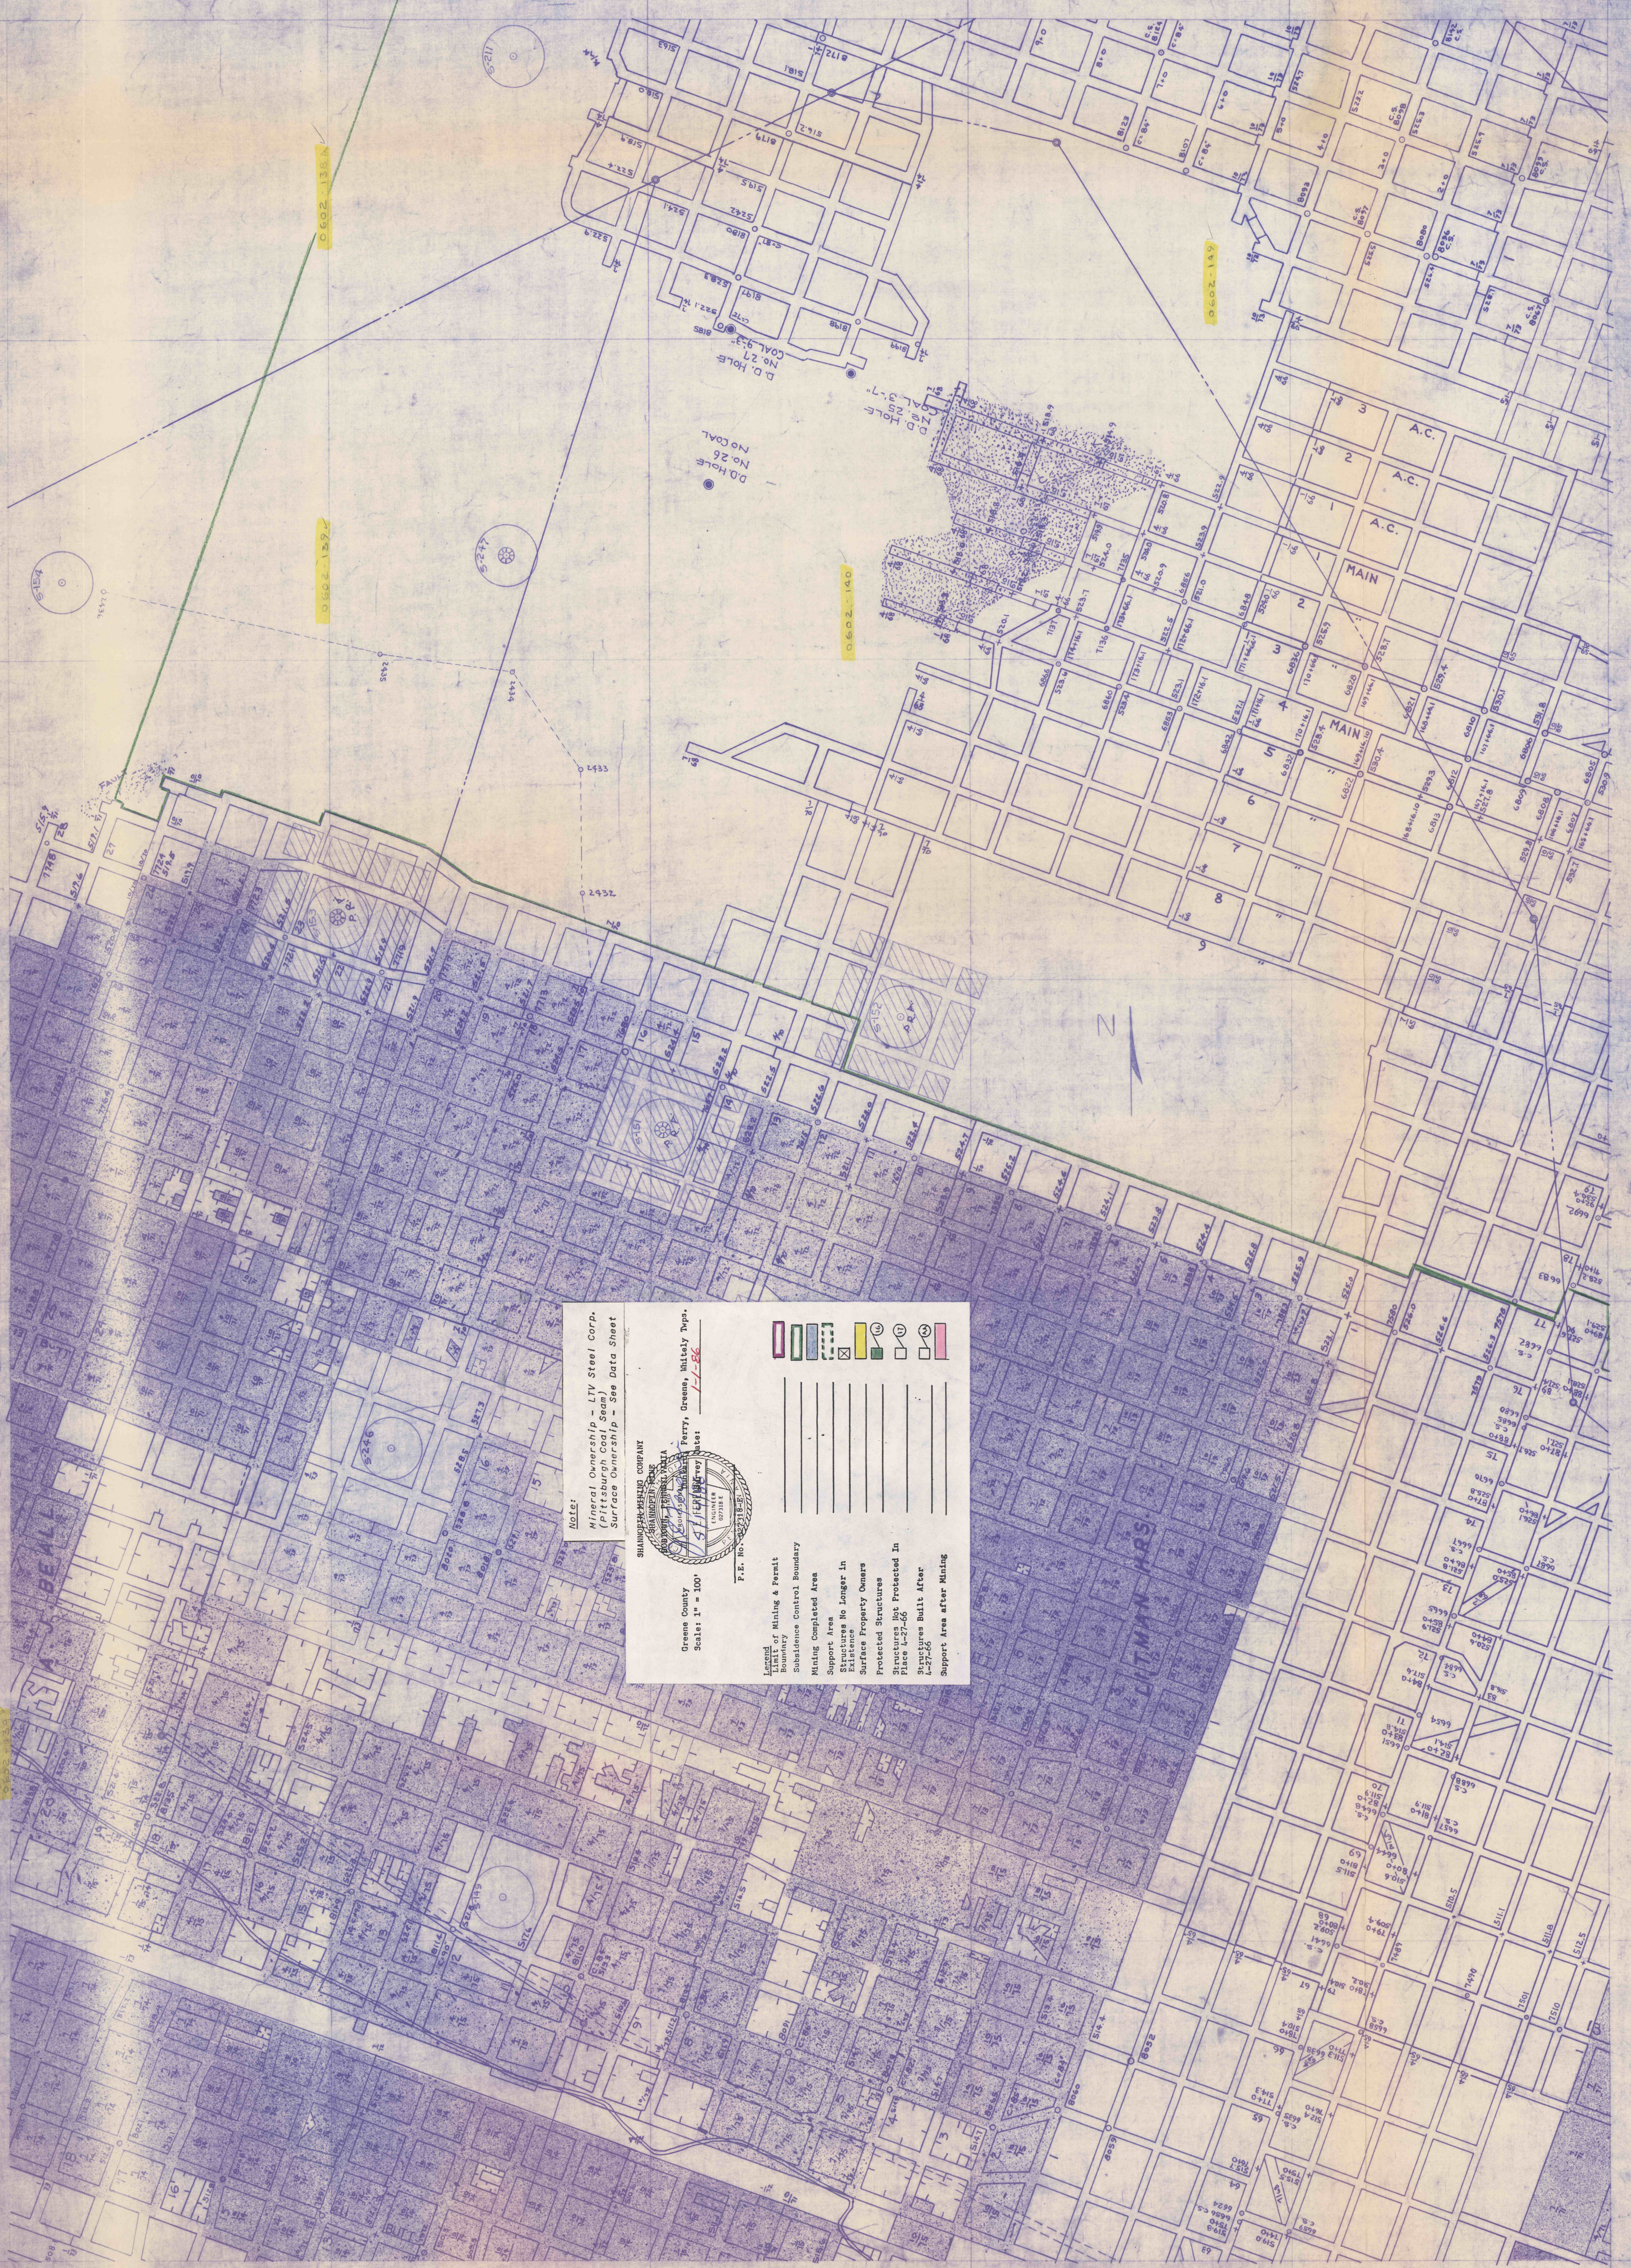

Notes:

Mineral Ownership - LTV Steel Corp.
 (Pittsburgh Coal Seam)
 Surface Ownership - See Data Sheet

GREEN COUNTY
 Scale: 1" = 100'

SHAWNEE-MERIDIAN COMPANY
 Surveyed by: *[Signature]*
 P.E. No. 2118-E

Legend:

- Mineral Ownership - LTV Steel Corp.
- Surface Ownership - See Data Sheet
- Substance Control Boundary
- Mining Completed Area
- Support Area
- Structure No Longer in Existence
- Protected Structures
- Structure Not Protected in Place 1-27-66
- Support Area after Mining

E 21000

FIT TO 251

E 20000

SHAN. SEC. 12
N 269