


Notes:
 Mineral Ownership - LTV Steel Corp.
 (Pittsburgh Coal Seam)
 Surface Ownership - See Data Sheet

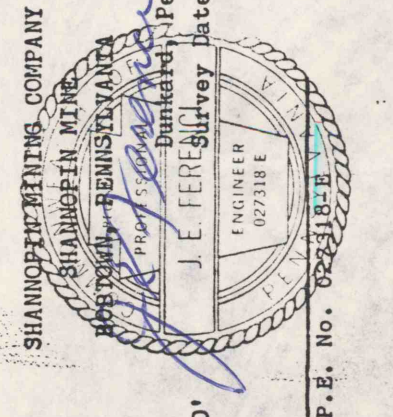


Green County
 Scale 1" = 100'

[Symbol]	Limit of Mining & Permit
[Symbol]	Subsidence Control Boundary
[Symbol]	Mining Completed Area
[Symbol]	Support Area
[Symbol]	Structures No Longer In
[Symbol]	Surface Property Owners
[Symbol]	Protected Structures
[Symbol]	Structures Not Protected In
[Symbol]	Places 1-27-68
[Symbol]	Structures Built After
[Symbol]	4-27-68
[Symbol]	Support Area after Mining

FORNIA S. MILLER
 COAL
 D-130707 A.
 C-152994 A.

DEPT. OF CONSERVATION
 SURFACE
 D-300825 A.
 C-281025 A.

SEC 2
 2005