




NOTE:
 Mineral Ownership - LTV Steel Corp.
 (Pittsburgh Coal Seam)
 Surface Ownership - See Data Sheet

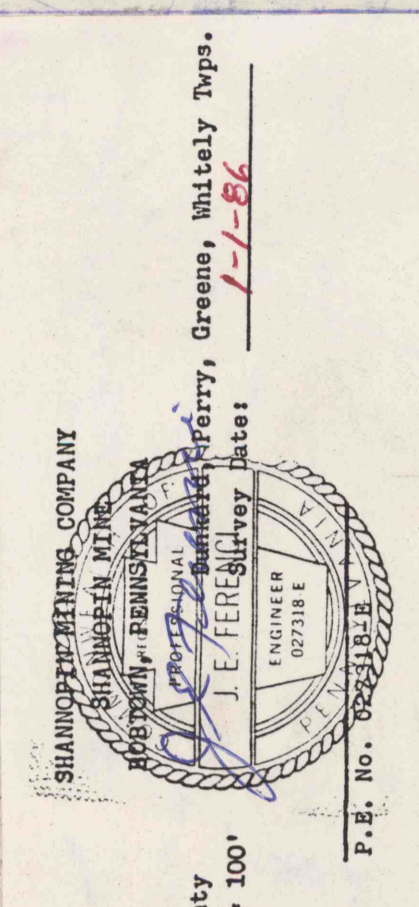

- Legend**
- Boundary of Mining & Permit
 - Subsidence Control Boundary
 - Mining Completed Area
 - Support Area
 - Structures No Longer In Existence
 - Surface Property Owners
 - Protected Structures
 - Structures Not Protected In Places 4-27-55
 - Structures Built After 5-27-55
 - Support Area after Mining

Greene County
 Scale 1" = 100'


Mineral Ownership - LTV Steel Corp.
 (Pittsburgh Coal Seam)
 Surface Ownership - See Data Sheet

0601-107A

0601-107B

0601-107C

0601-107A

0601-107B

0601-107C

