

Fit To 273

SHAN SEC. 12  
No. 272

IMRI T. SMITH

U.S.S. EX LN

0602-159


0602-162

Fit To 270


Greene County  
Scale 1" = 100'

Pat. No. 824,153




7-7-56  
Ferry, Greens, Whitely Twp.  
Shanpeters, West

	Limit of Mining & Permit
	Boundary
	Suspension Control Boundary
	Mining Completed Area
	Support Area
	Structures No Longer In
	Surface Property Owners
	Protected Structures
	Structures Not Protected In
	Places 4-27-55
	Structures Built After
	Support Area after Mining

NOTE:  
Mineral Ownership - LTV Steel Corp.  
(Pittsburgh Coal Seam)  
Surface Ownership - See Data Sheet

N

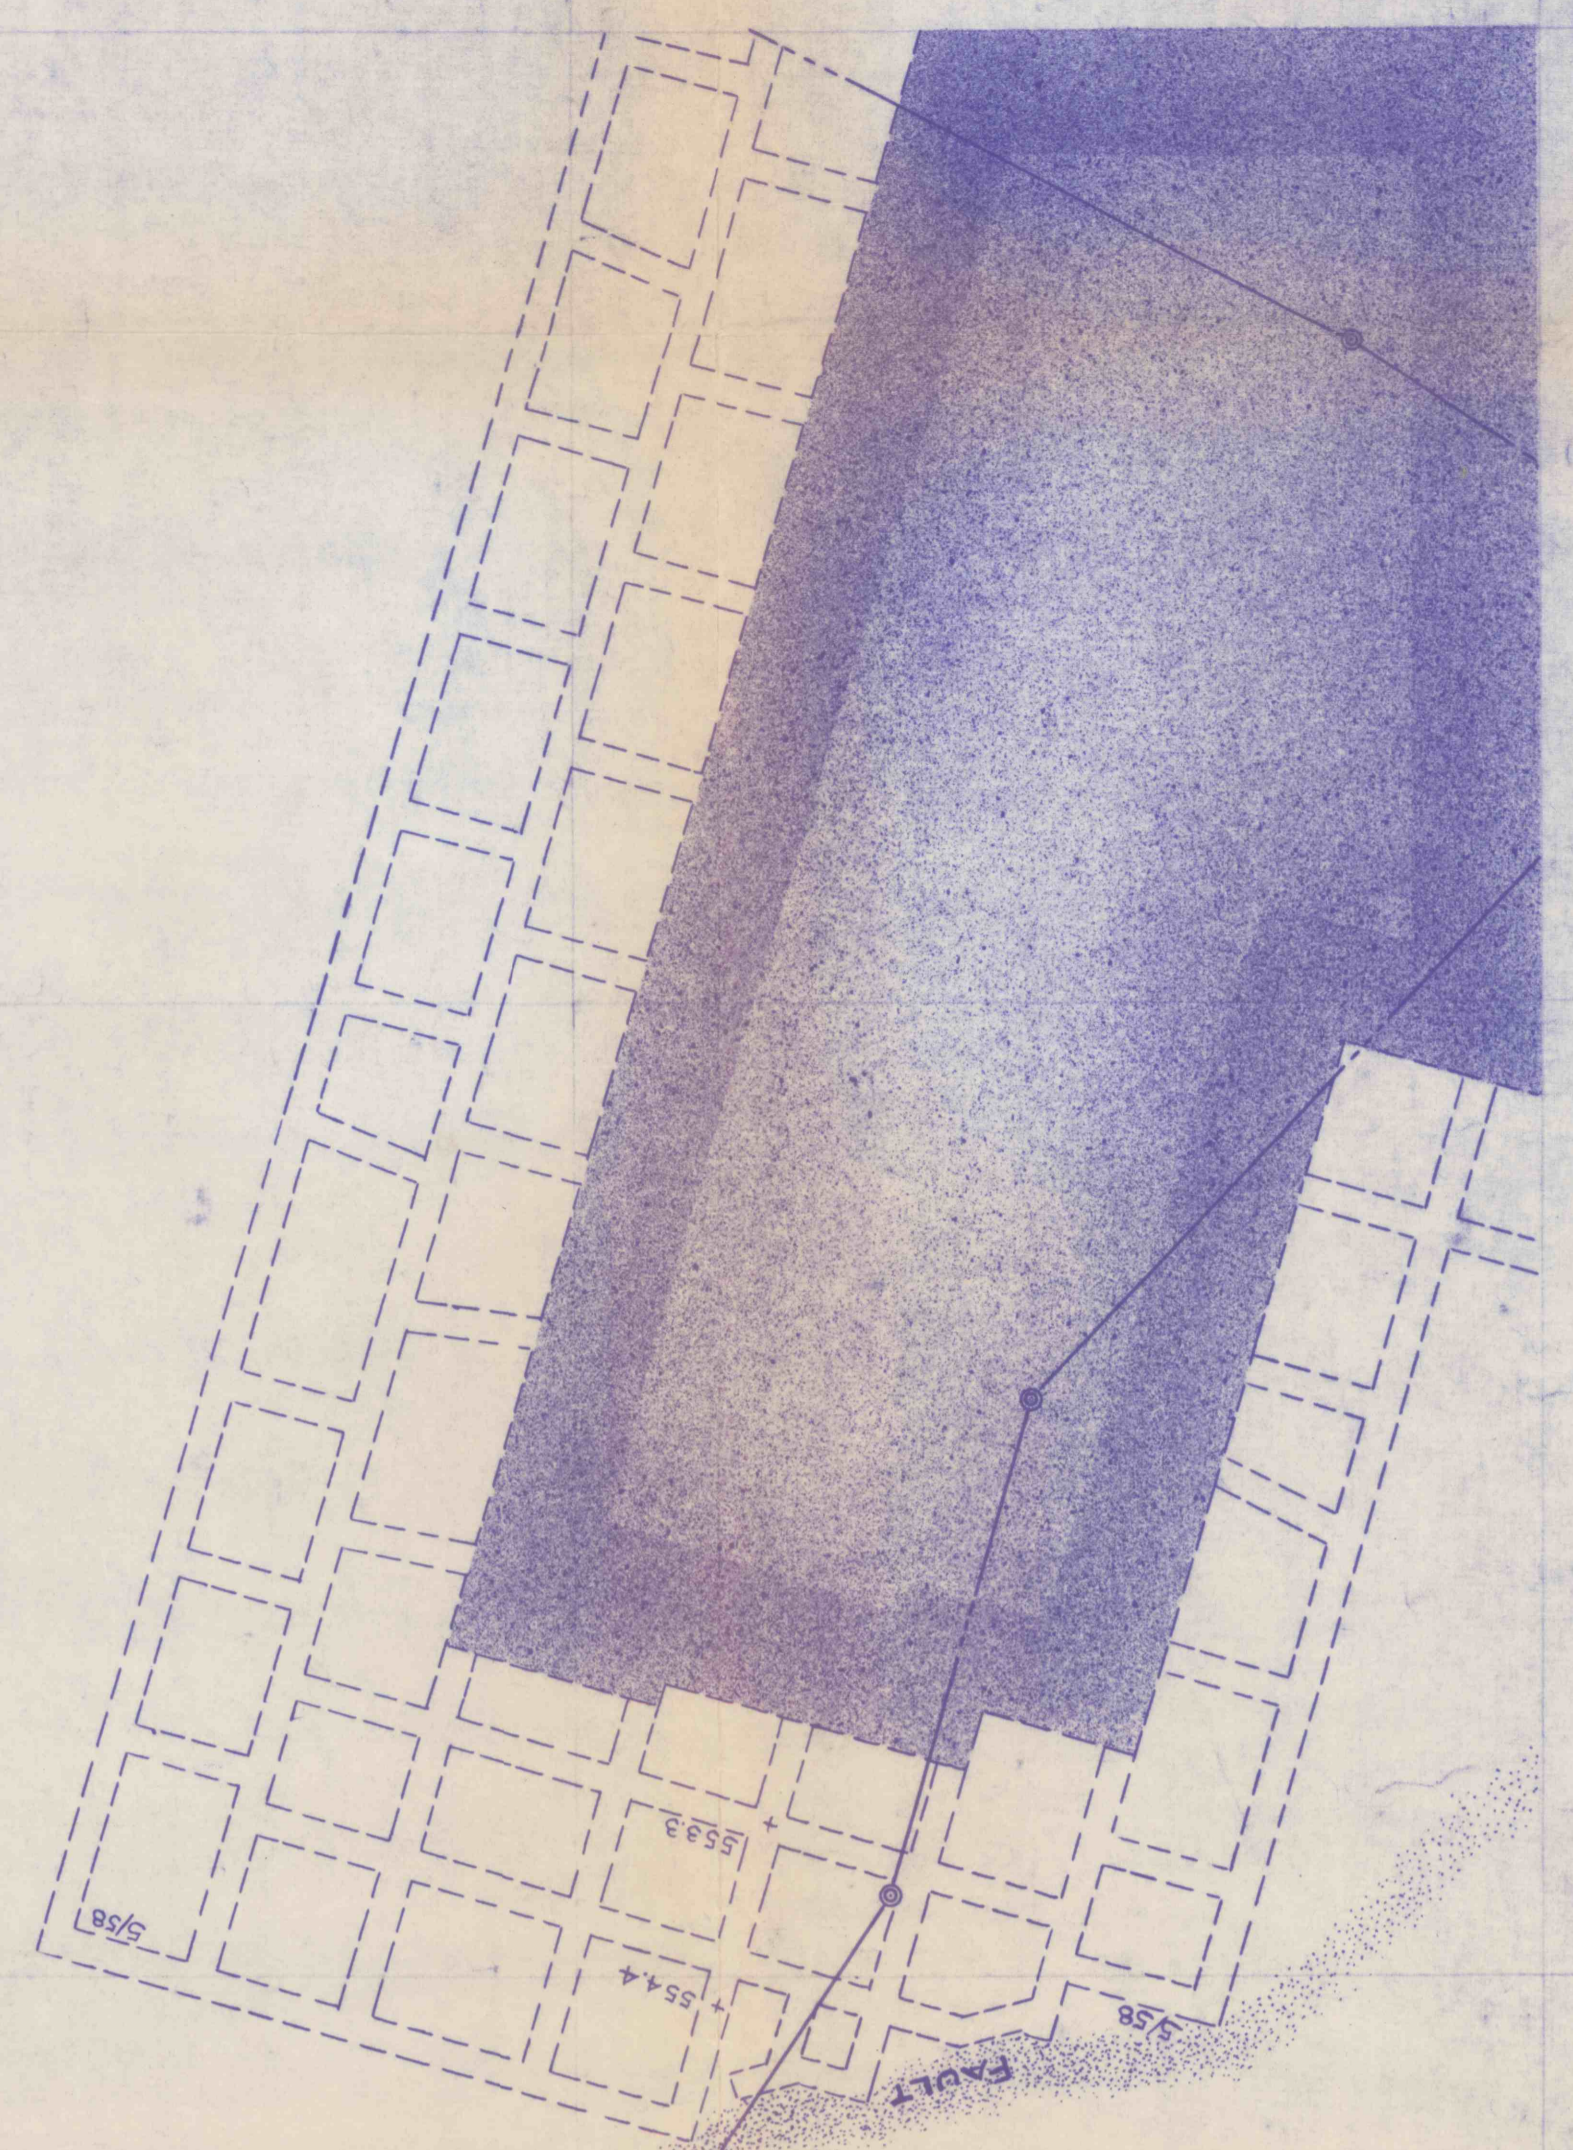

SEC. 12 272

SHAN. SEC. 12  
No. 272

N 56000

N 55000

N 54000

N 53000

E 23000

E 24000

E 25000