


NOTES:
Mineral Ownership - LTV Steel Corp.
(Pittsburgh Coal Seab)
Surface Ownership - See Data Sheet

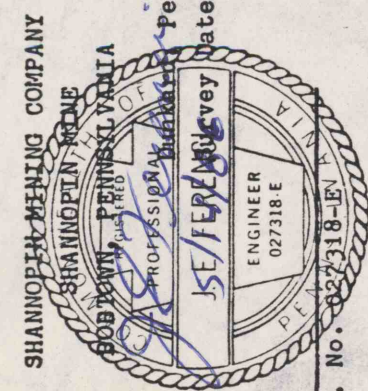

Greene County
Scale 1" = 100'

Legend	
Limit of Mining & Permit	
Boundary	
Subsidence Control Boundary	
Mining Completed Area	
Support Area	
Structures No Longer in	
Surface Property Owners	
Protected Structures	
Structures Not Protected In	
Place L-27-55	
Structures Built After	
L-27-55	
Support Area after Mining	

CHARLES SHEETS

LYNCH

SUR 1040
COAL STO.
COVER 320.