


SHAN. SEC. 13
No. 278

F.I.T. To 279

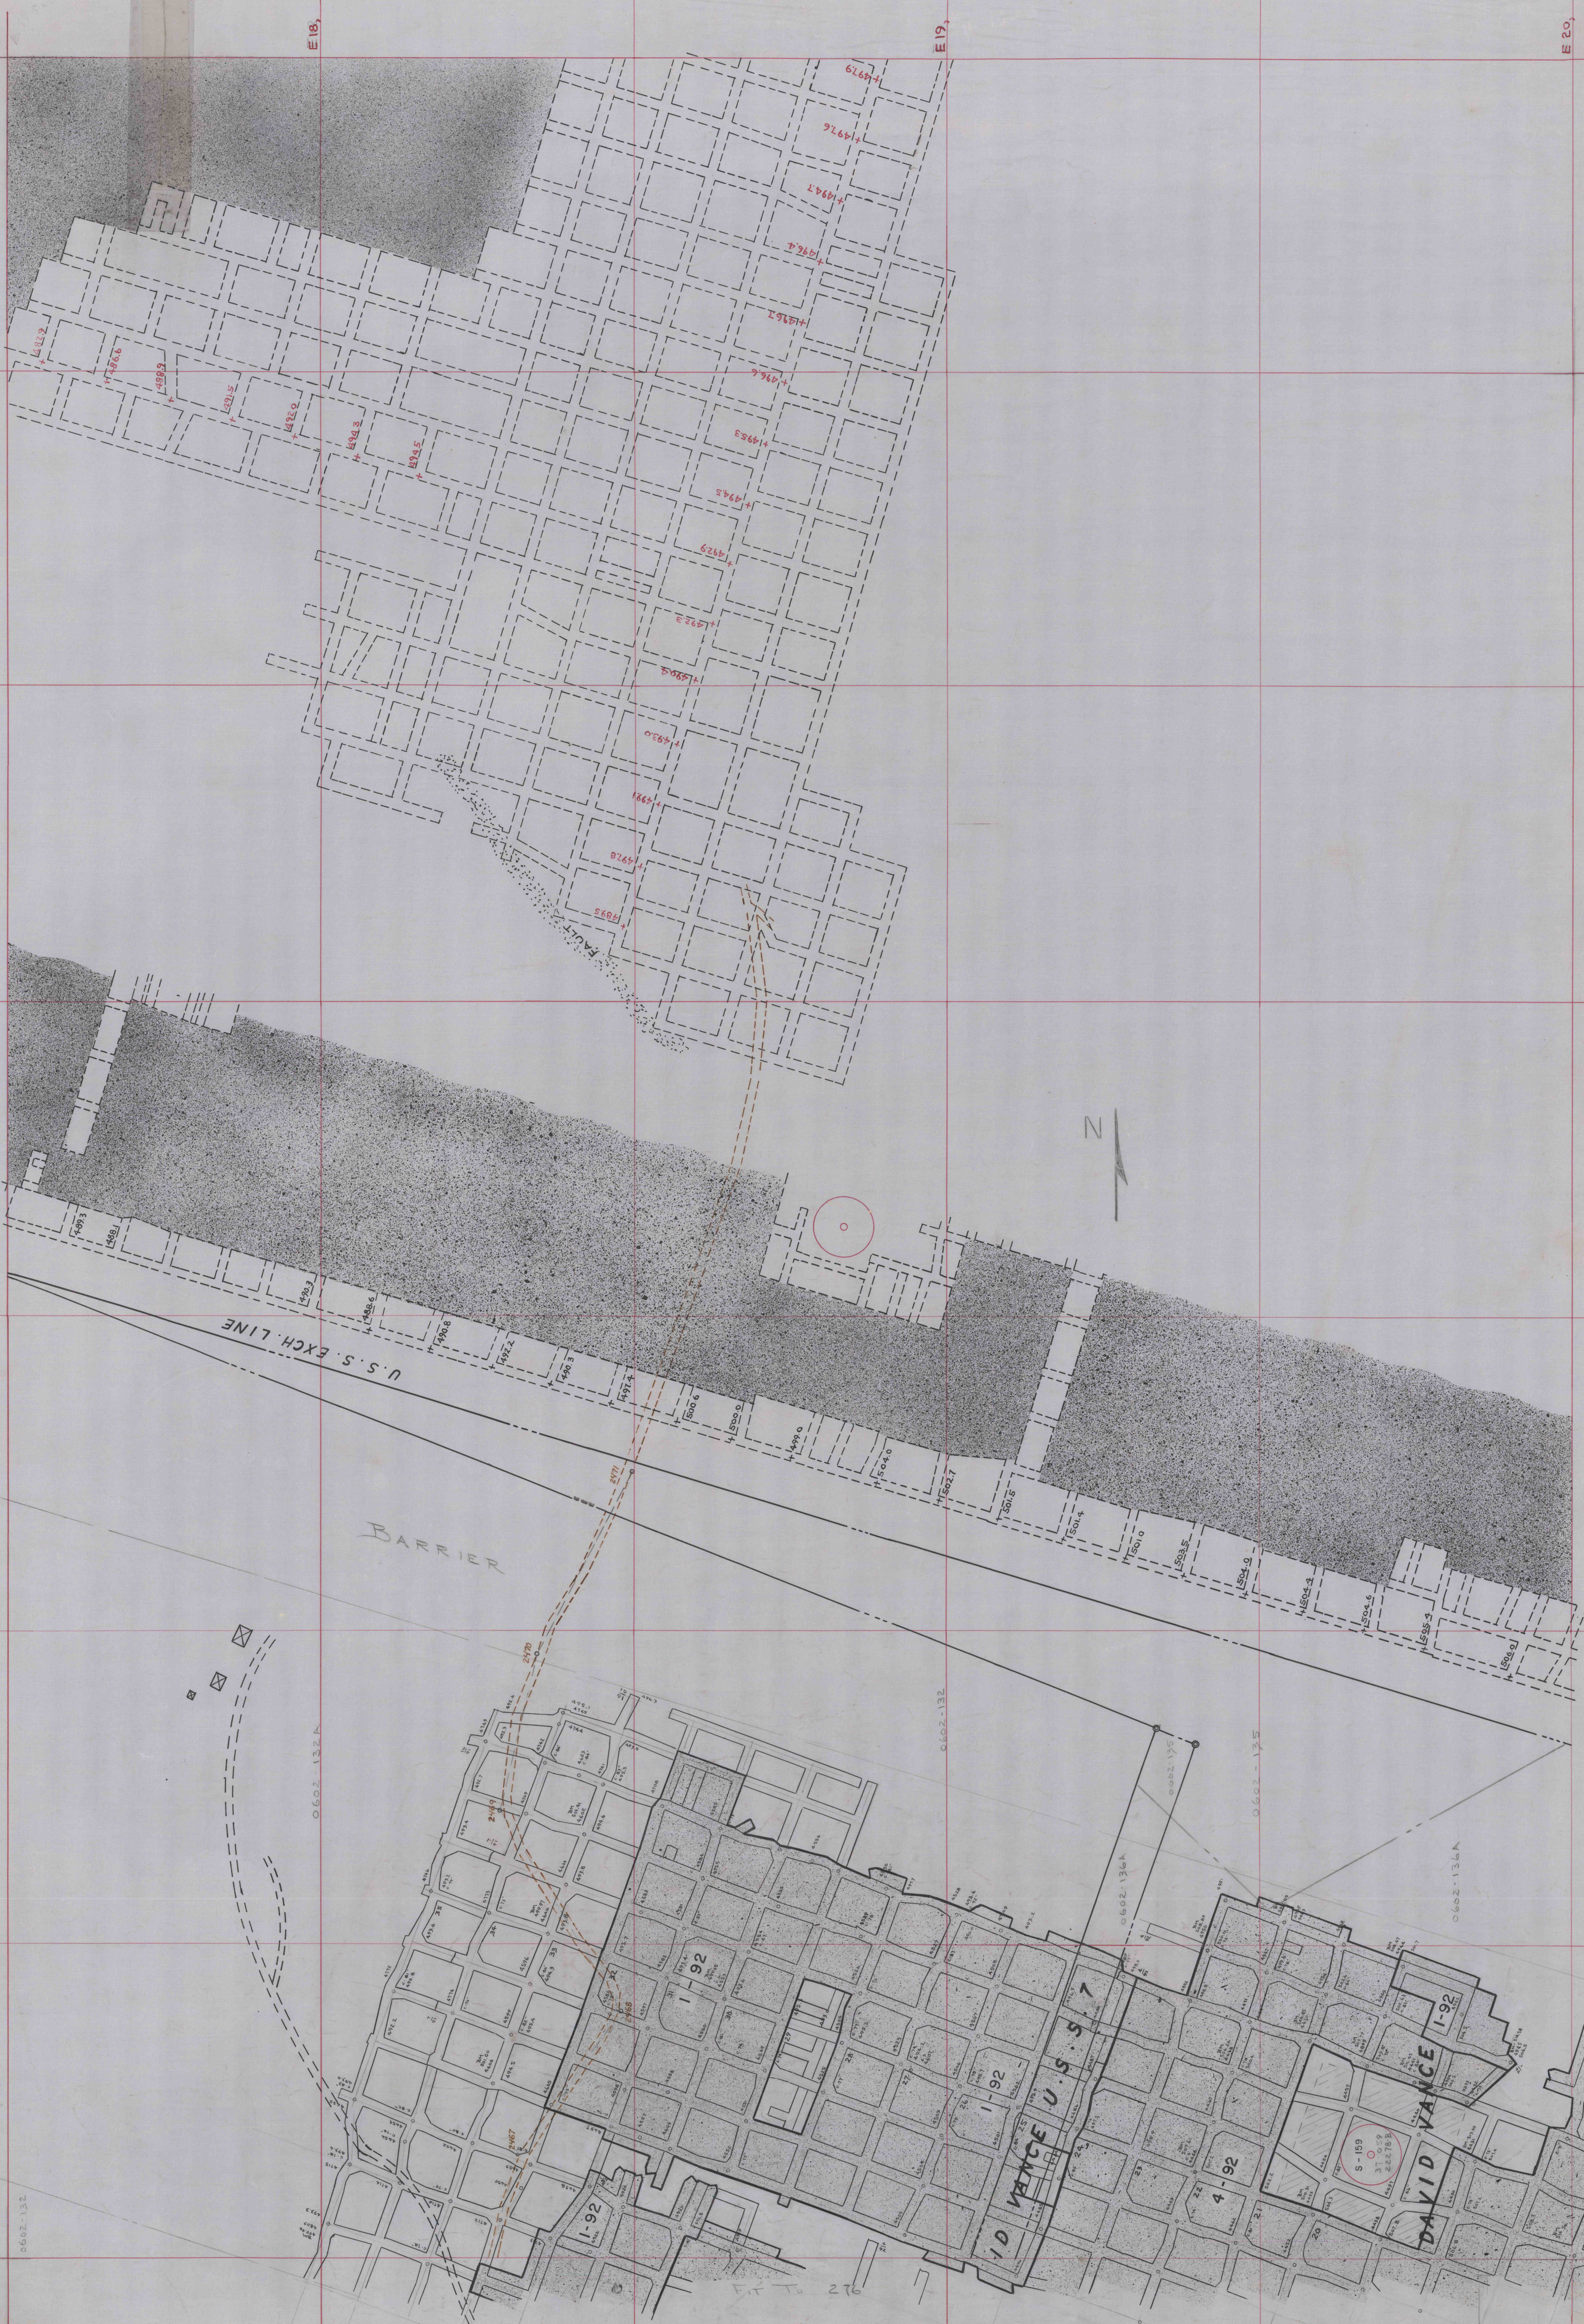

SHAN. SEC. 13
No. 278

N55000

N55000

F.I.T. To 279

N54000

N53000