

J. B. ROBERTS

1105 - 101

MARIAH LIVENGOOD & RACHEL LYNCH

0602-104

0602-103

BARRIER

0602-132

BARRIER





284

277

SHAN. SEC. 13
No. 279

278

0602-132A

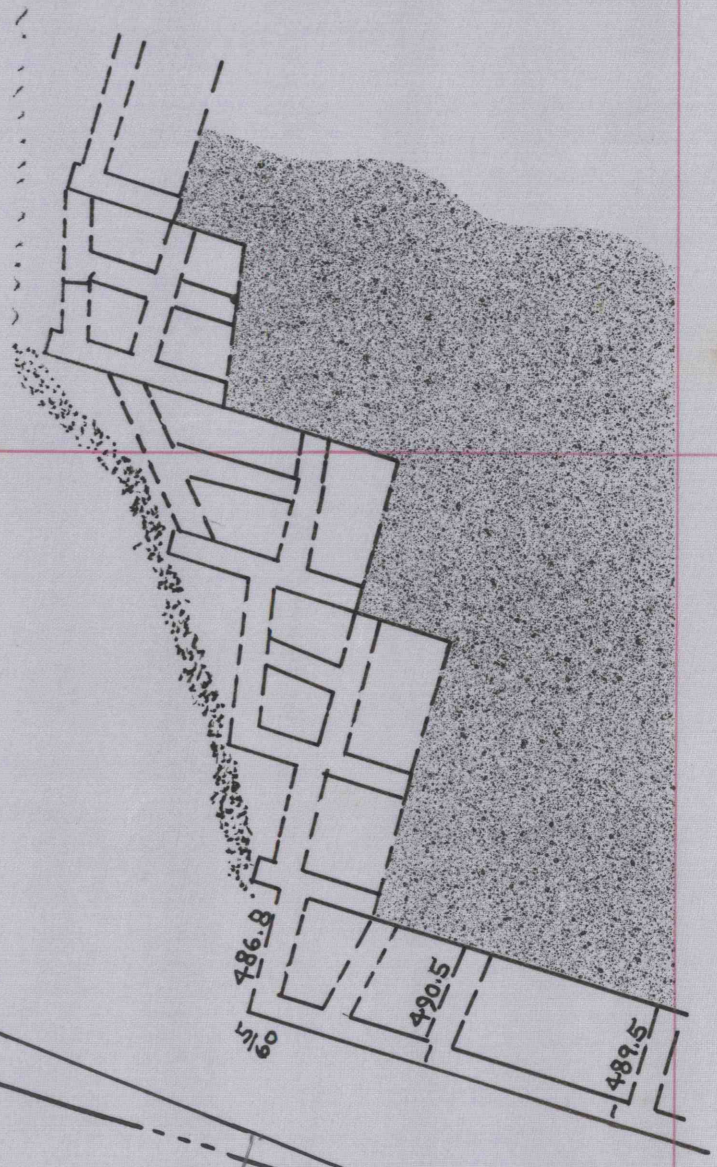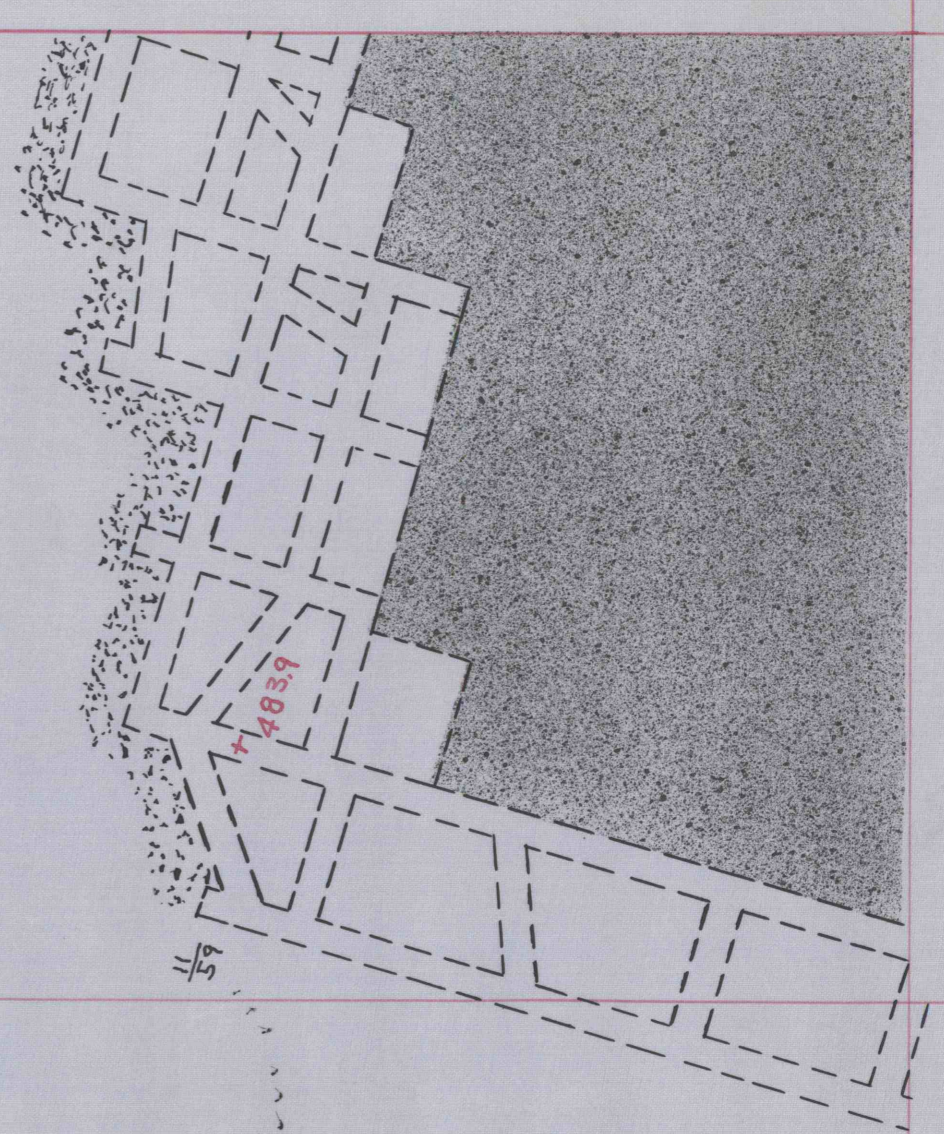

SHAN. SEC. 13
No. 279