

N-27,000

E-30,000


225

N-25,000

E-30,000

Filmed

SECTION No. 4  
225

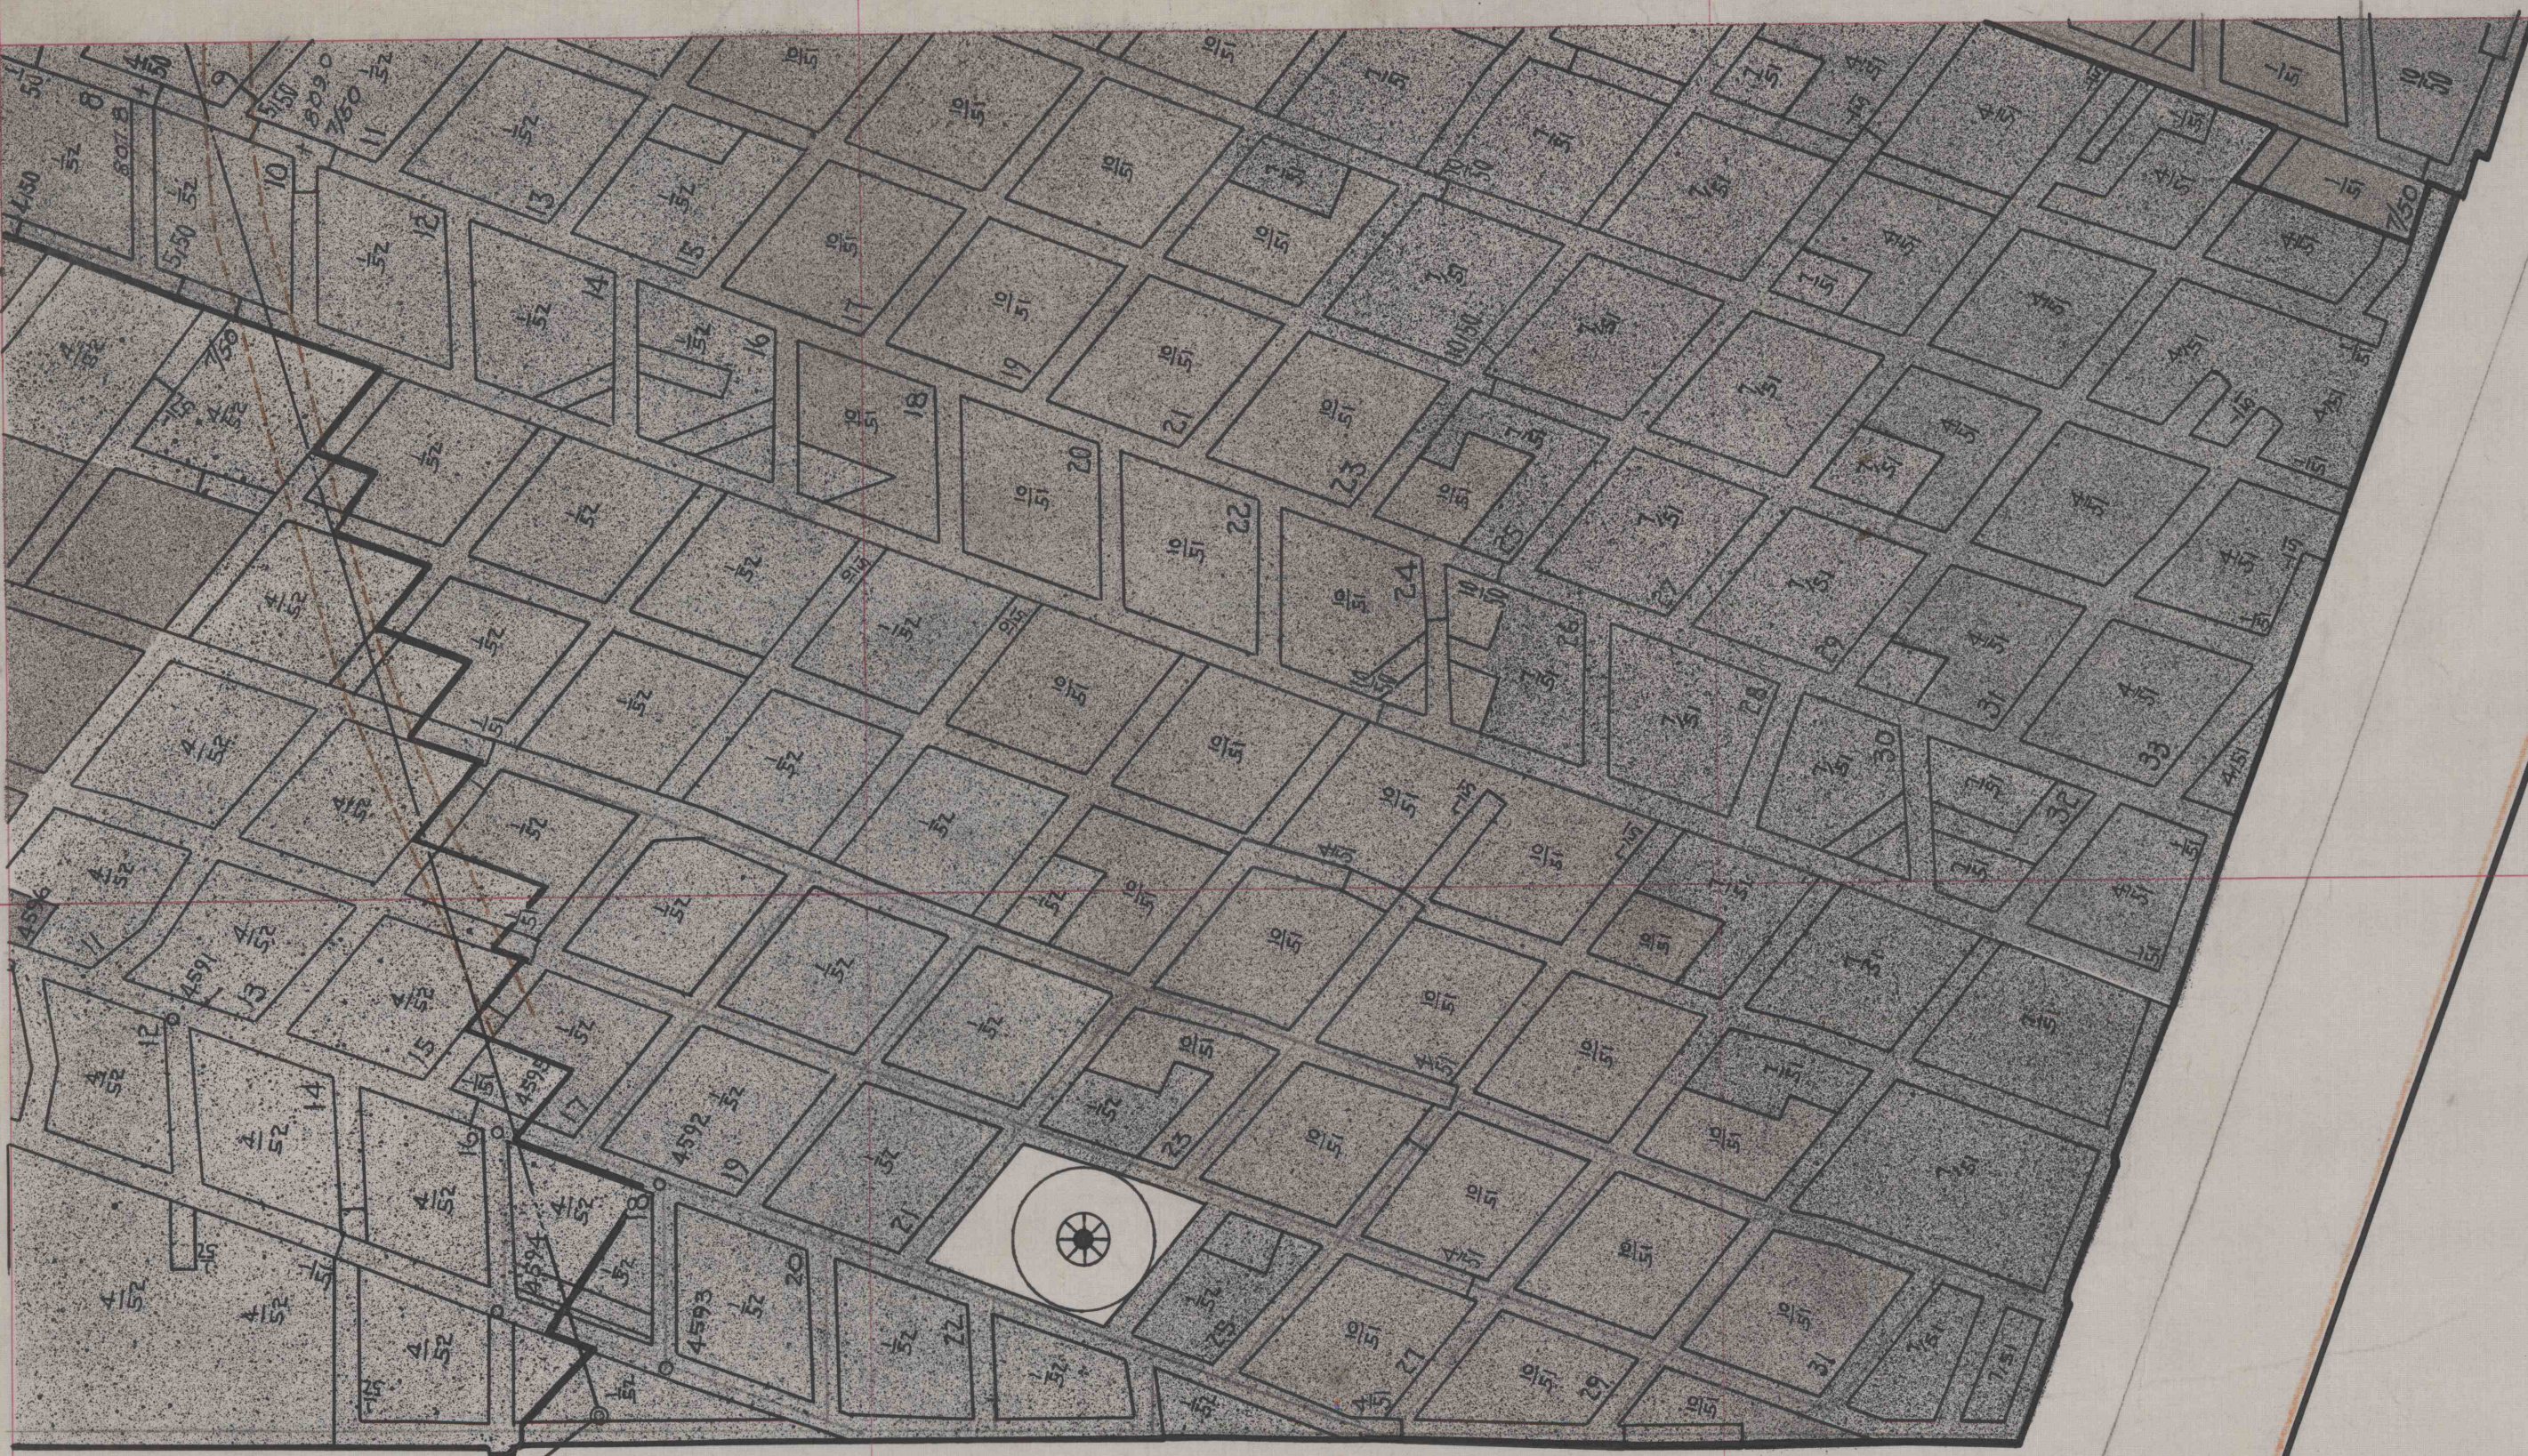

W. VA.  
PENNA.

N 89° 14' 15" W

Bn

Bn

SECTION No. 4  
225

E-27,500

N-27,000

E-27,500

N-25,000