

E-25,000
N-25,000

SECTION No. 4
226


Filed

E-27,500

N-25,000

N-27,000

SECTION No. 4
226

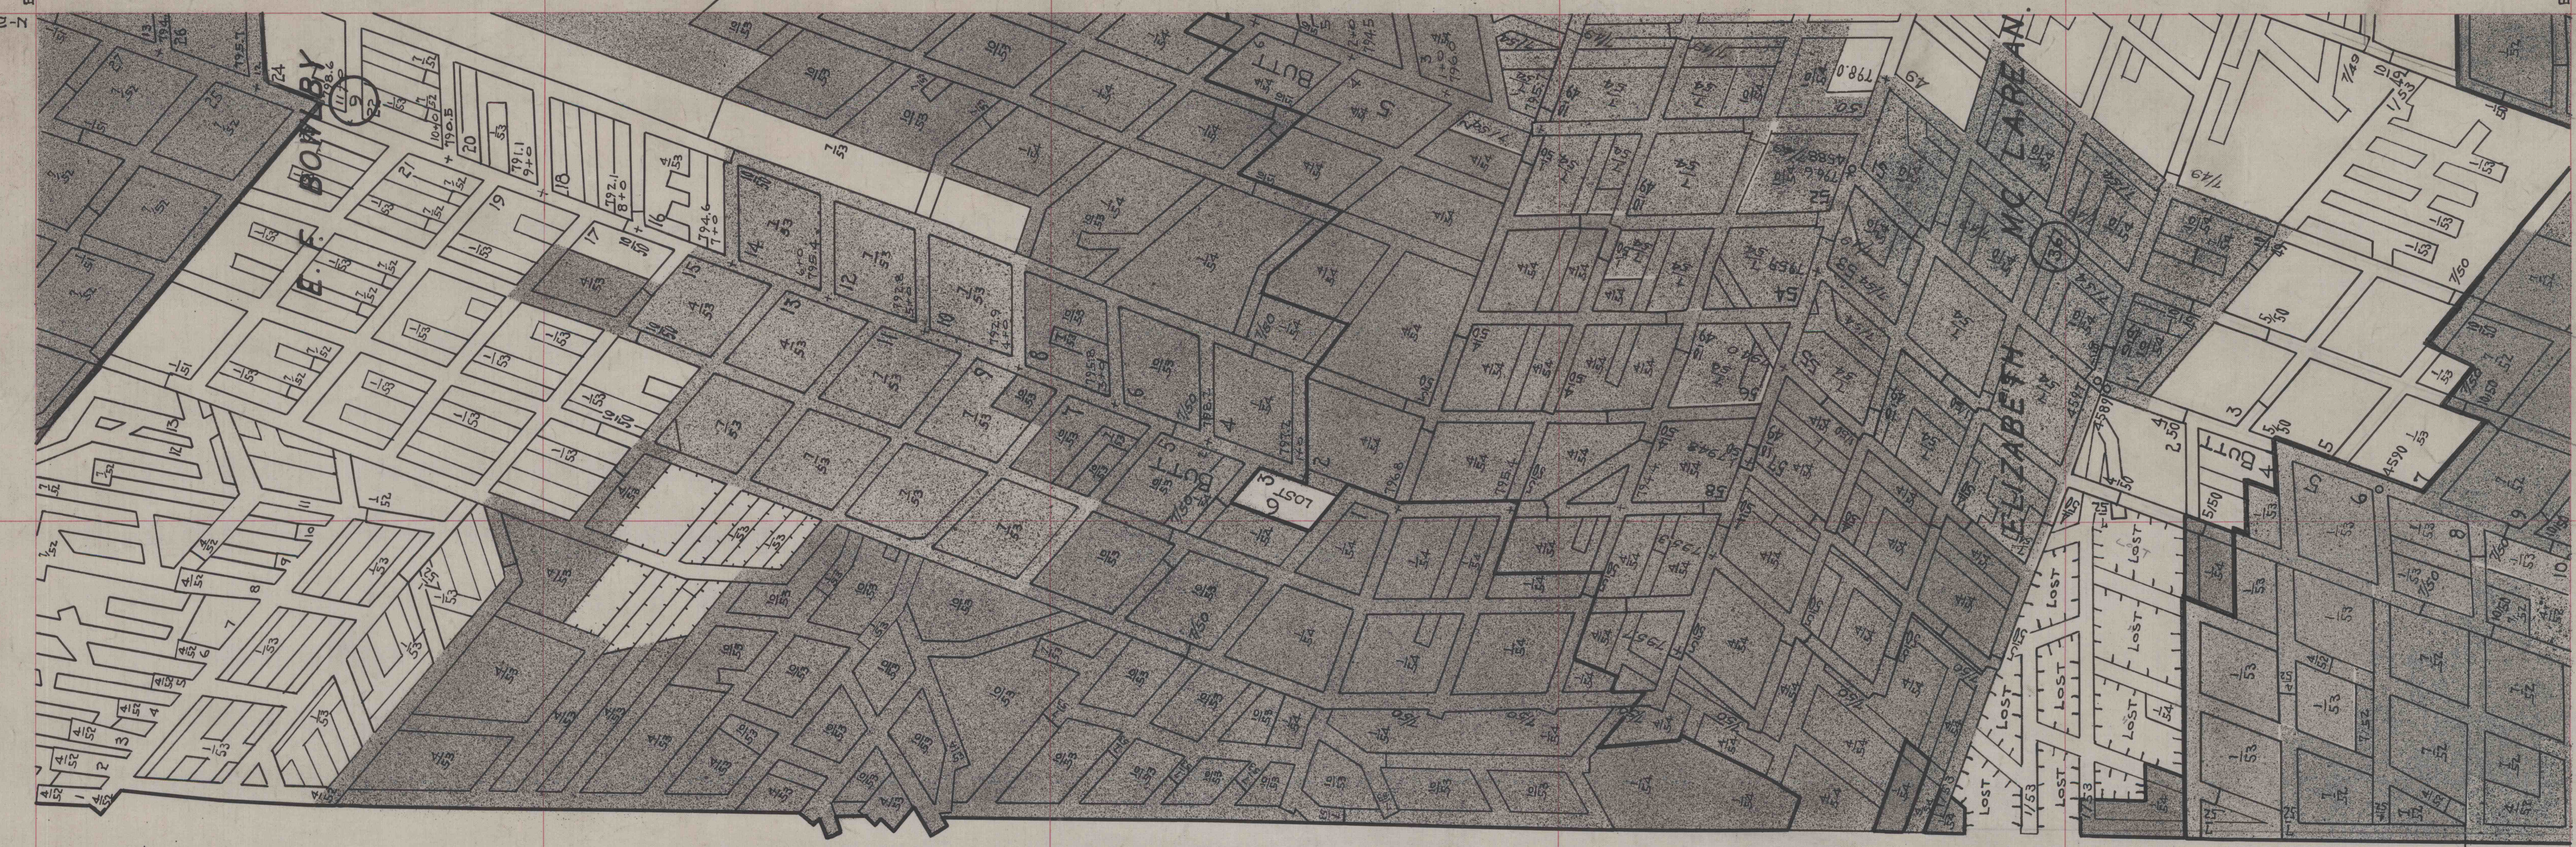

E-27,500

SECTION No. 4
226

N-27,000