

722

N 4-4-000

0601-152

N 4-3-000

0601-153

0601-157

N 4-2-000

0601-159

0601-151

0601-162

0601-147

0601-162

0601-163




WALL

JOHN S. FRANKENBERRY

D = 35.94 A.  
C = 35.0573 A.

(73)

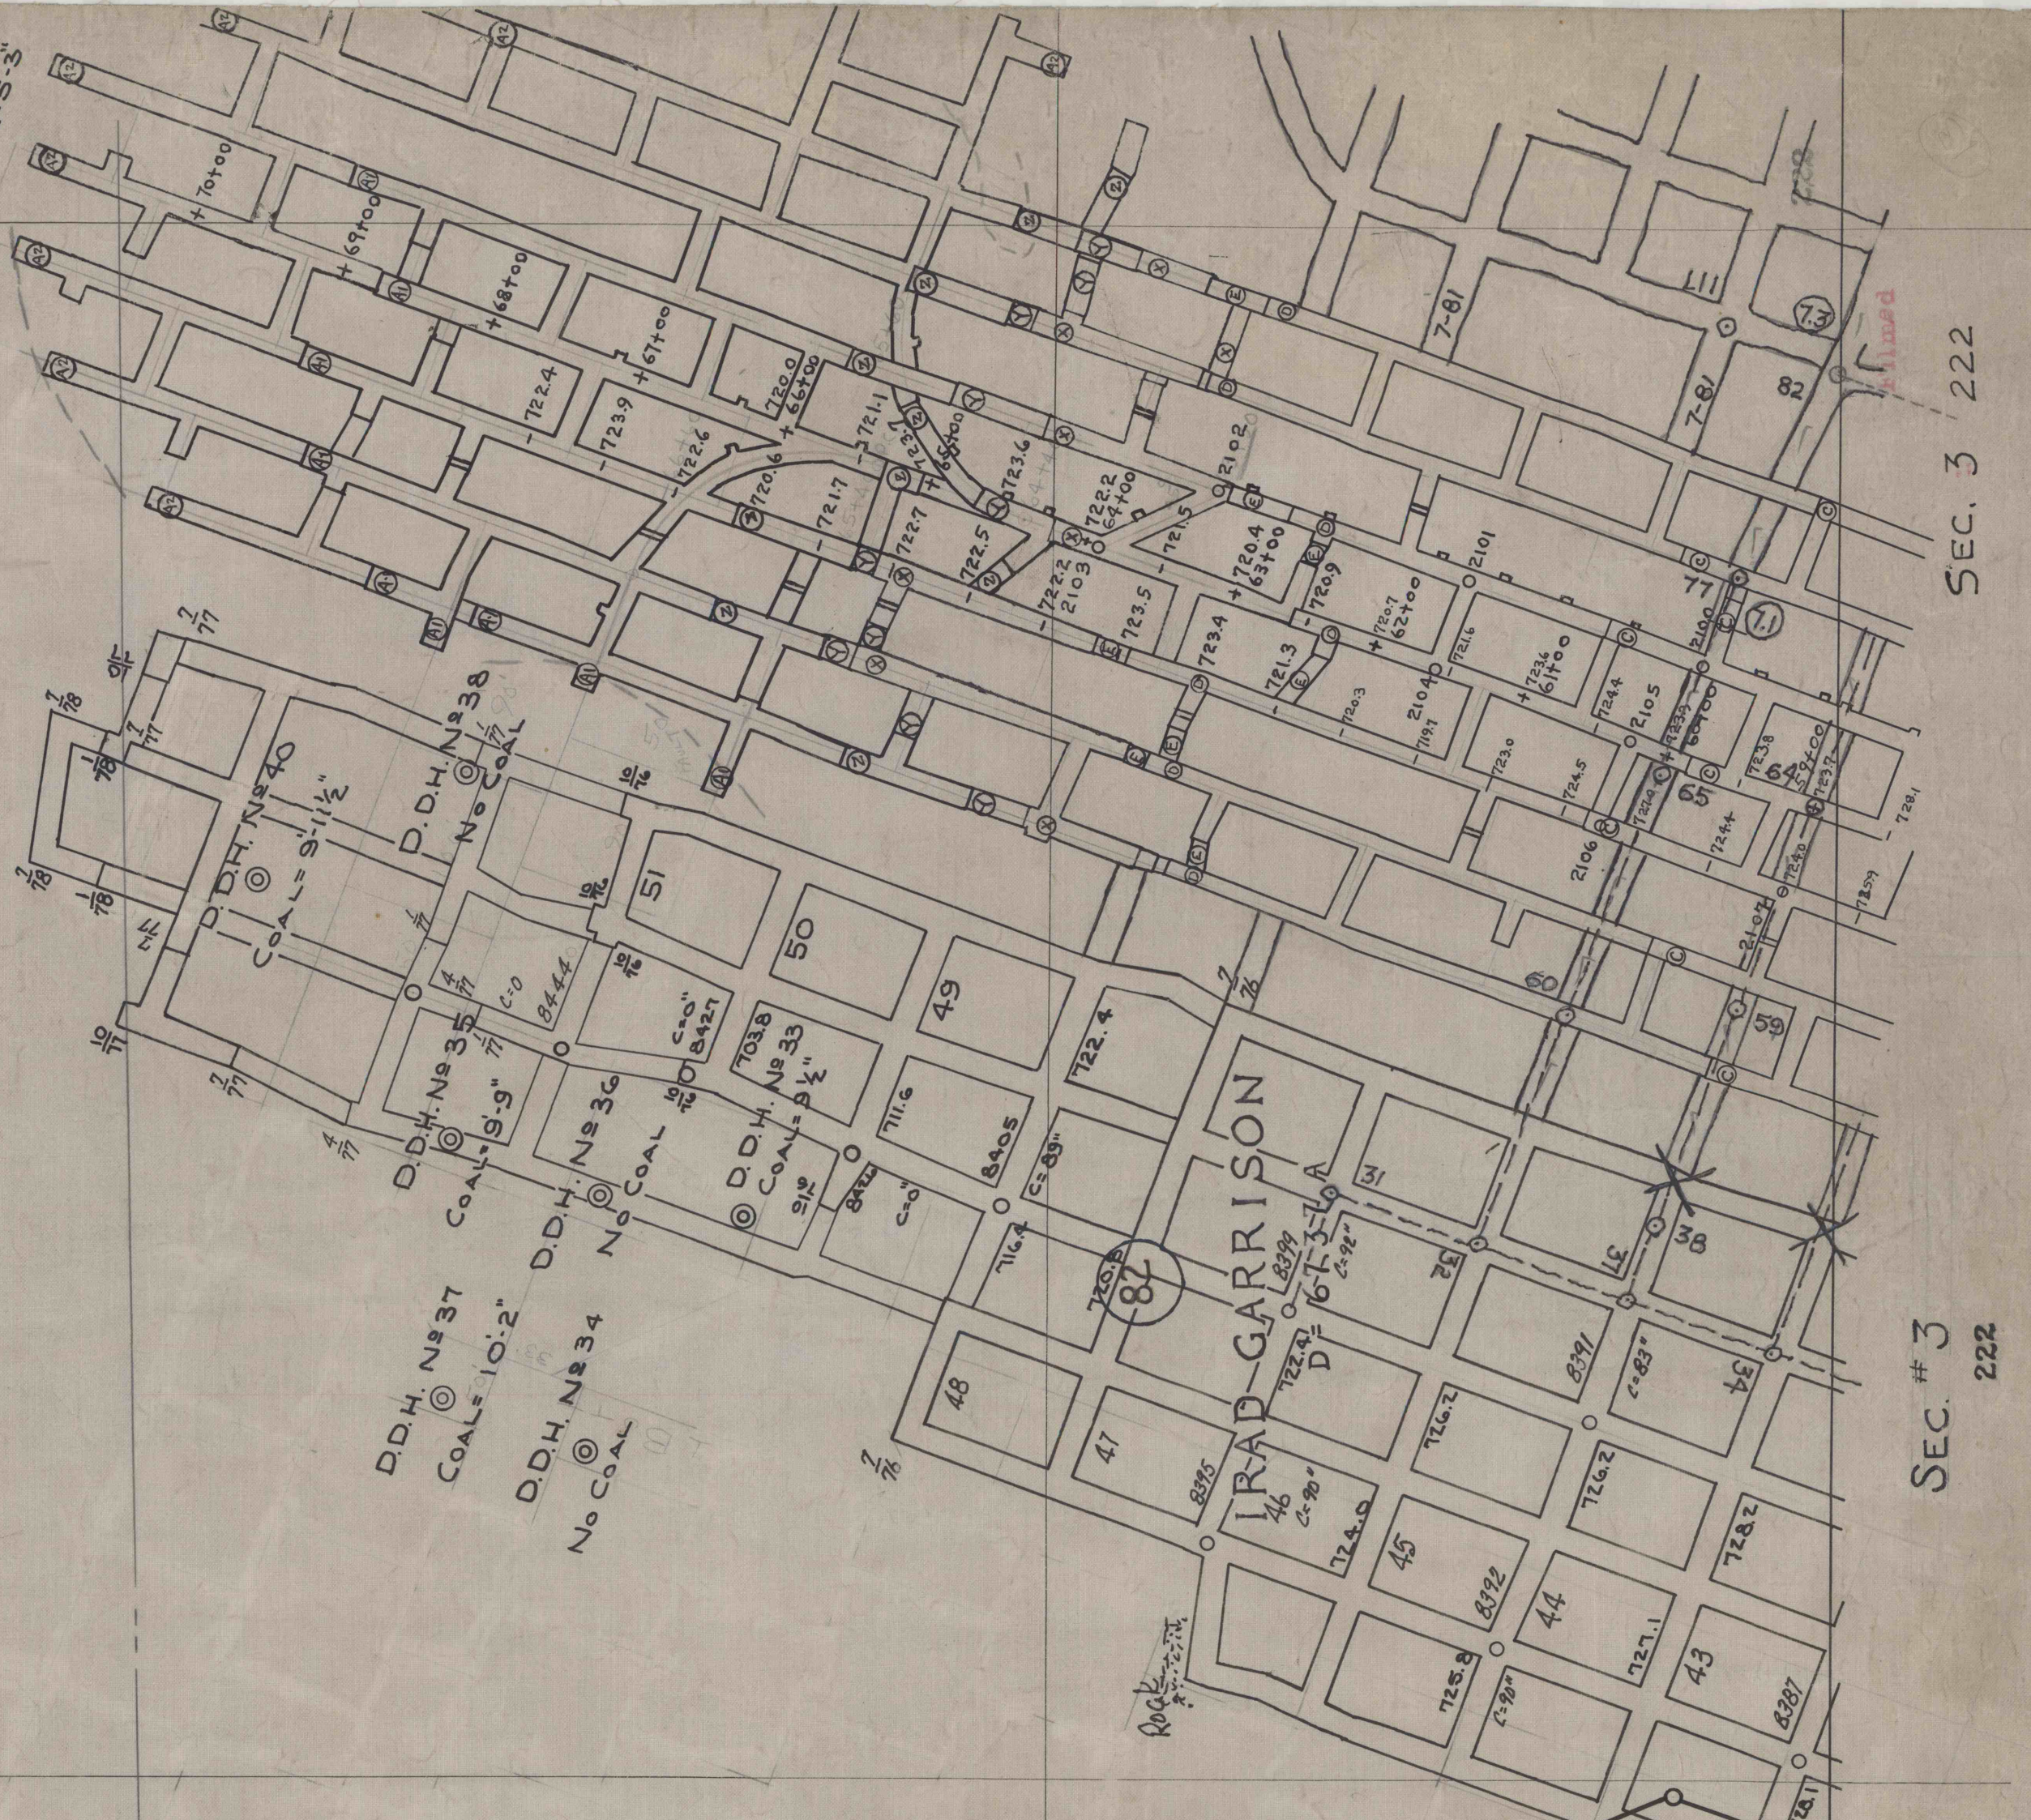

SEC. # 3

SEC. 3

222

222

SEC. # 3

222

N 4-0-000

202