


SEC # 2
212

N 24000
E 35000

N 24000
E 35000

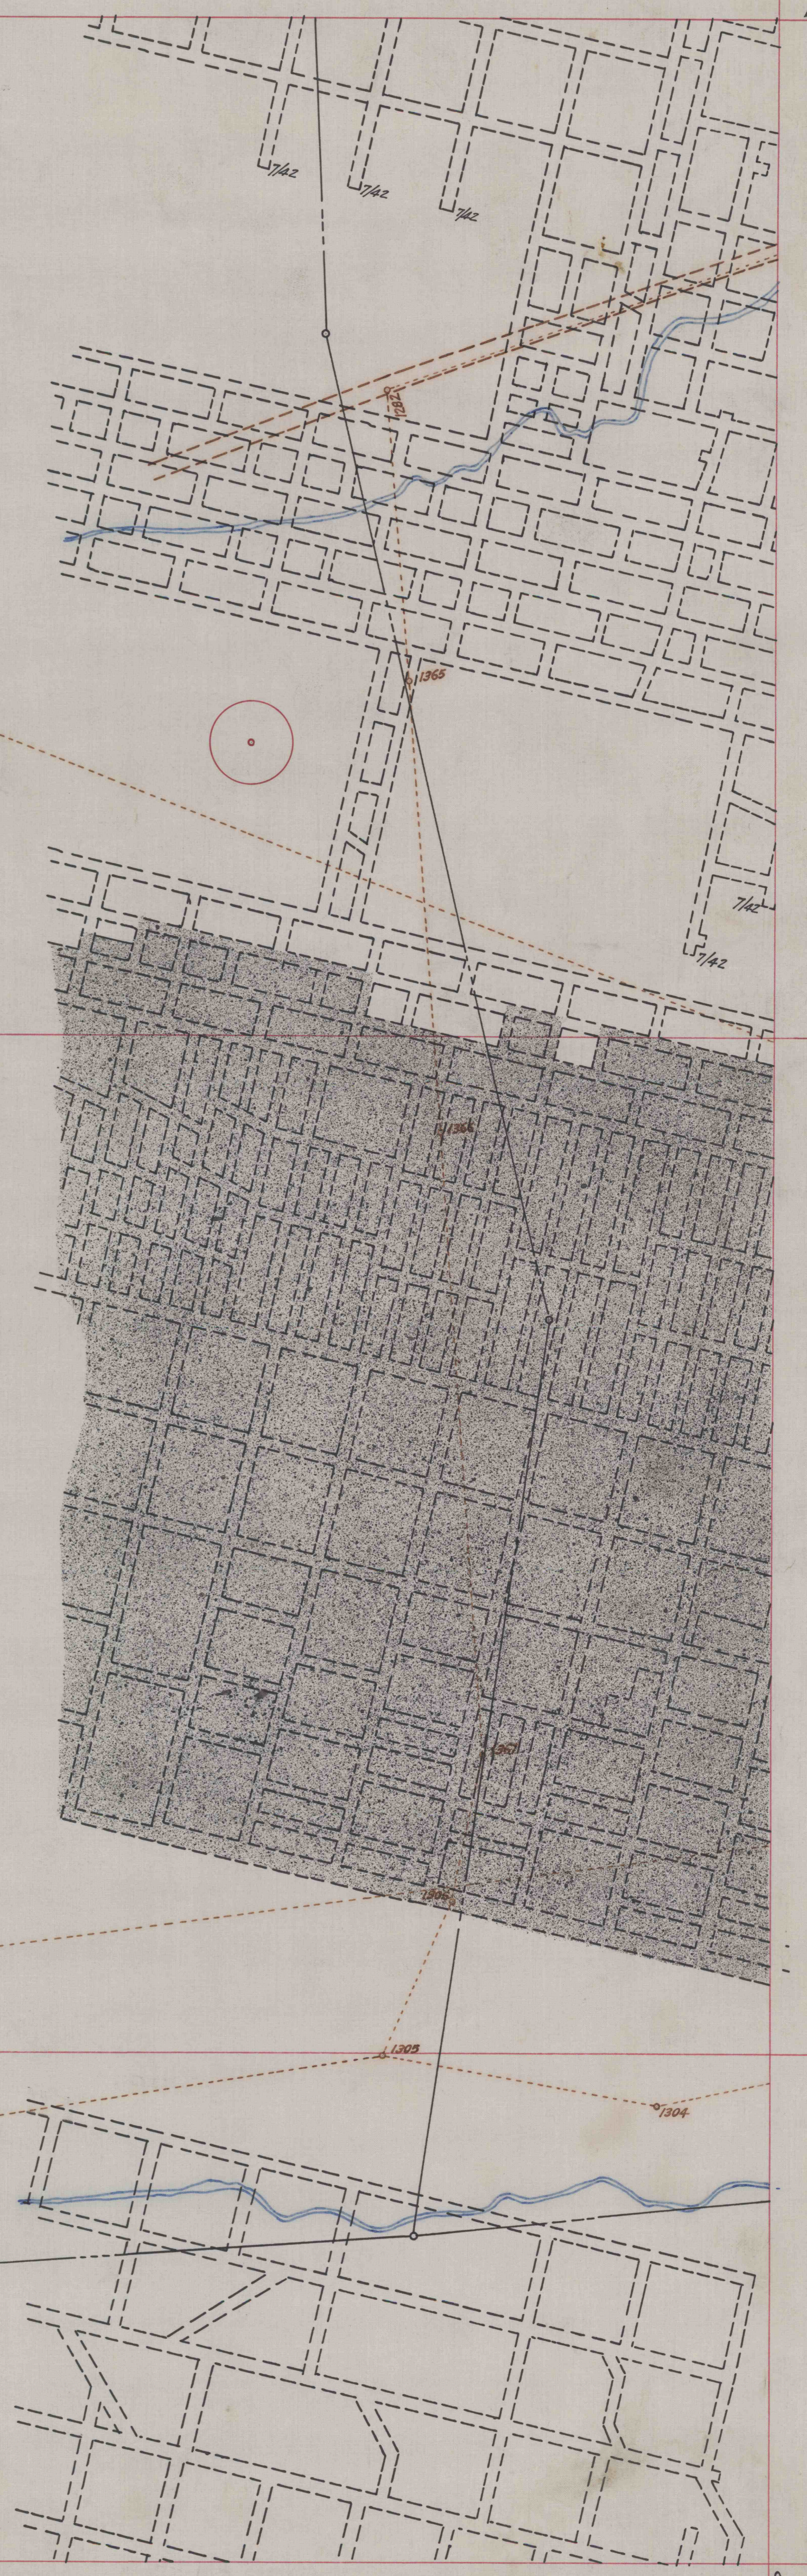

SEC # 2
212

Filmed
1/28/00

212