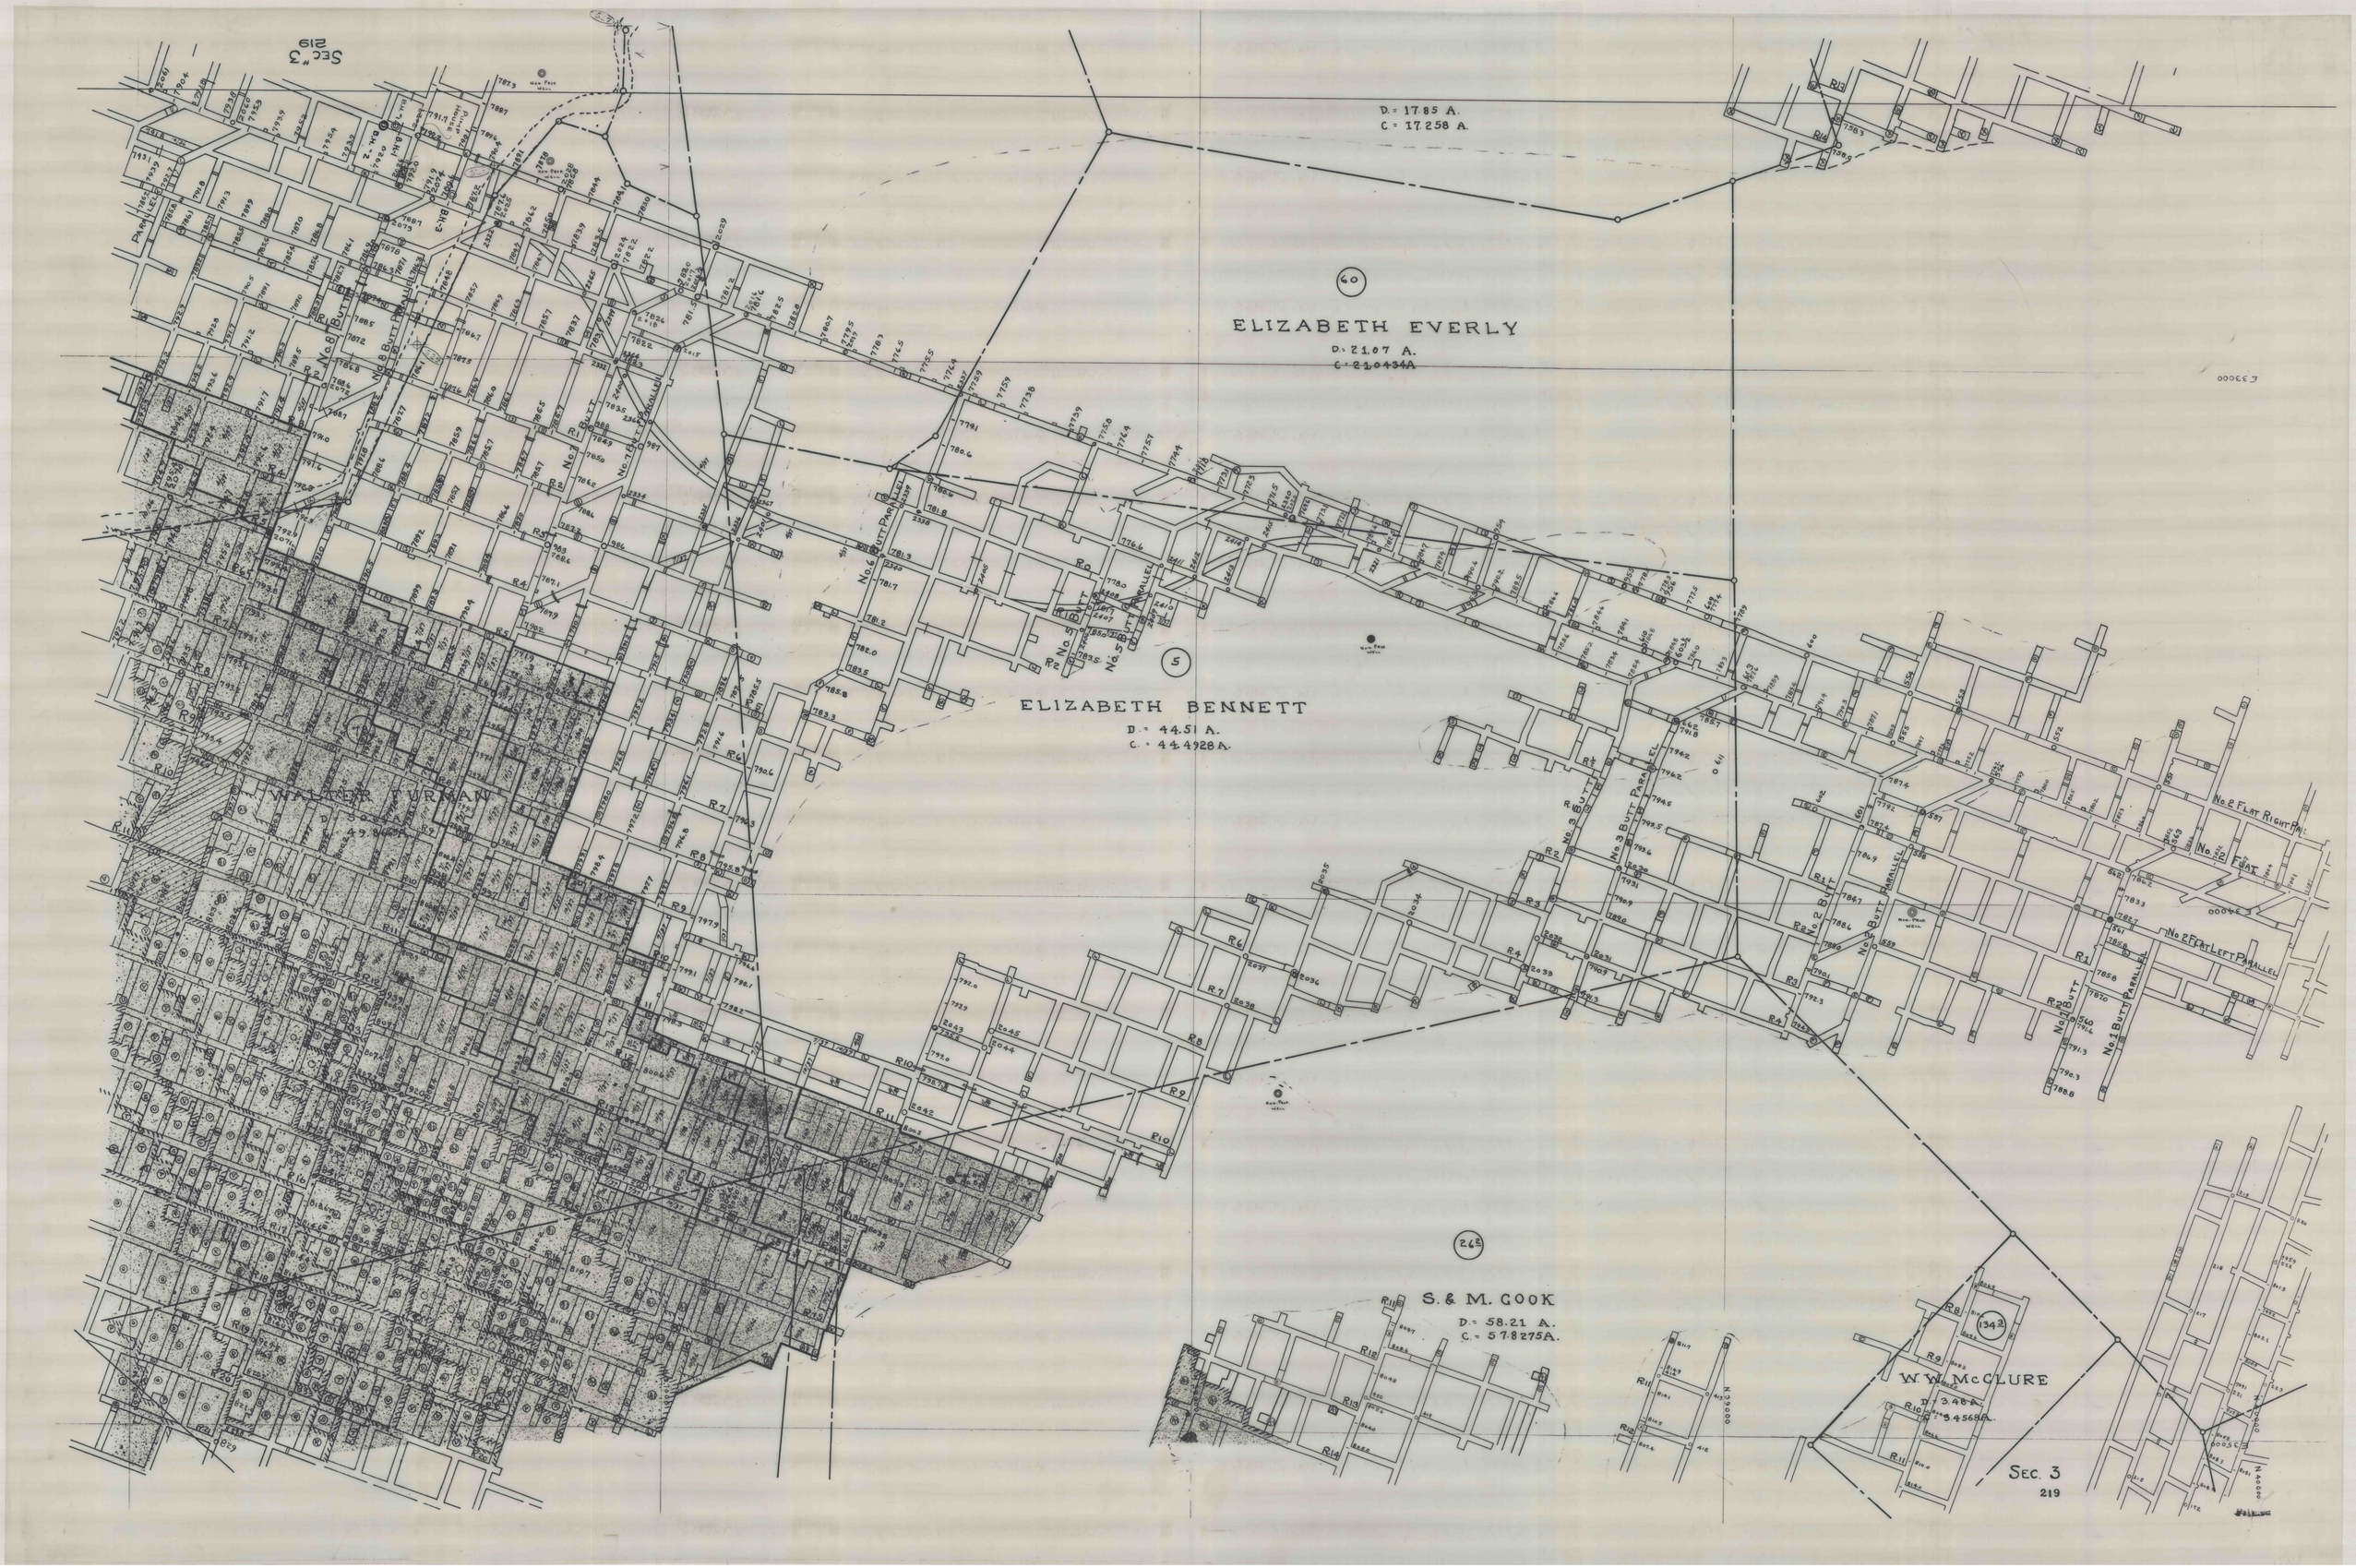

Sec. 3
219
D. = 17.85 A.
C. = 17.258 A.
60
ELIZABETH EVERLY
D. = 21.07 A.
C. = 21.0434 A.
5
ELIZABETH BENNETT
D. = 44.51 A.
C. = 44.4928 A.
WALTER TURMAN
No. 2 FLAT RIGHT PA.
No. 2 FLAT
No. 2 FLAT LEFT PARALLEL
No. 1 BUTT PARALLEL
No. 2 BUTT PARALLEL
No. 3 BUTT PARALLEL
No. 5 BUTT PARALLEL
No. 6 BUTT PARALLEL
No. 8 BUTT PARALLEL
26
S. & M. COOK
D. = 58.21 A.
C. = 57.8275 A.
134
W. W. McCLURE
D. = 3.48 A.
C. = 3.4568 A.
Sec. 3
219