


RHODA HEROD

SHAN. SEC. 12  
N 270

N 52900

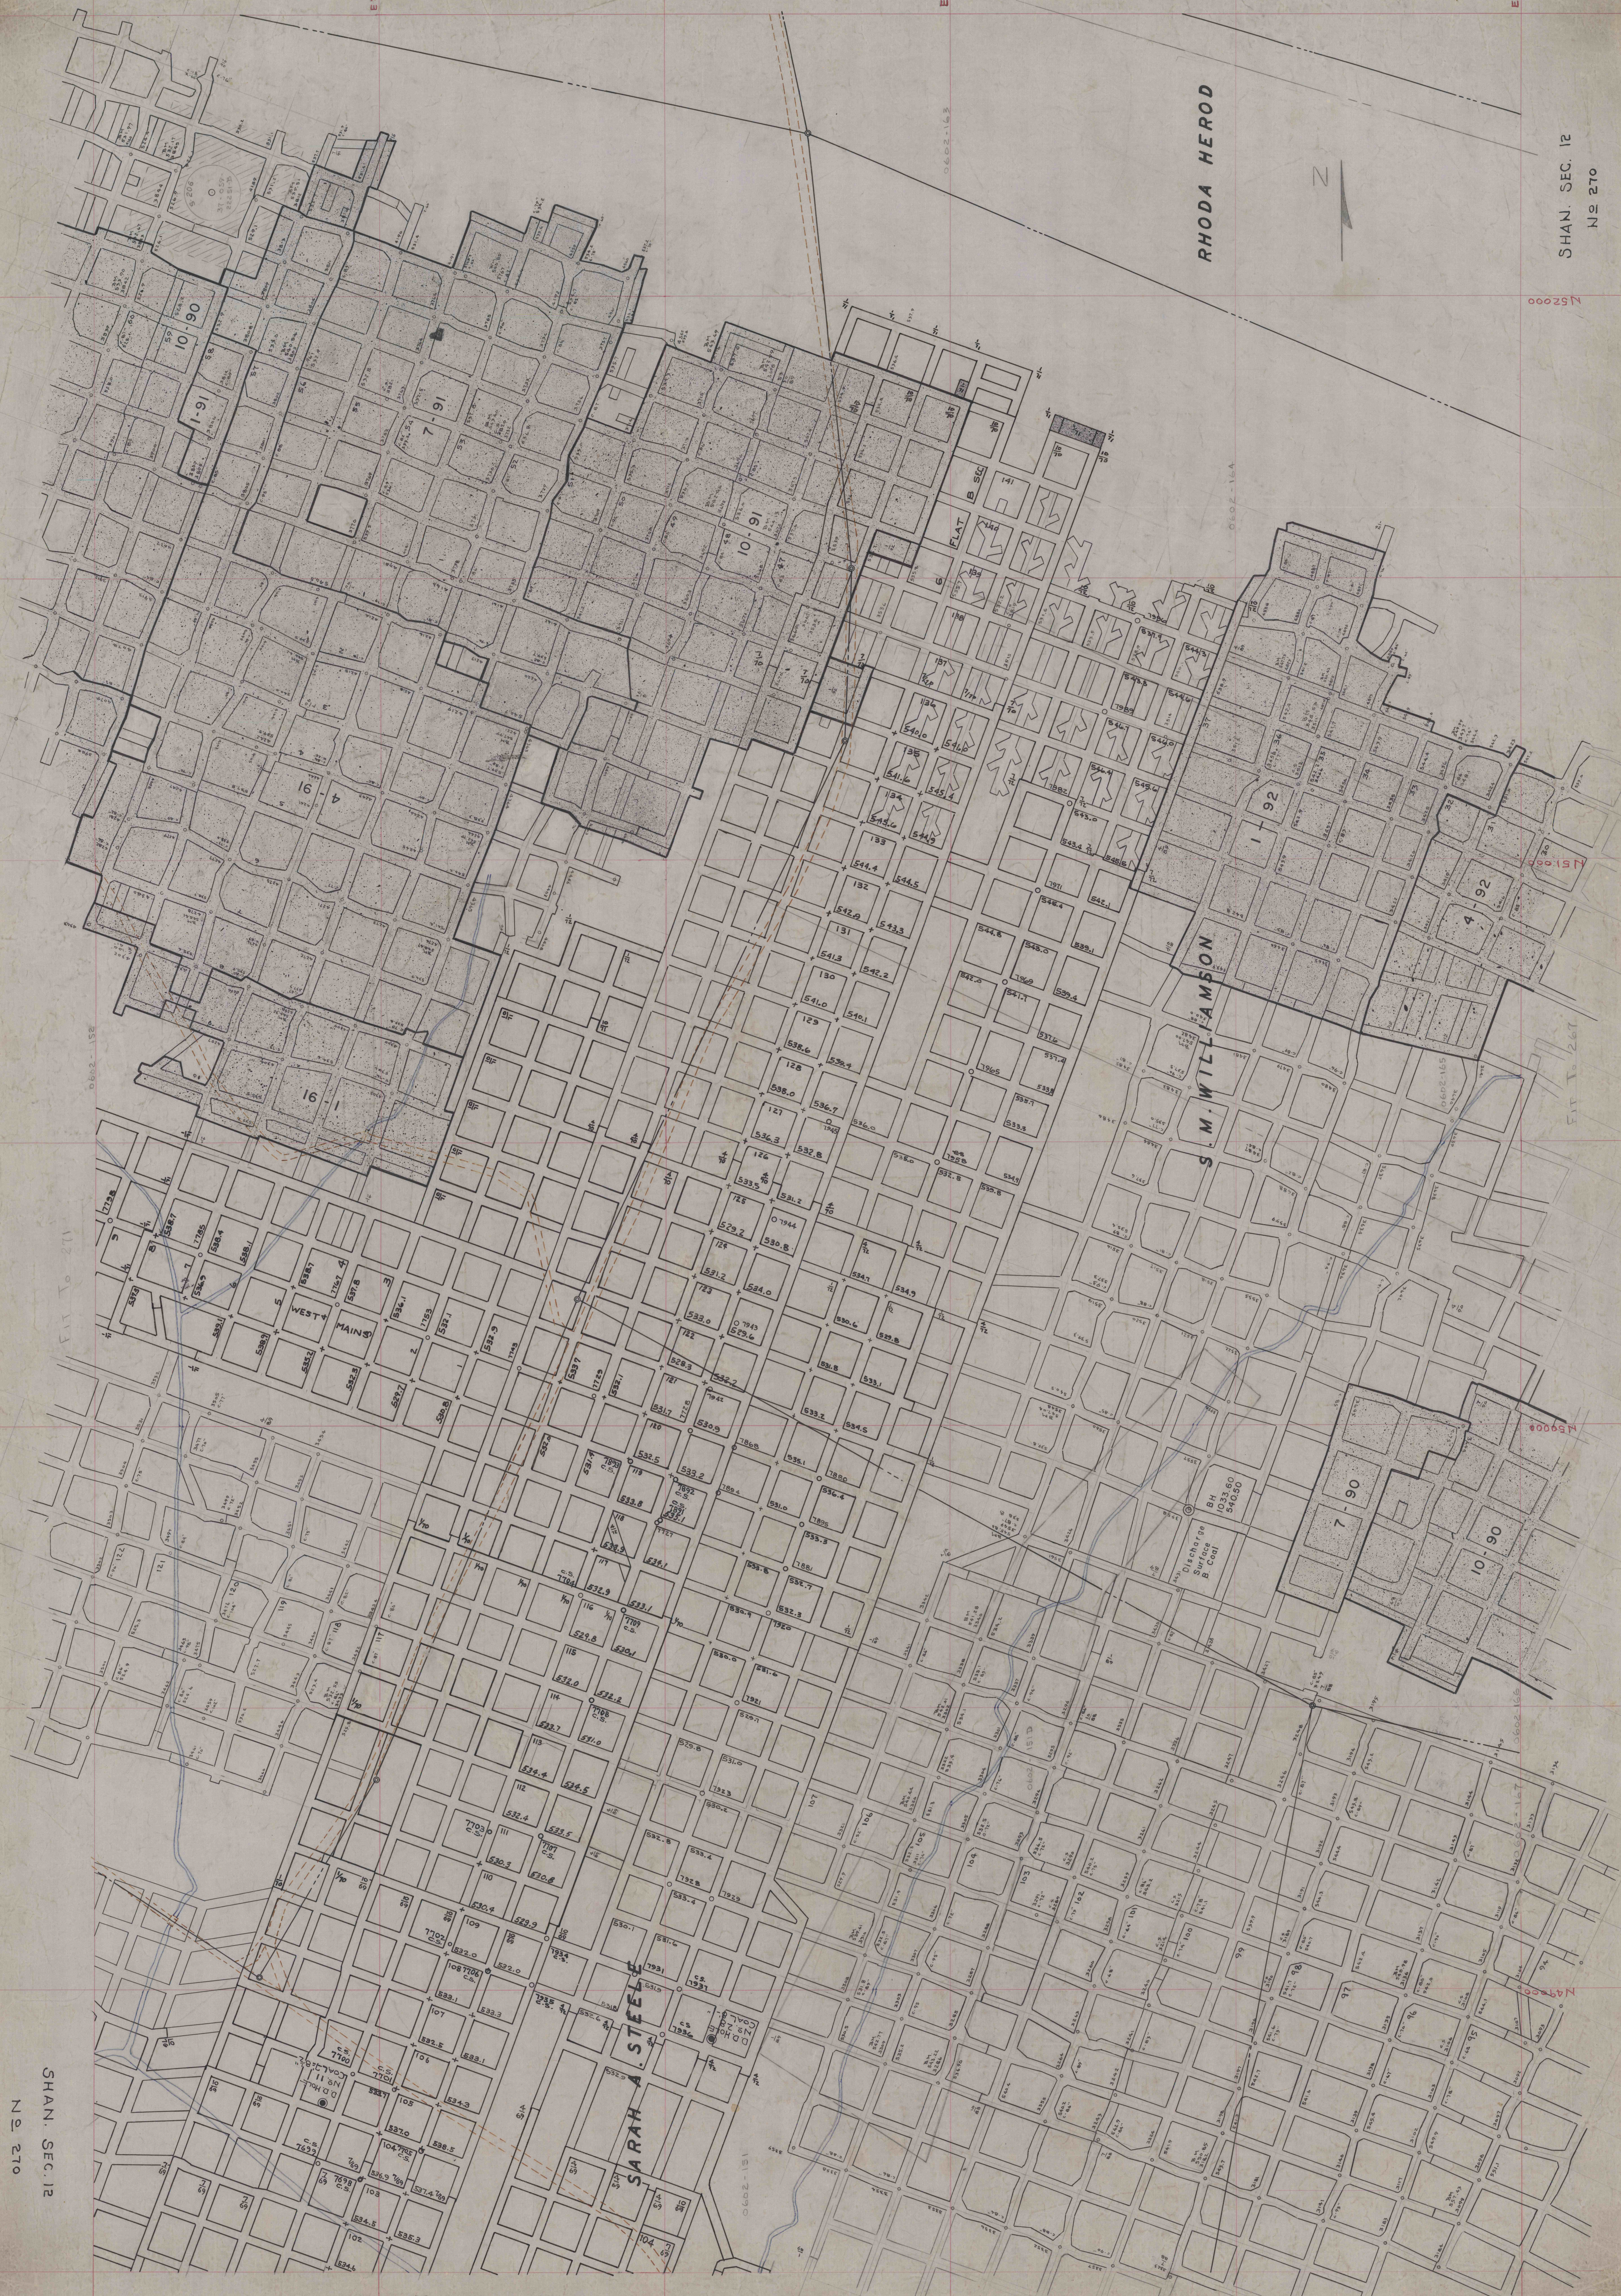

SHAN. SEC. 12  
N 270