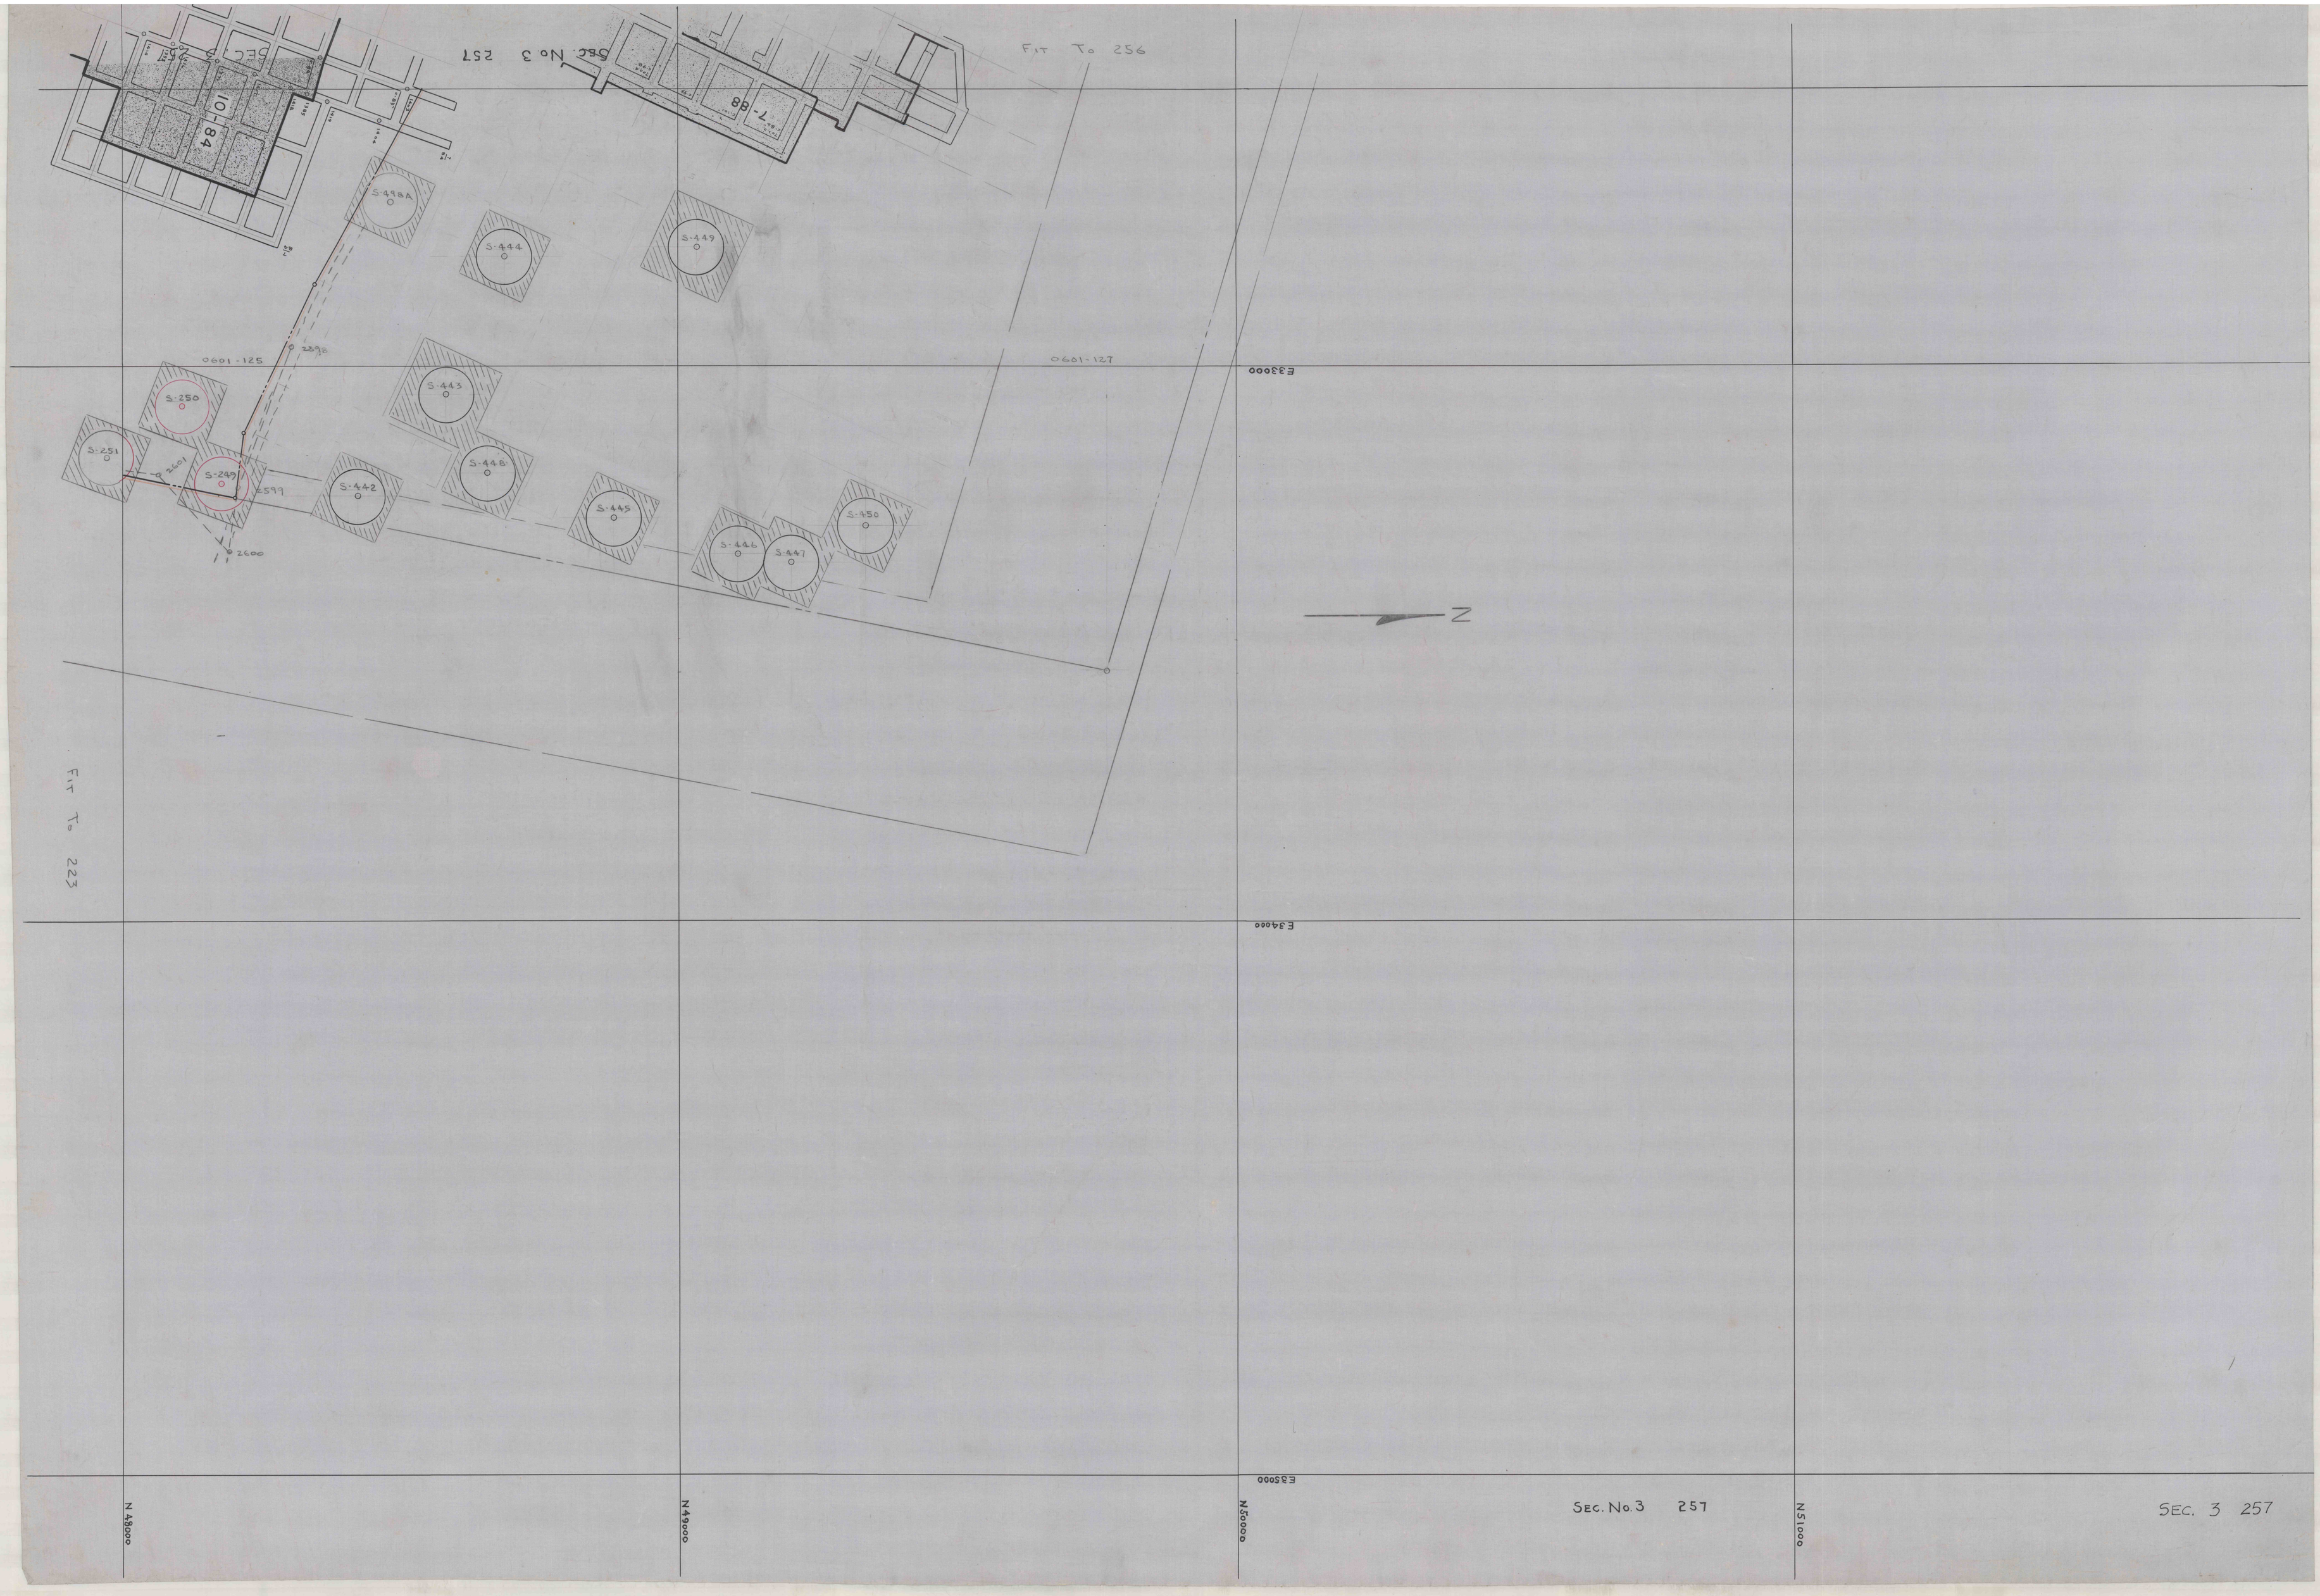

Sec. No. 3 257
Fit To 256
10-84
7-88
S-498A
S-444
S-449
0601-125
0601-127
2398
S-250
S-443
S-251
2601
S-249
2599
S-442
S-448
S-445
S-446
S-447
S-450
2600
N
Fit To 223
E33000
E34000
E35000
N48000
N49000
N50000
N51000
Sec. No. 3 257
Sec. 3 257