


- 252 -

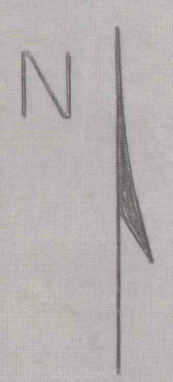

SEC. No. 5
255

SEC. 5 255

SPENCER M. DONLEY
52

0601 - 113

0601 - 115

0601 - 120A

Fit To 262

0601 - 153

0601 - 152



JOS. R. GARRISON
83

D. B. DONLEY
38

0601 - 154

0601 - 157

253

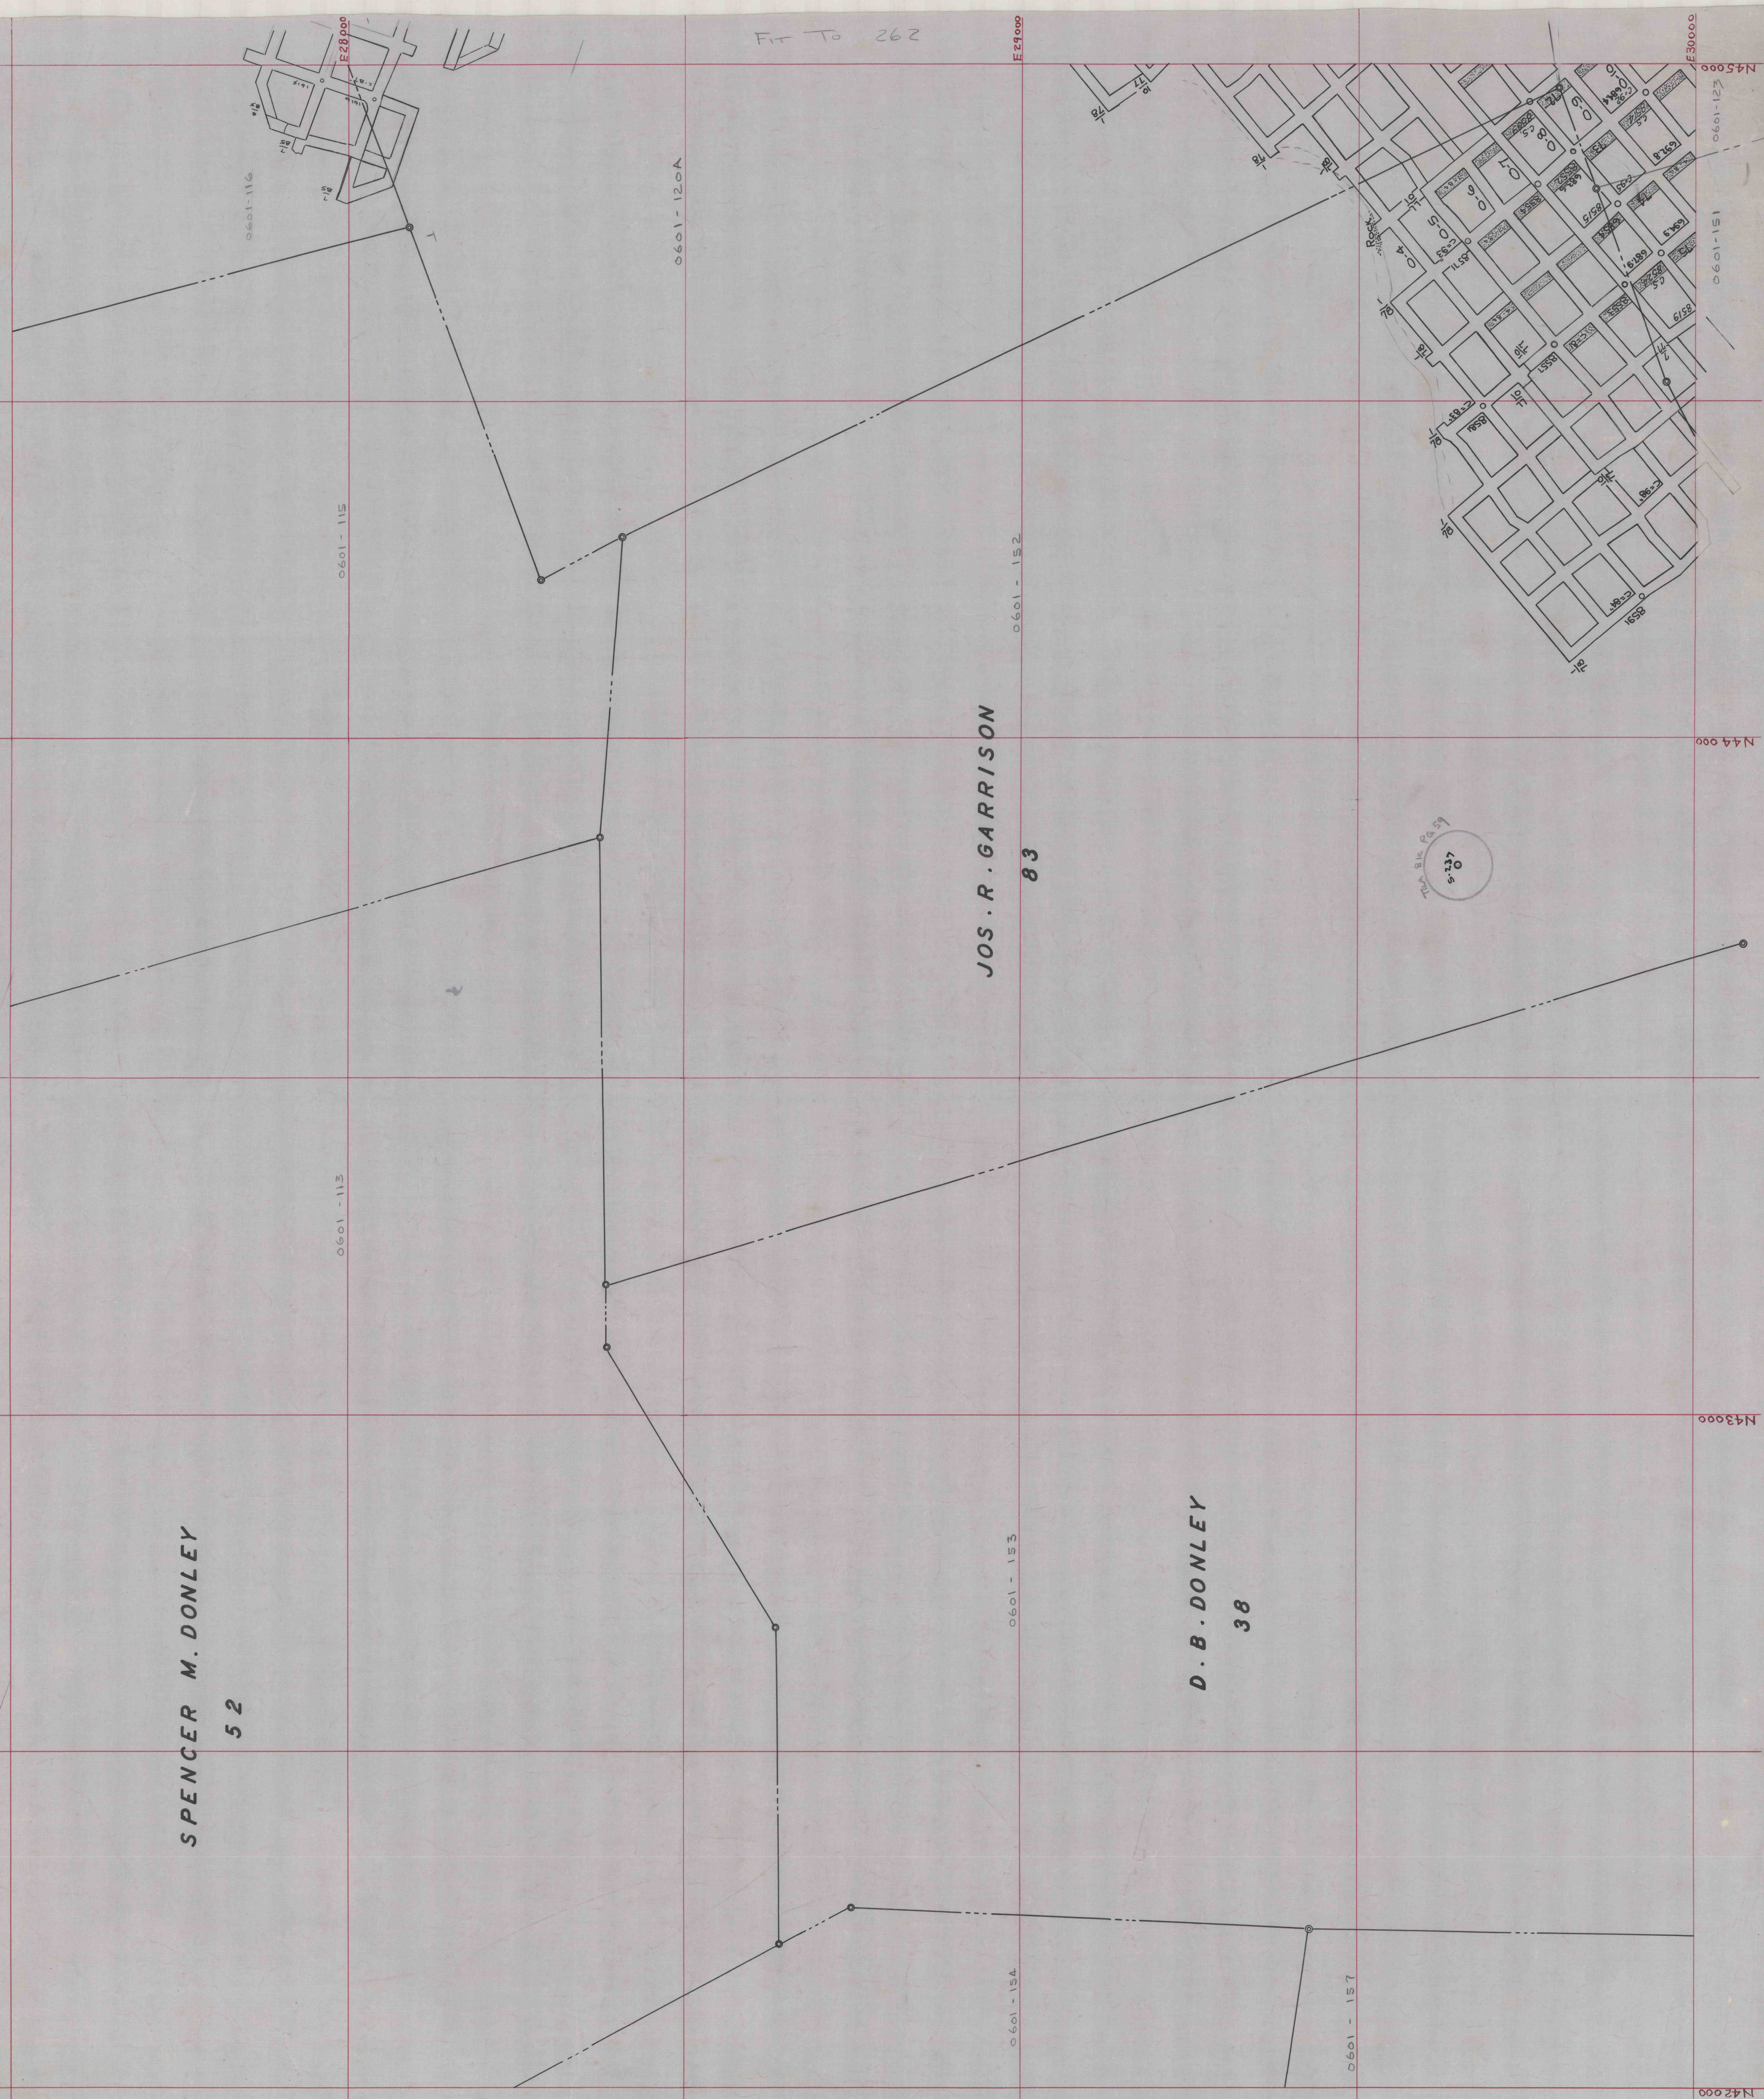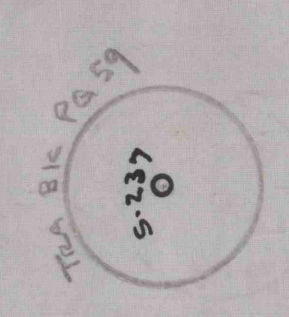

N42000

N43000

N44000

N45000

SEC. No. 5
255

SEC. 5 255

0601 - 151

0601 - 123

E30000

0601 - 116

E28000

Roosevelt

Oak

78

79

80

81

82

83

84

85

86

87

88

89

90

91

92

93

94

95

96

97

98

99

100

0.4

0.5

