

N35000

N34500

N34000


0052EN

N33000

N32500

N32000

N31500

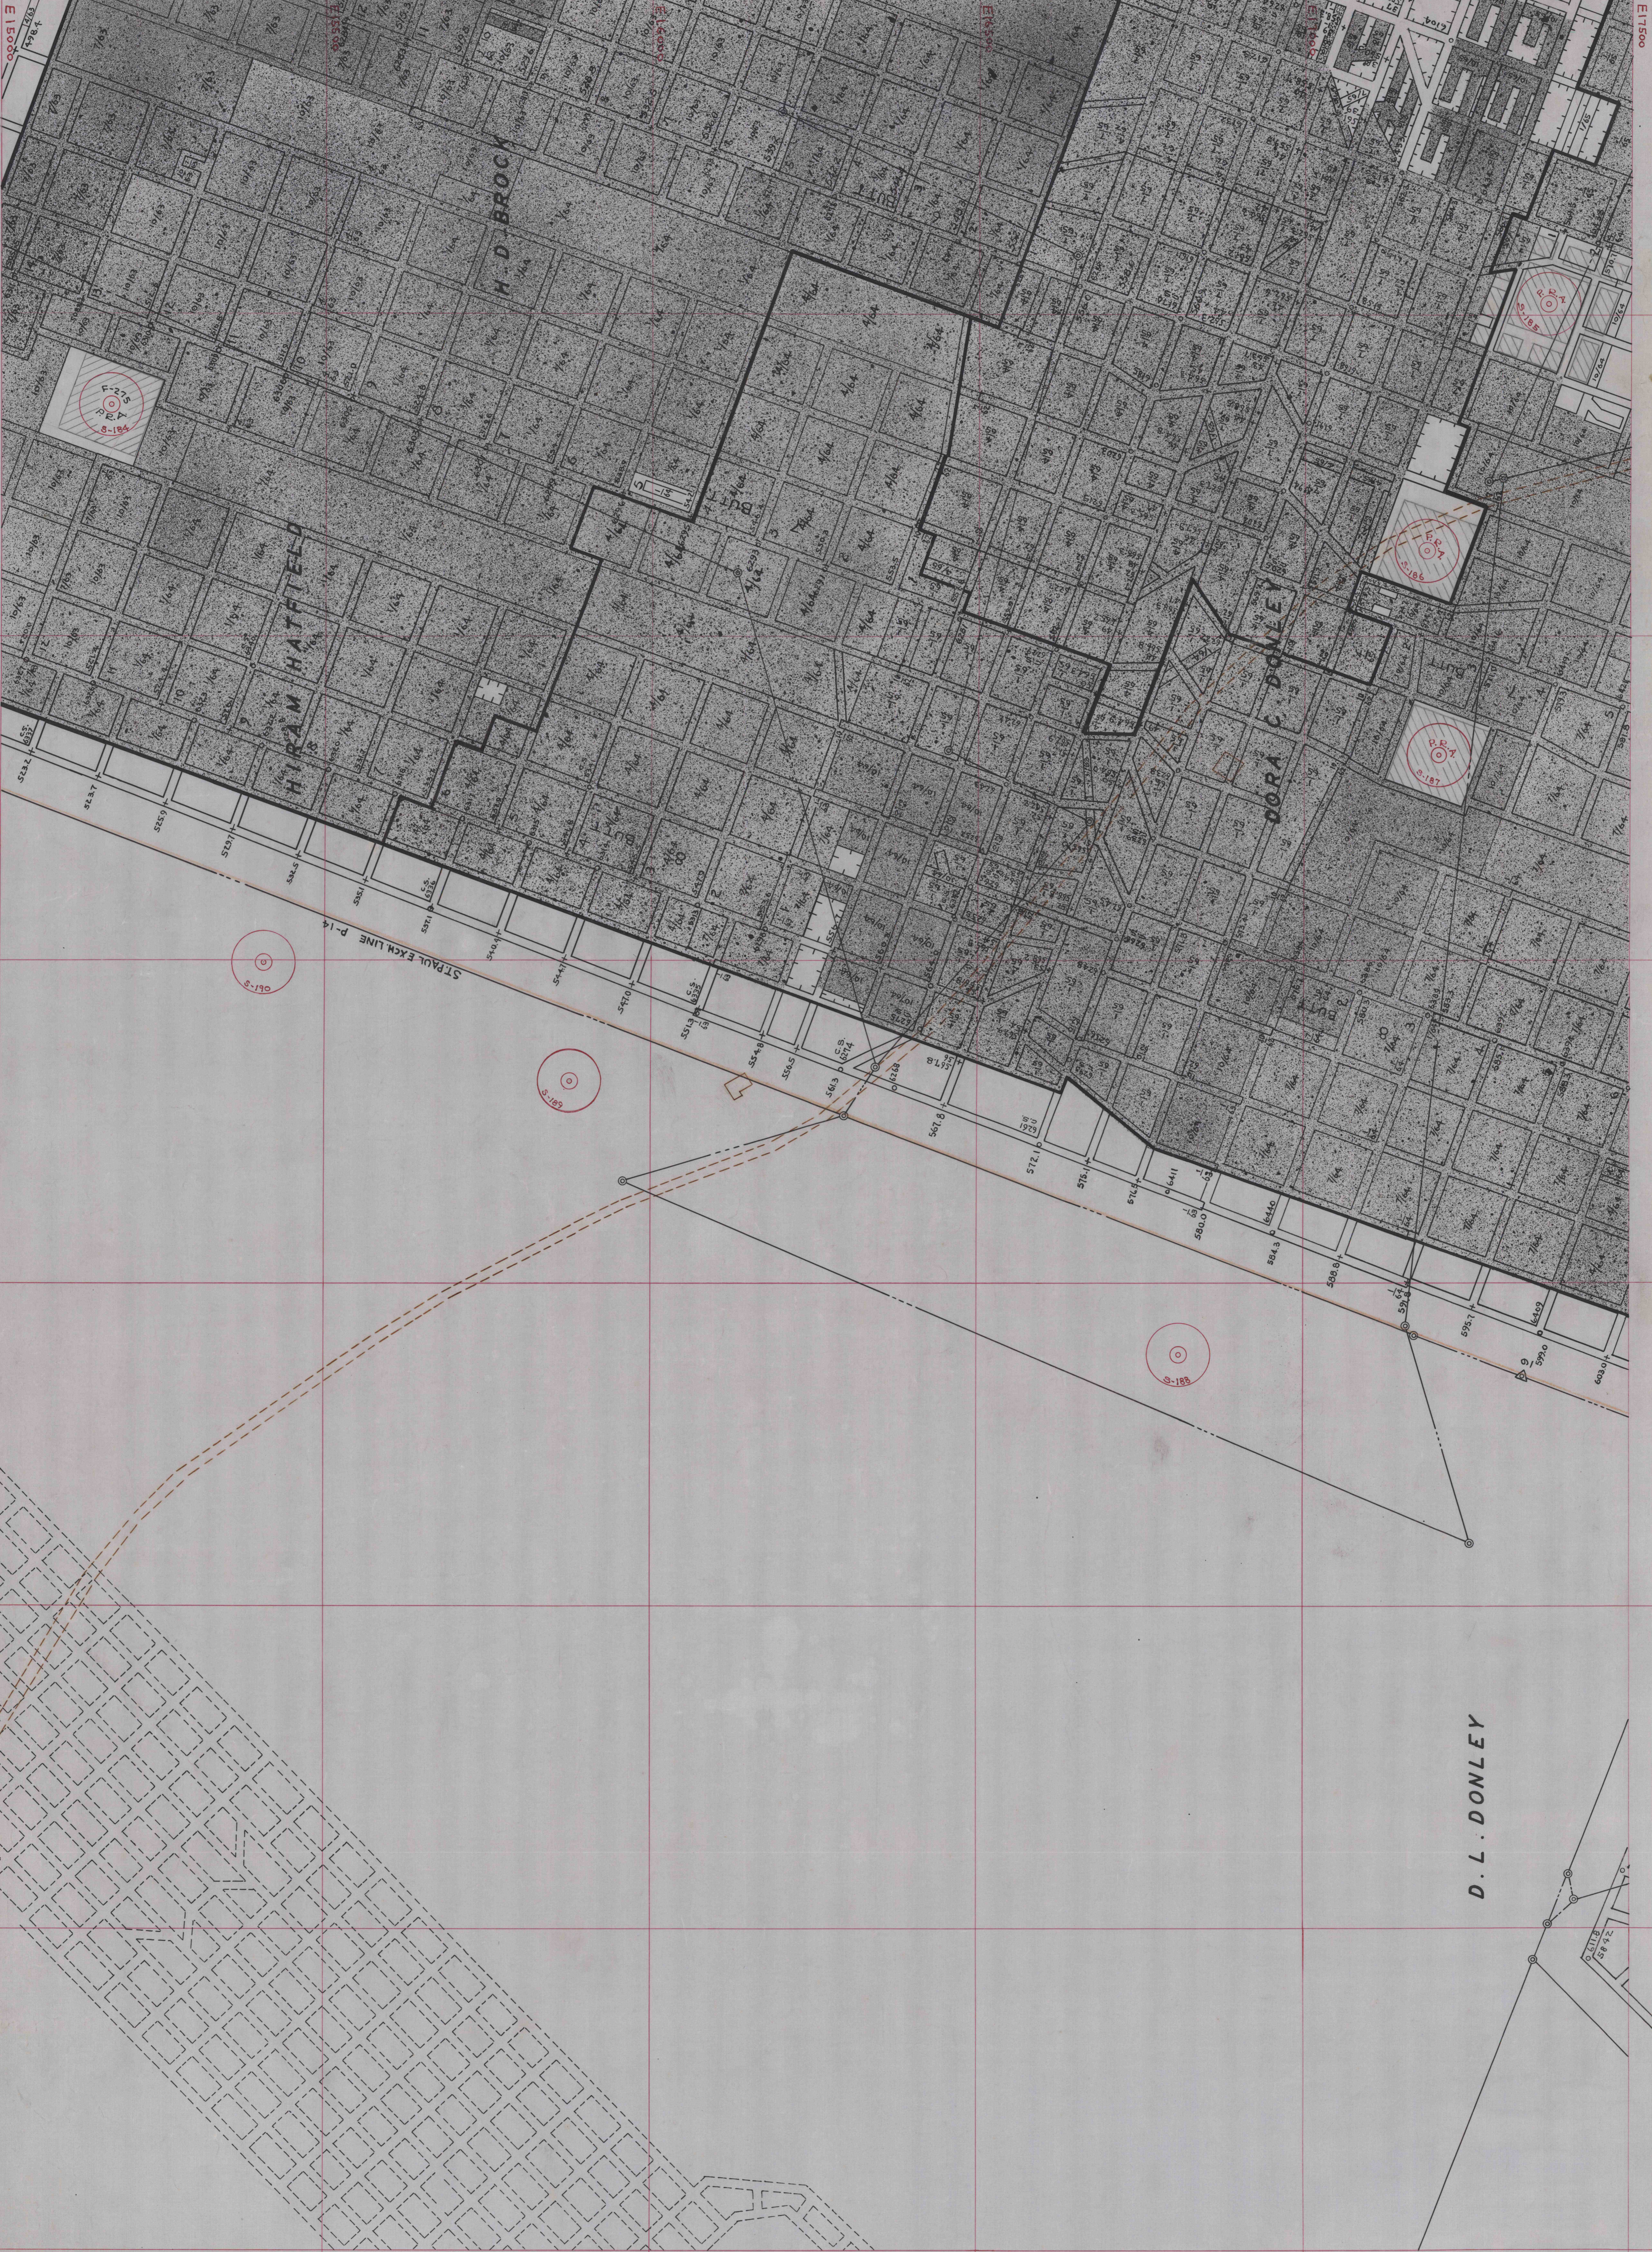

SEC. No 9
245

SEC. No 9
245

D. L. DONLEY