


SEC. No 9  
244

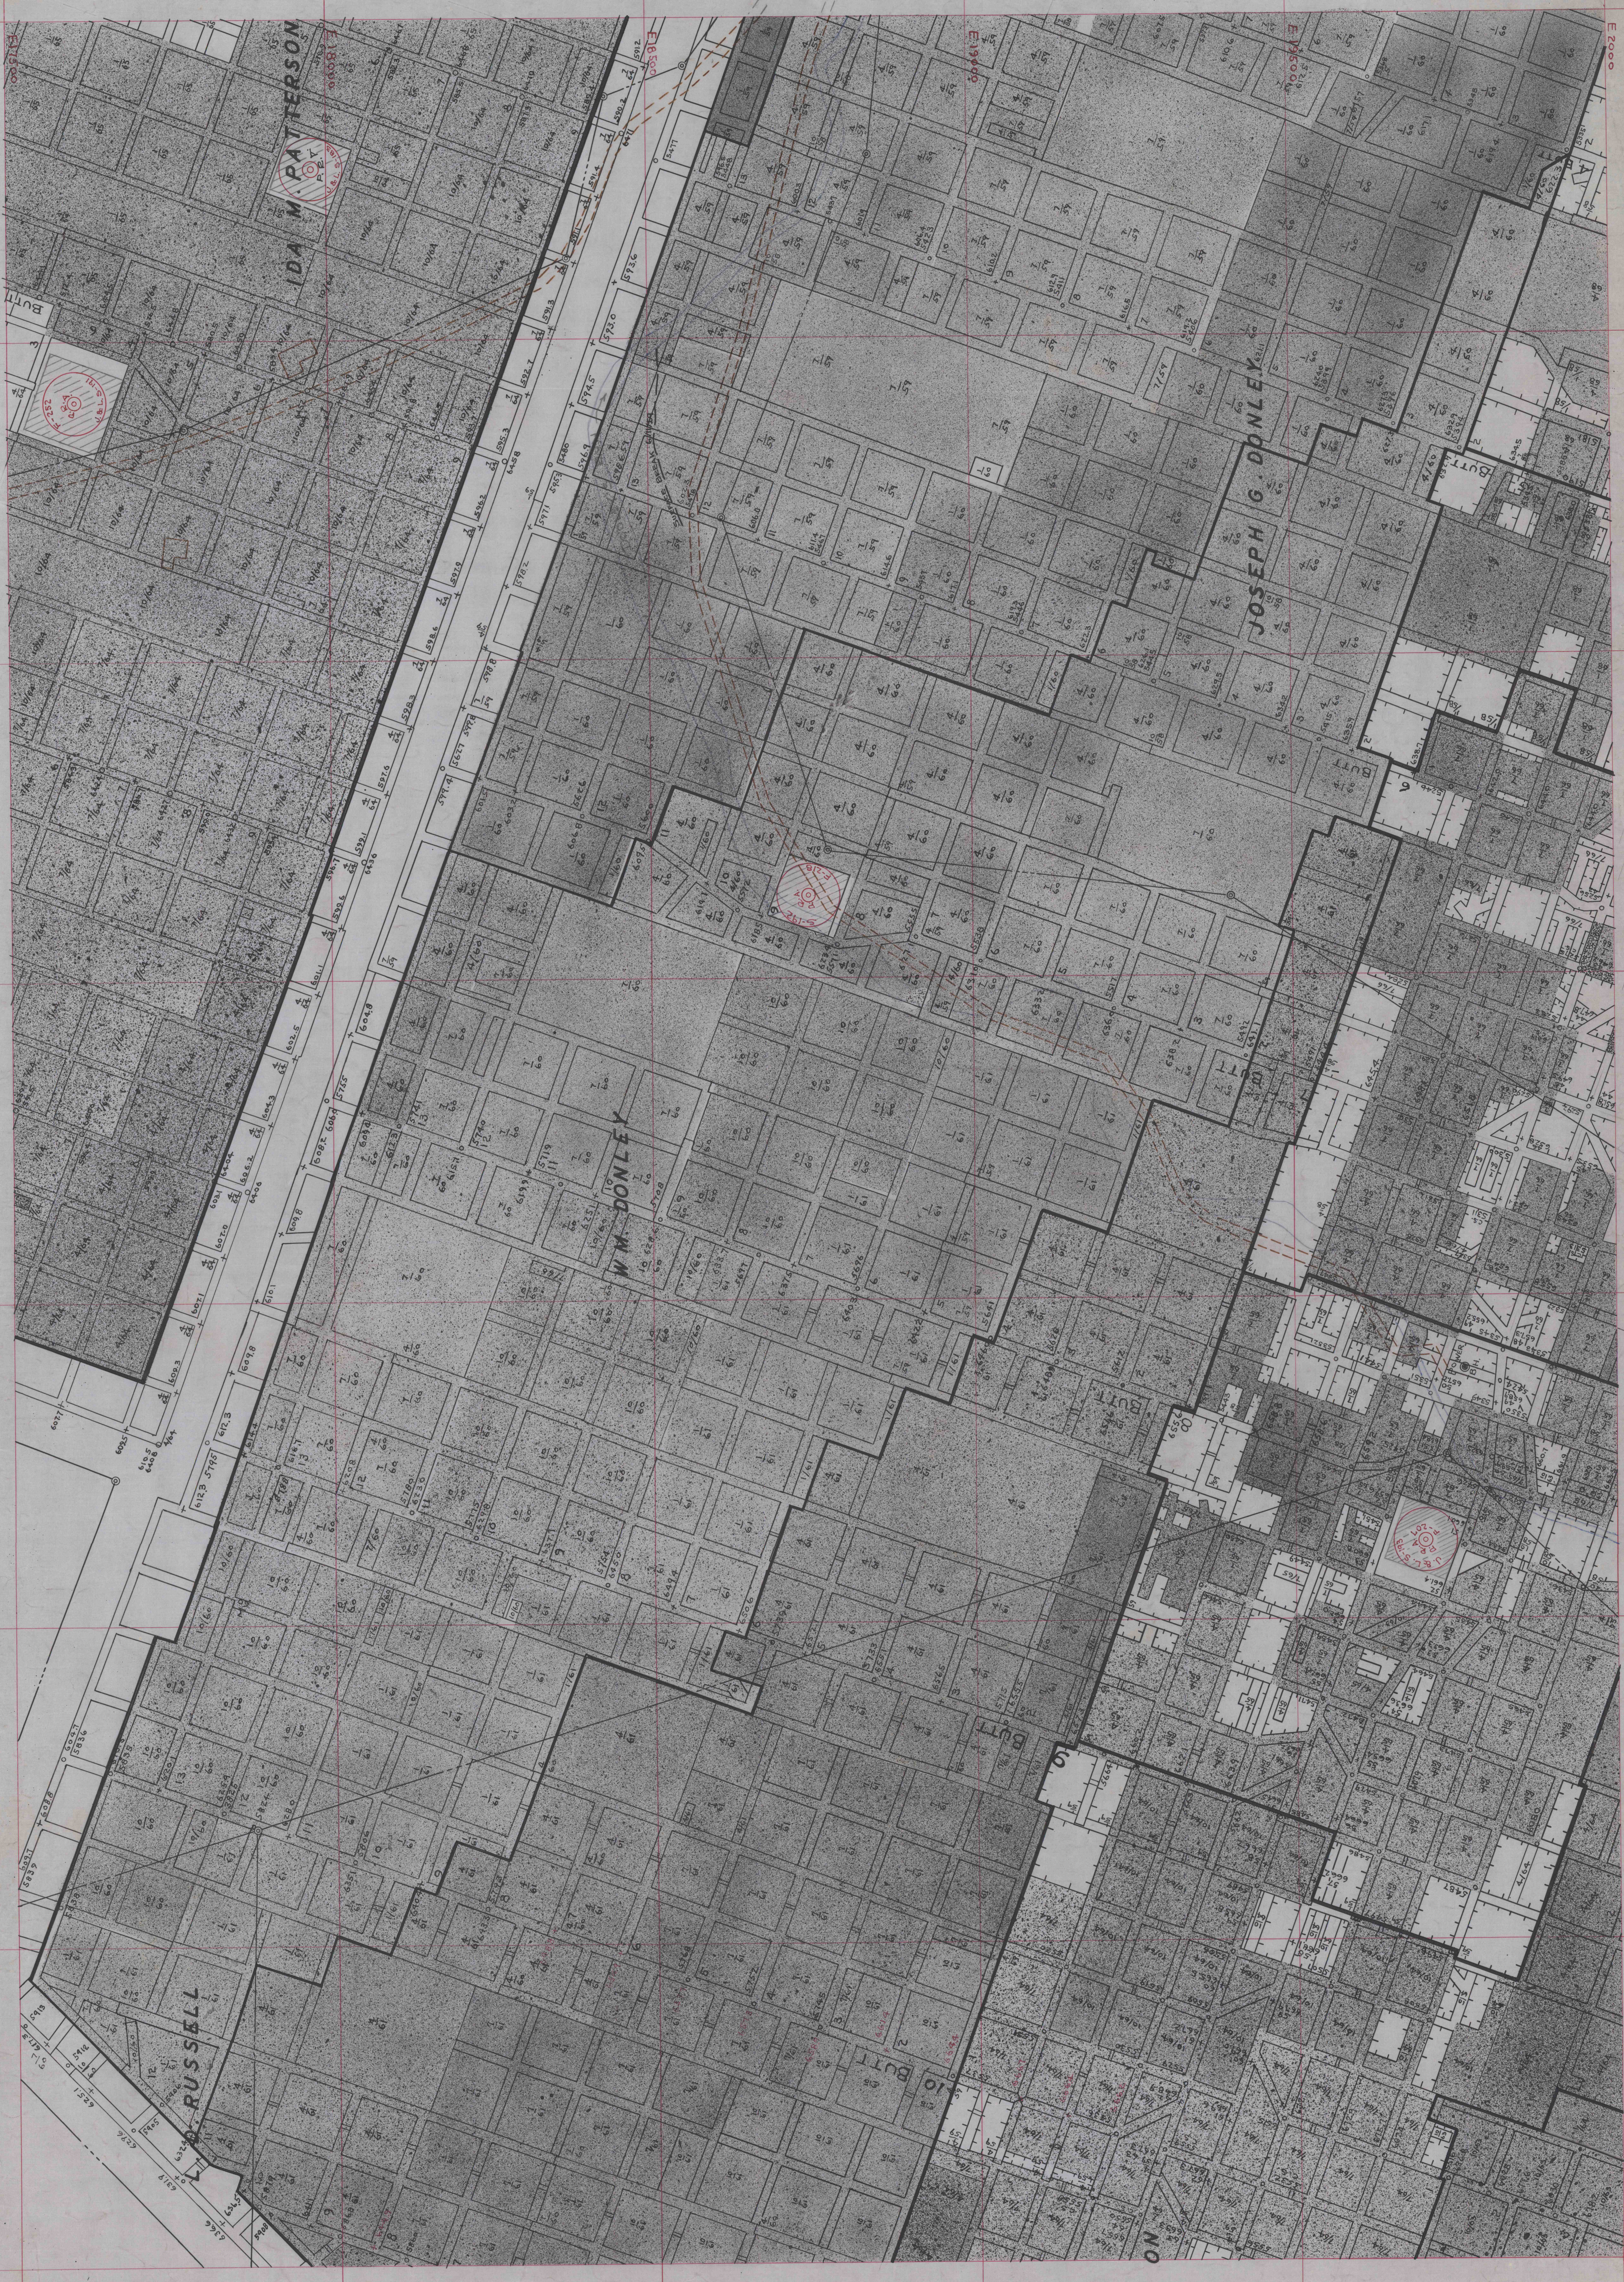

N35000  
E0002  
SEC. No 9  
244  
N34500  
N34000  
5 FLAT PAR.  
5 FLAT LT.  
N33500  
N33000  
N32500  
N32000  
N31500