


N 39000

N 40000

1 41000

N 42000

PAR
9
FLAT

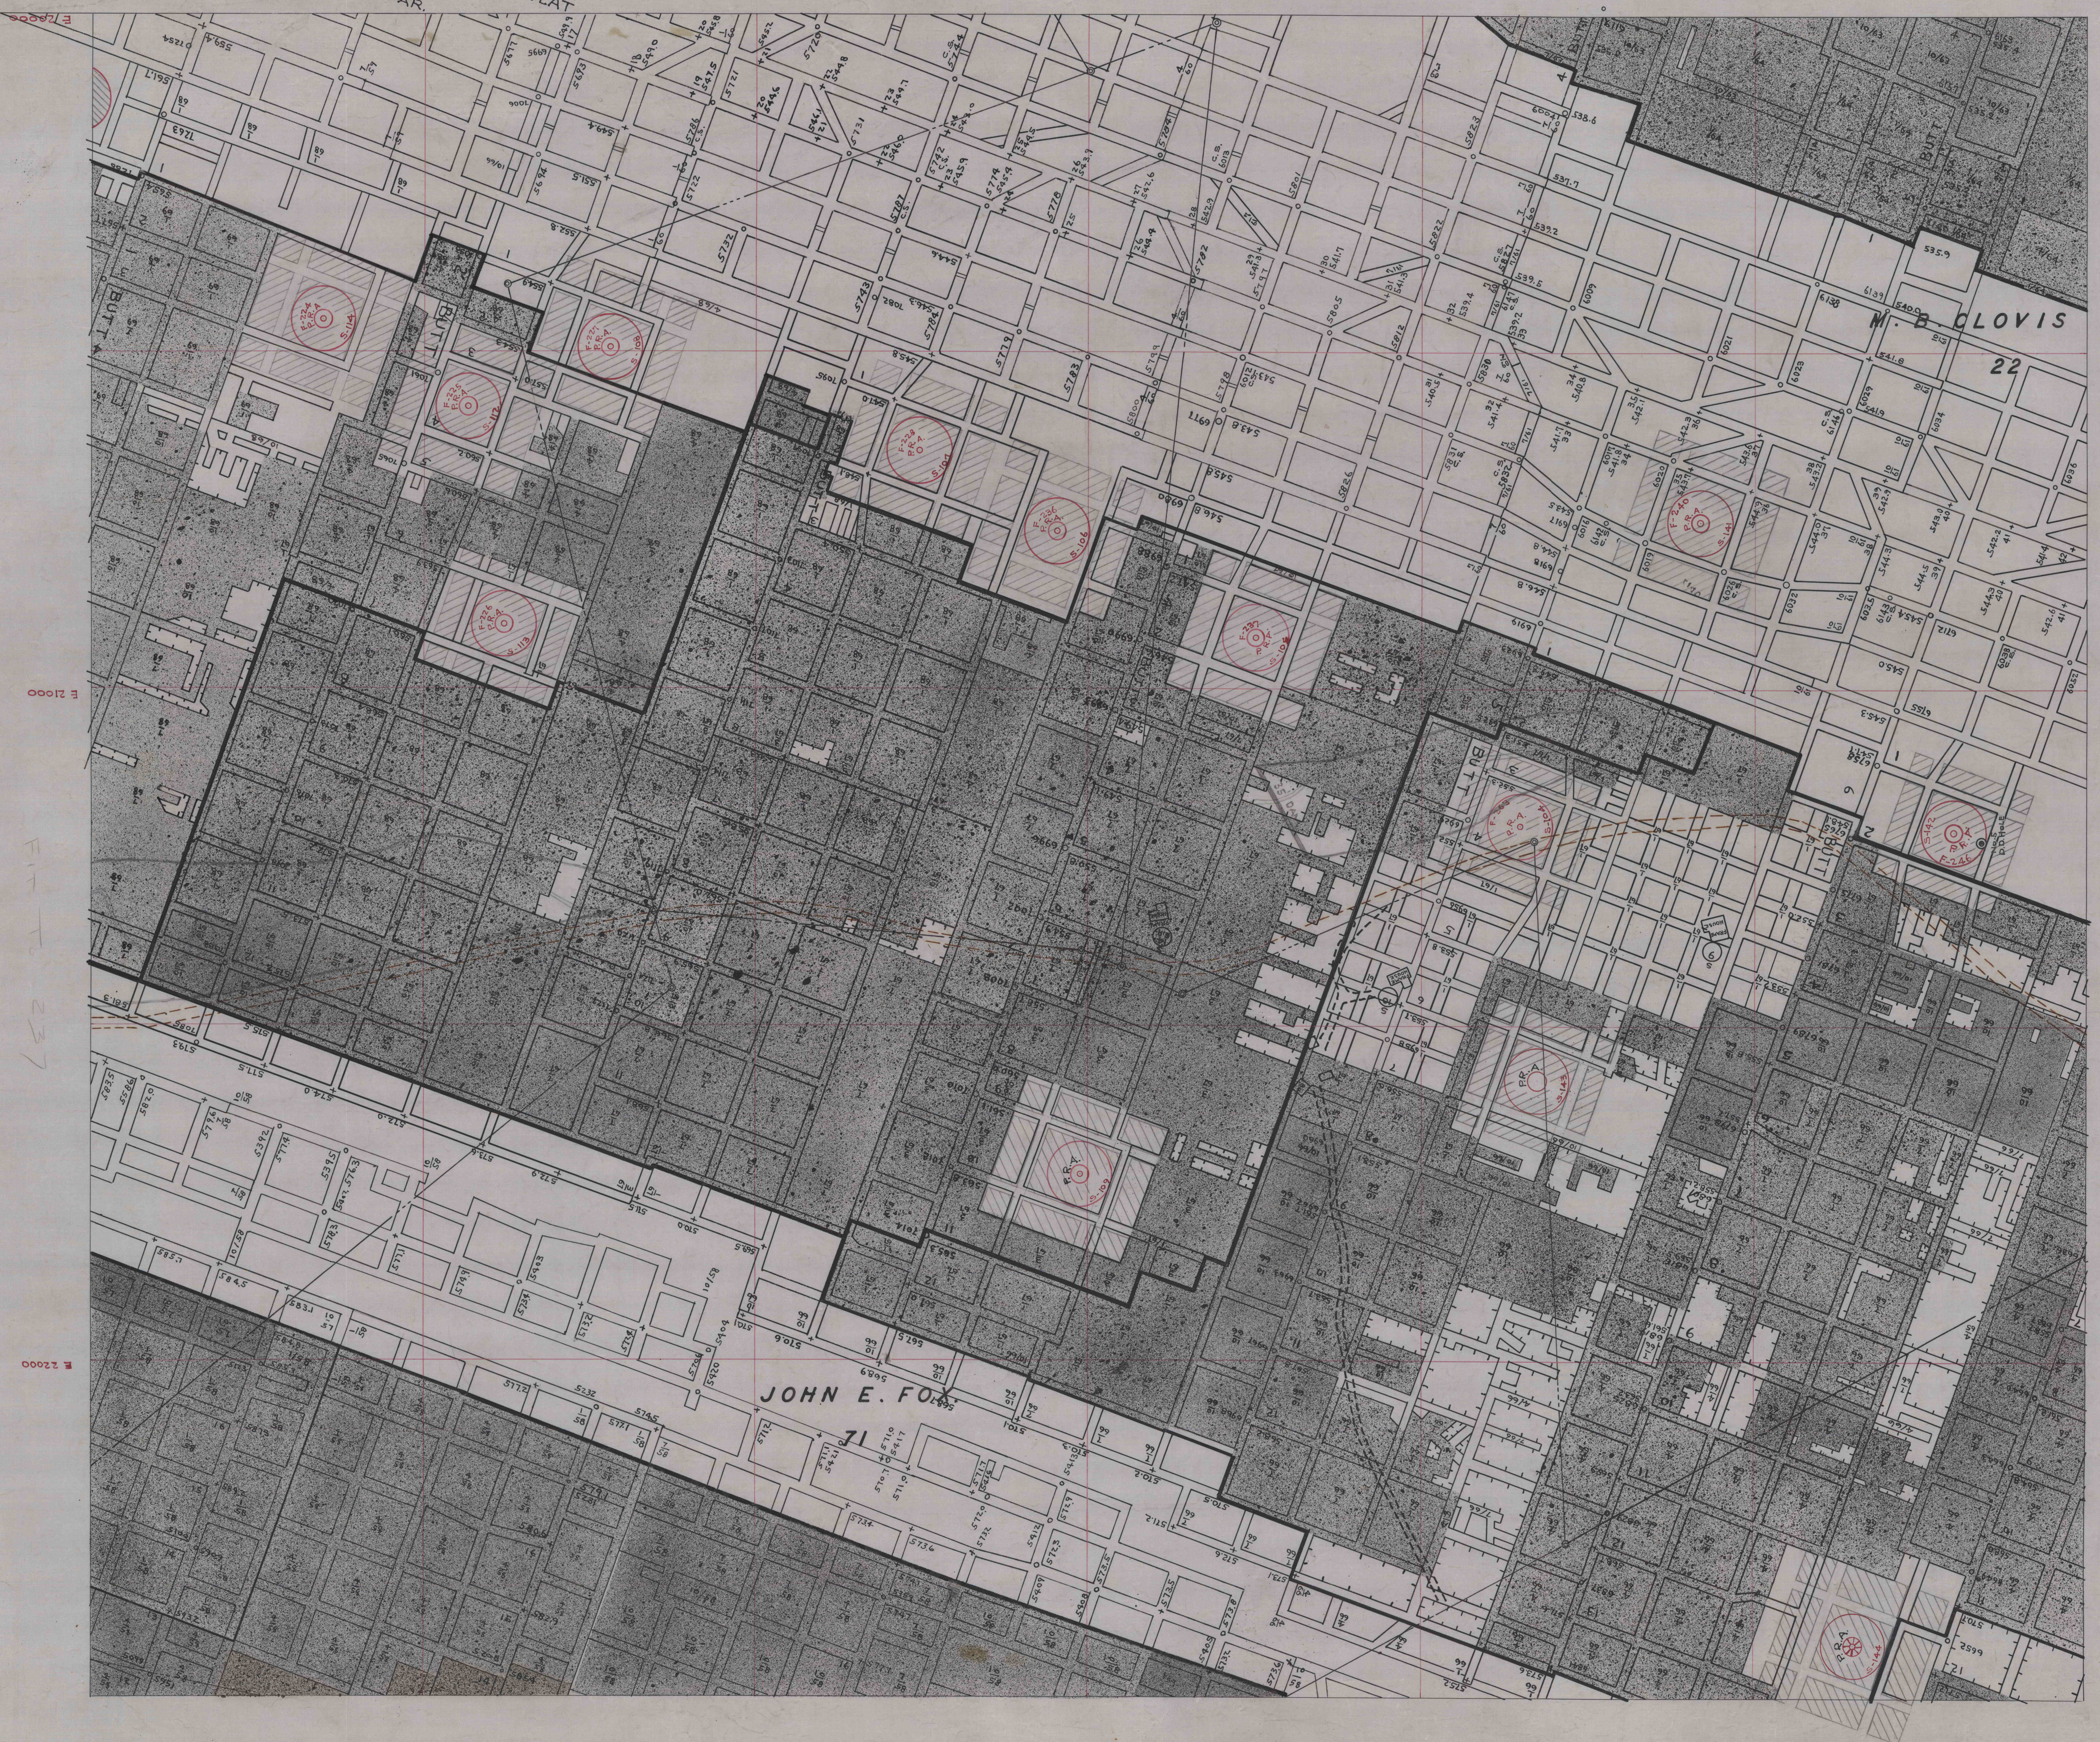

E 21000

E 22000