

MATCH TO SHEET 250

Sec. No. 7  
241

MATCH TO SHEET 242



THOS. B. STEELE

MATCH TO SHEET 252

SEC. No. 7  
241

WM. McCURE

MATCH TO SHEET 236

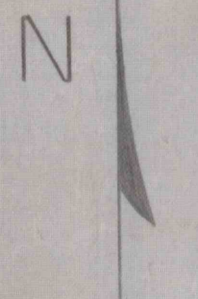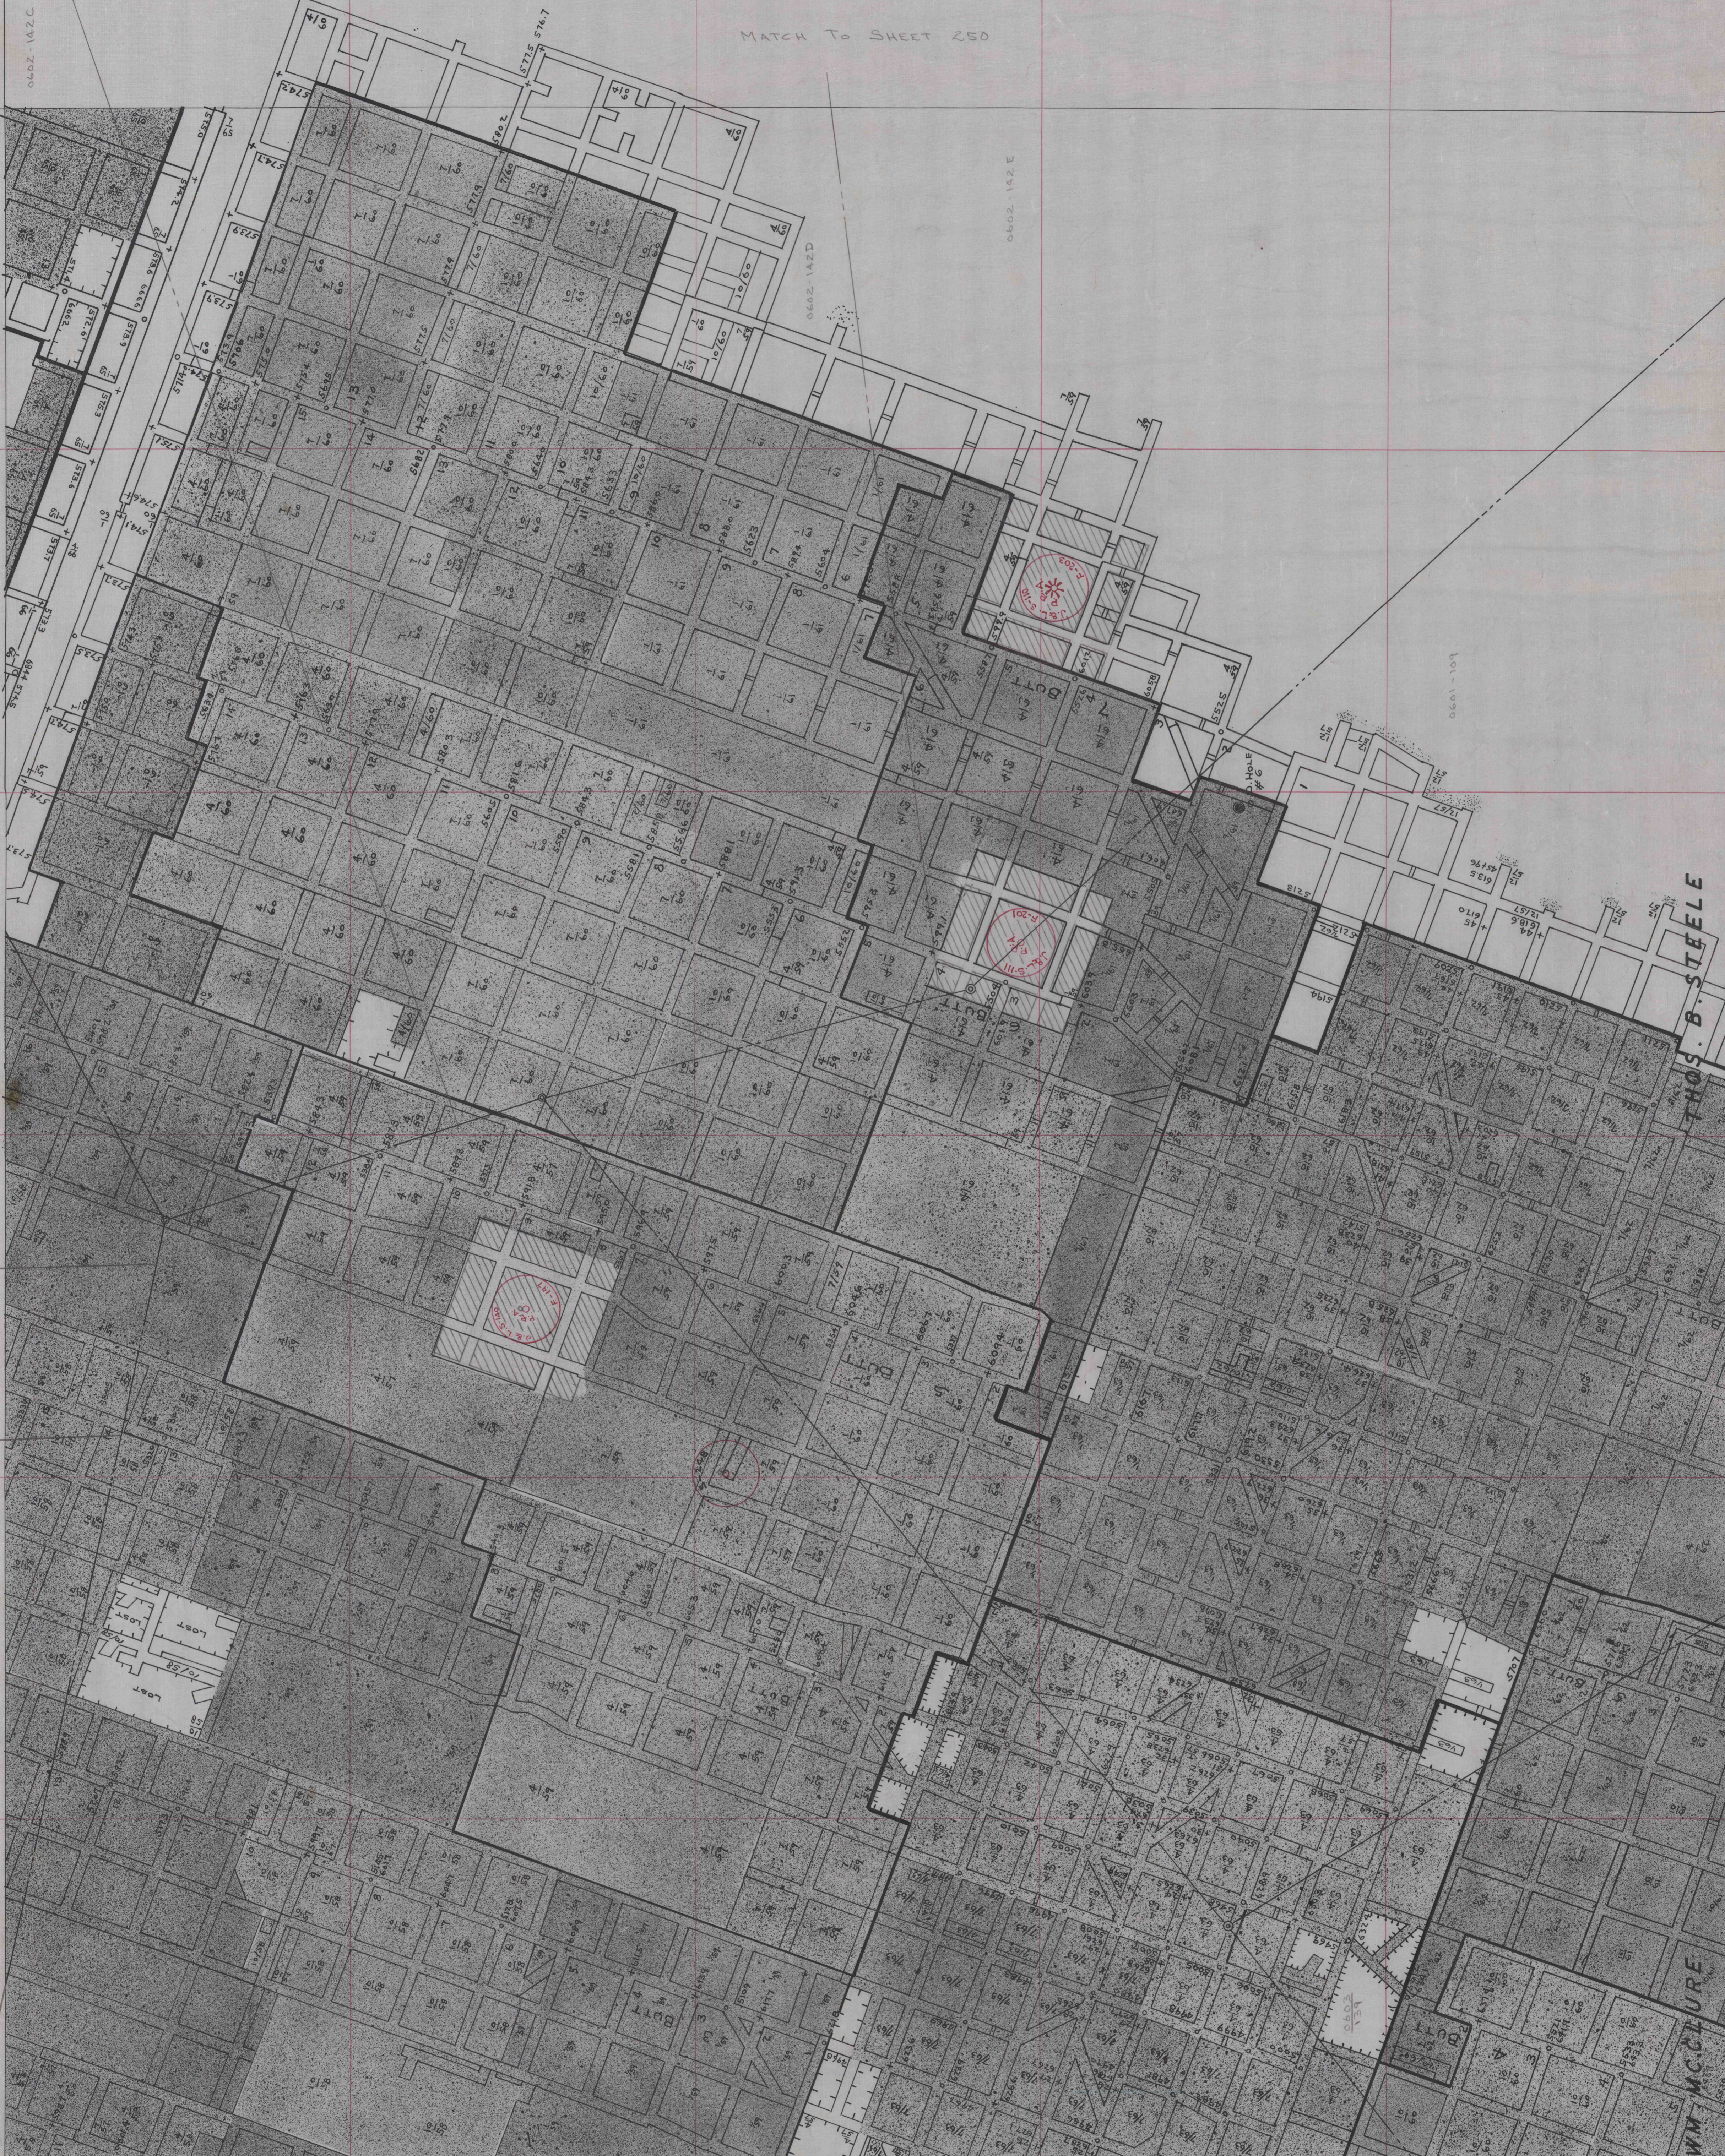

E 23,000

E 24,000

E 25,000

0603-1015B

0901-5090

1431-5090

0602-142C

0572-576.7

0602-142D

0602-142E

0601-109

N 42,000

N 41,000

N 40,000

N 39,000