


01 11T

FIT TO

FIT TO K-5560

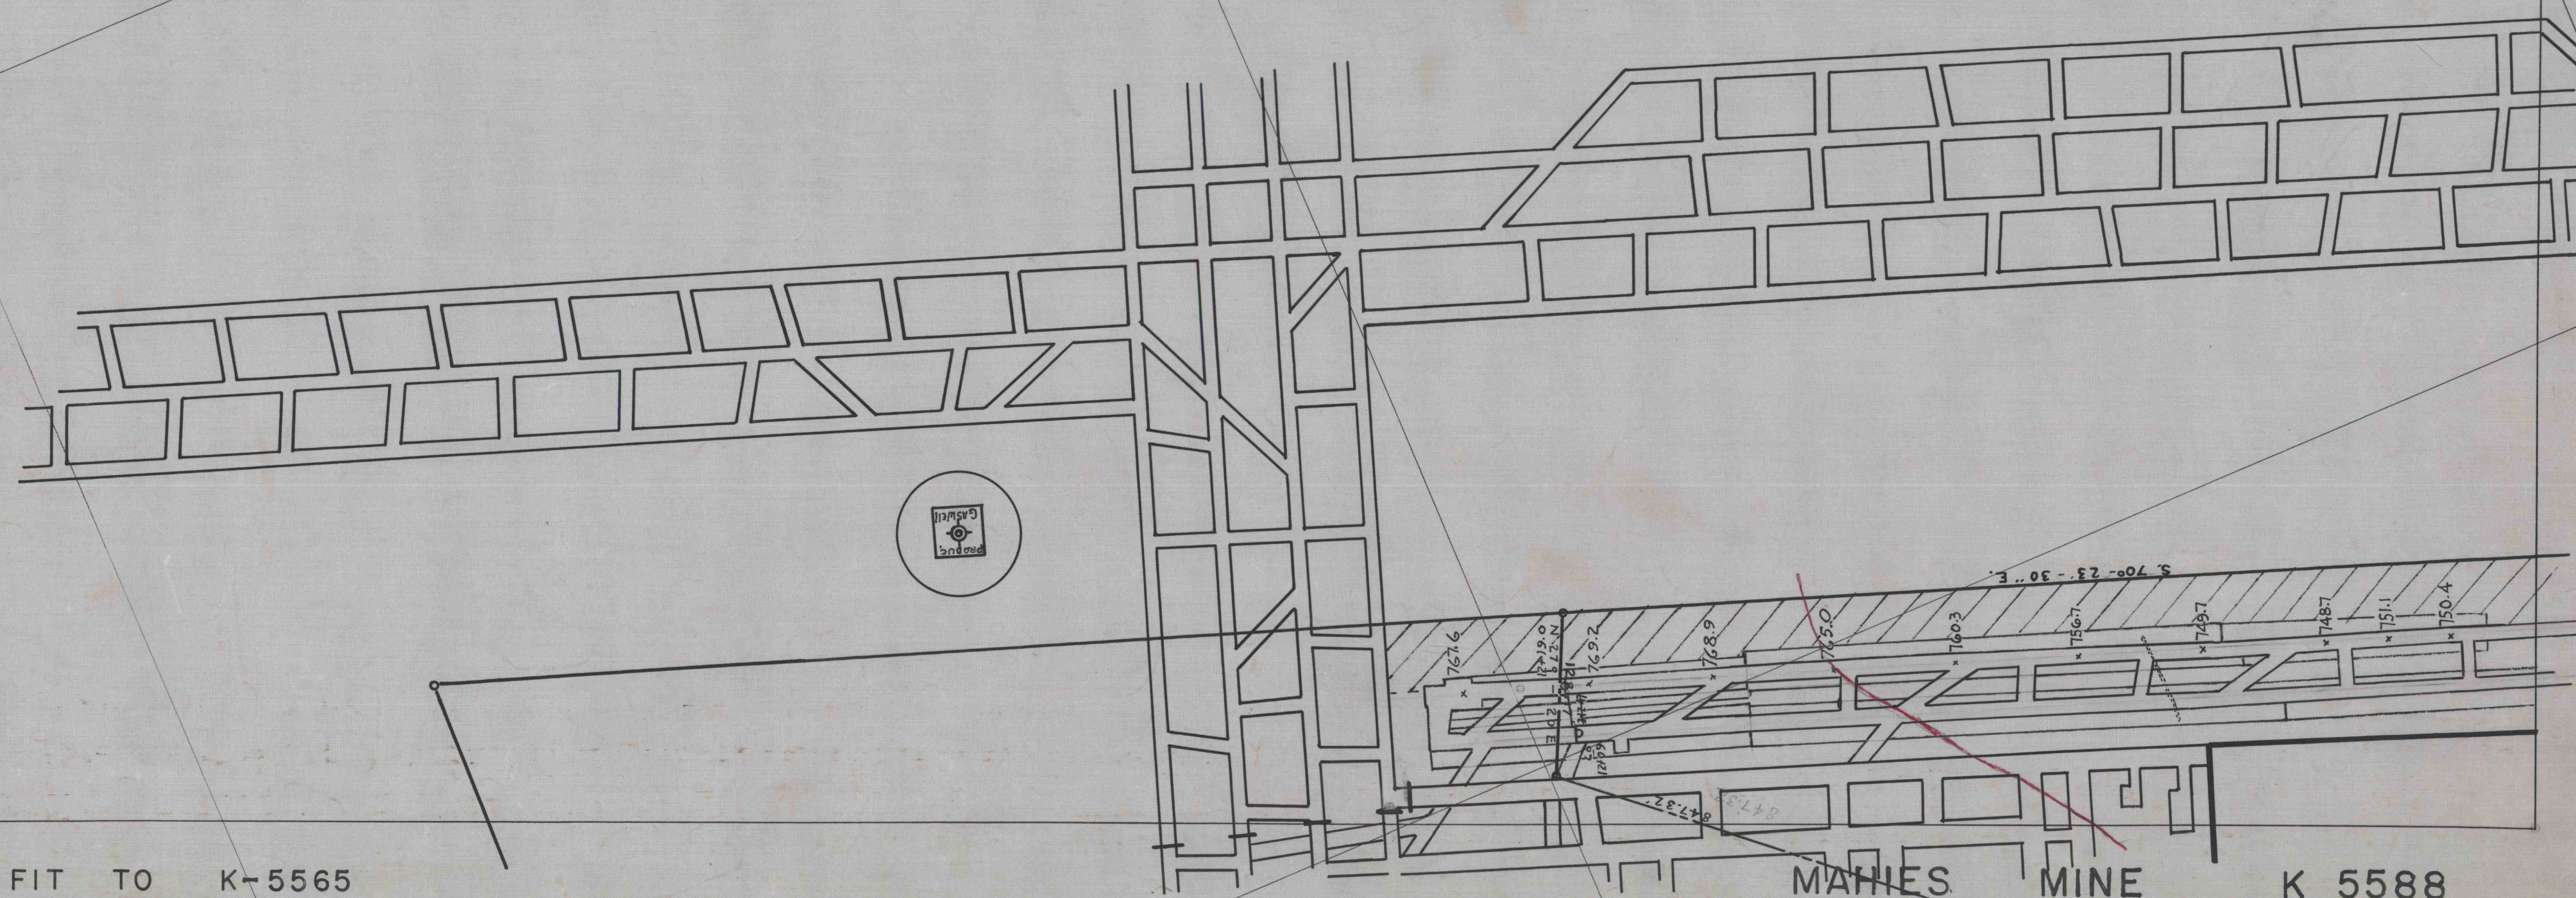

FIT TO K-5565

MAHES MINE K 5588