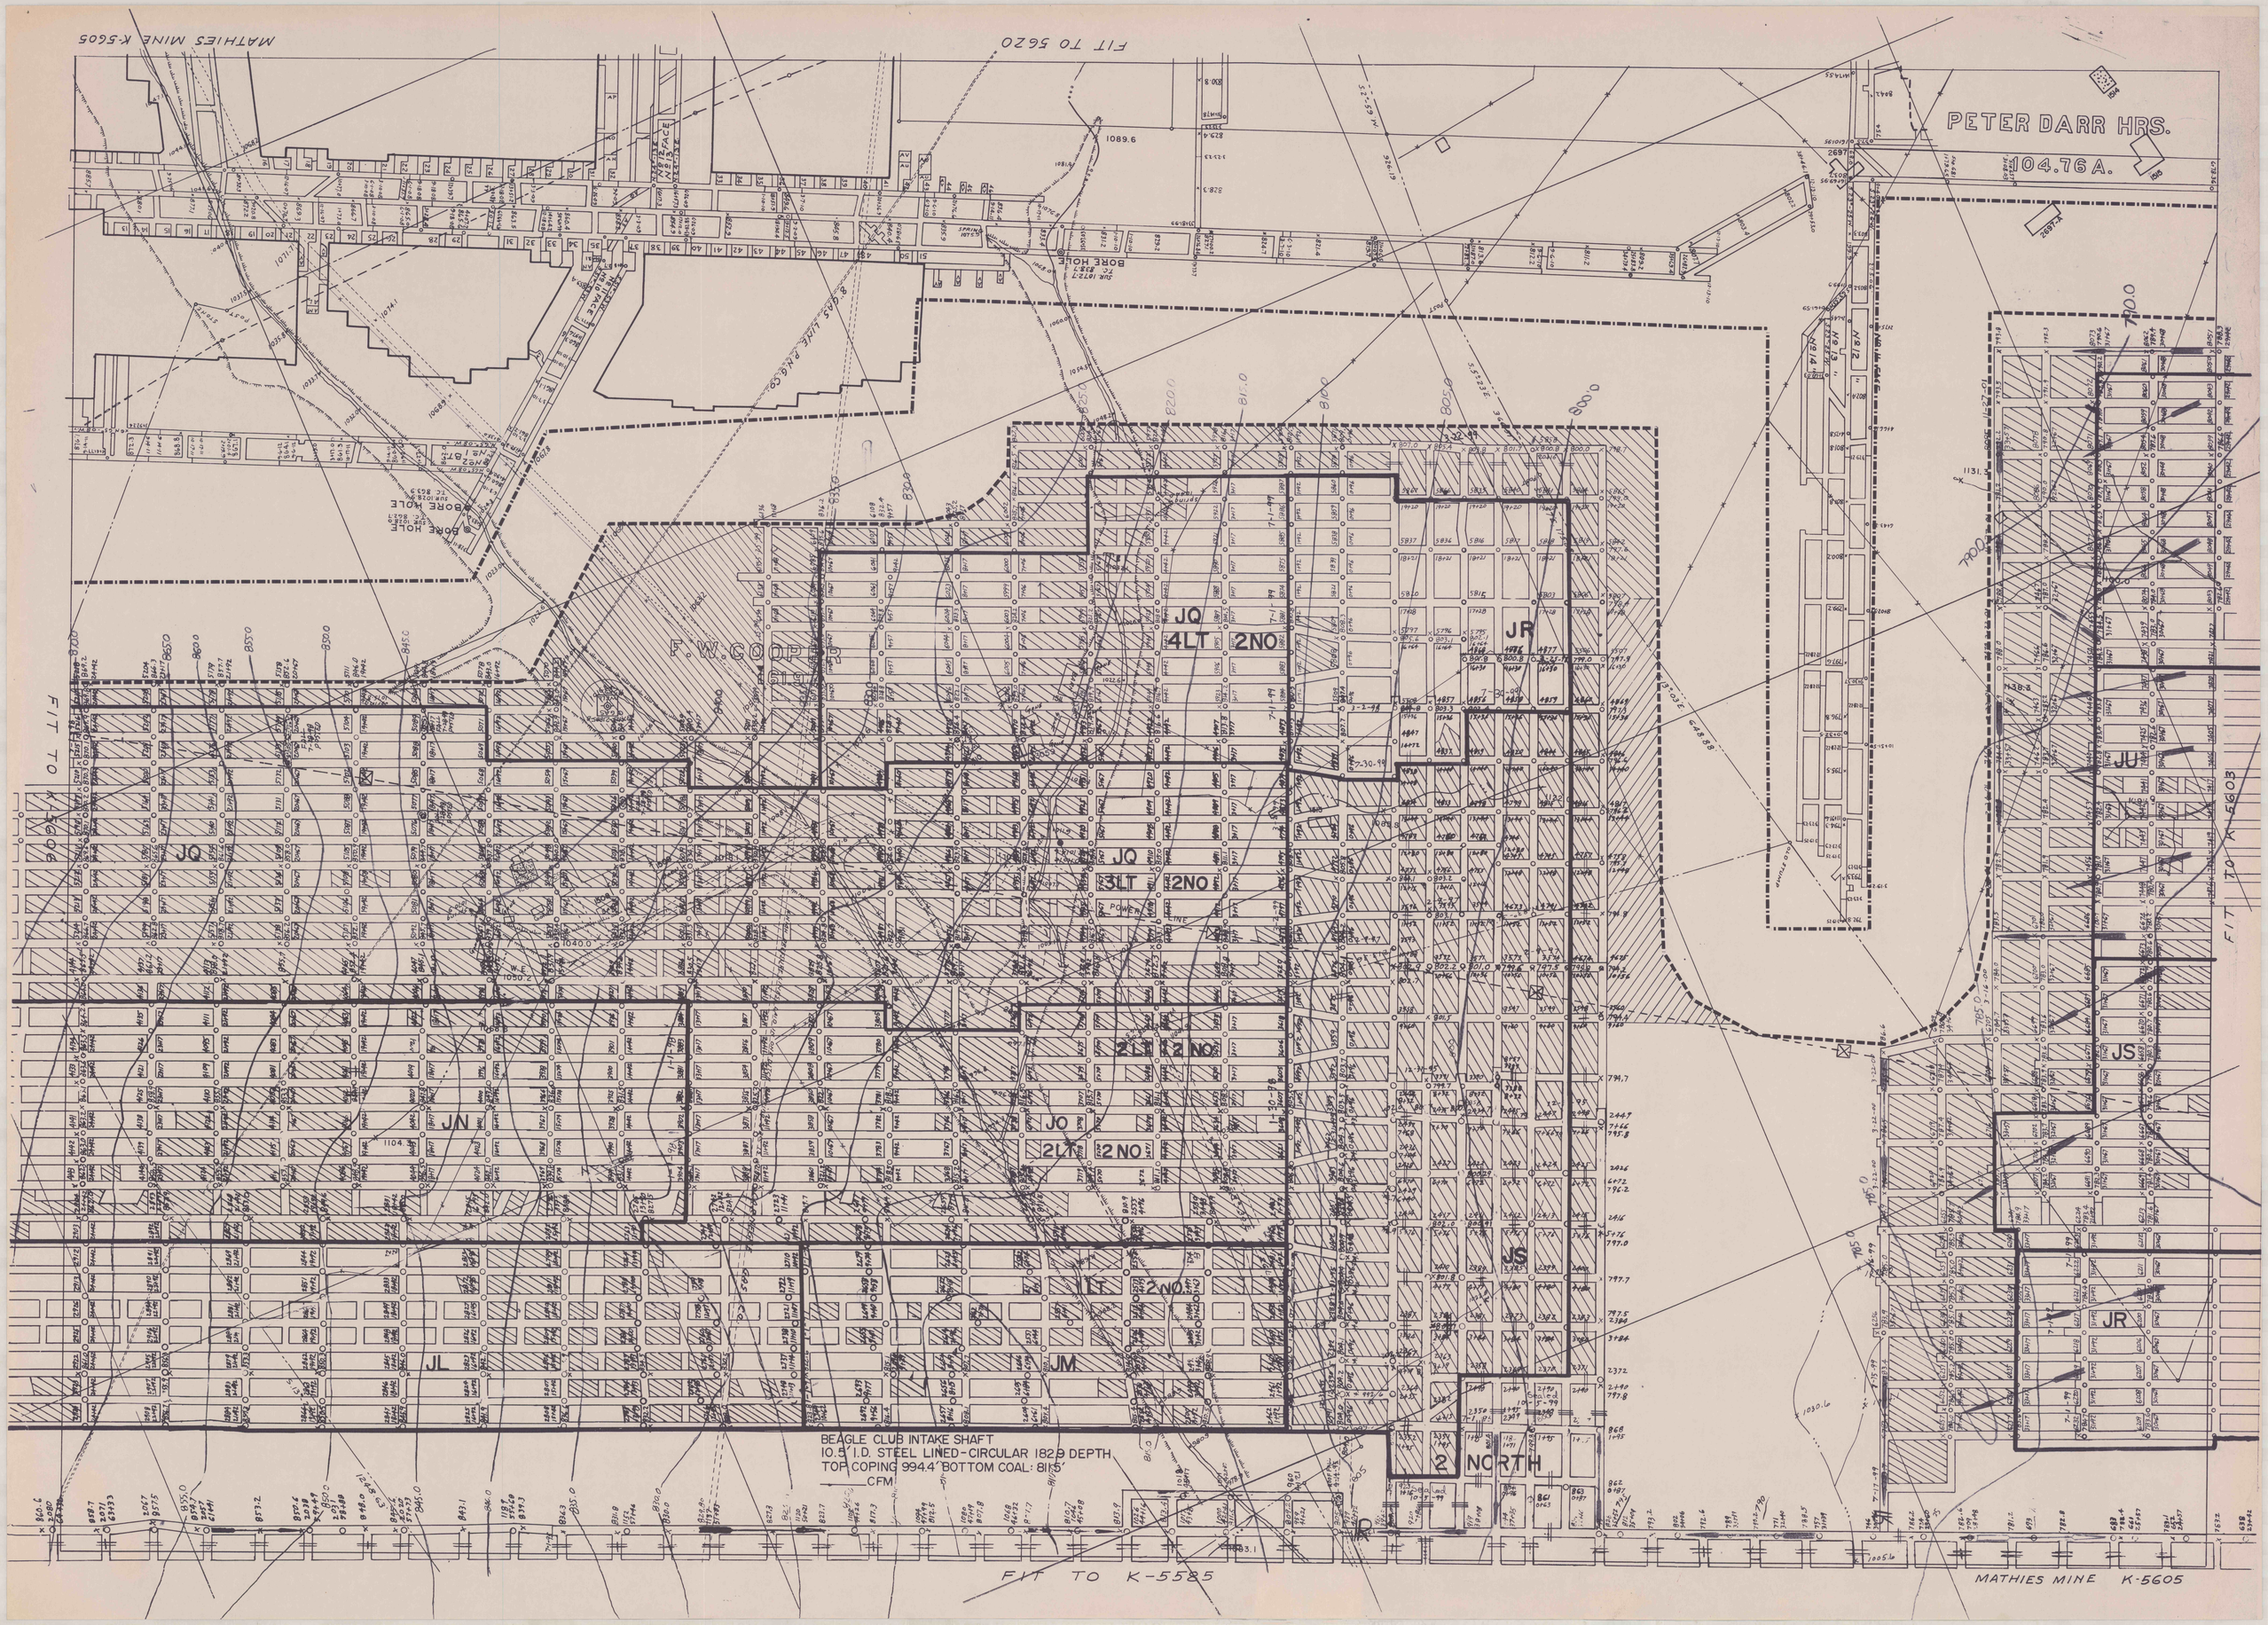

MATHIES MINE K-5605
FIT TO 5620
PETER DARR HRS.
104.76 A.
BORE HOLE
F. W. COOPER
JQ
4LT
2NO
JR
JQ
3LT
2NO
JQ
2LT
2NO
JN
JQ
2LT
2NO
JS
1LT
2NO
JL
JM
JS
JR
JU
2 NORTH
FIT TO K-5606
FIT TO K-5603
BEAGLE CLUB INTAKE SHAFT
10.5' I.D. STEEL LINED-CIRCULAR 182.9 DEPTH
TOP COPING 994.4' BOTTOM COAL: 811.5'
CFM
FIT TO K-5585
MATHIES MINE K-5605