


P.C. CO. TO M.R.C.C. & C. CO.
4.25 A PART OF T70.A.

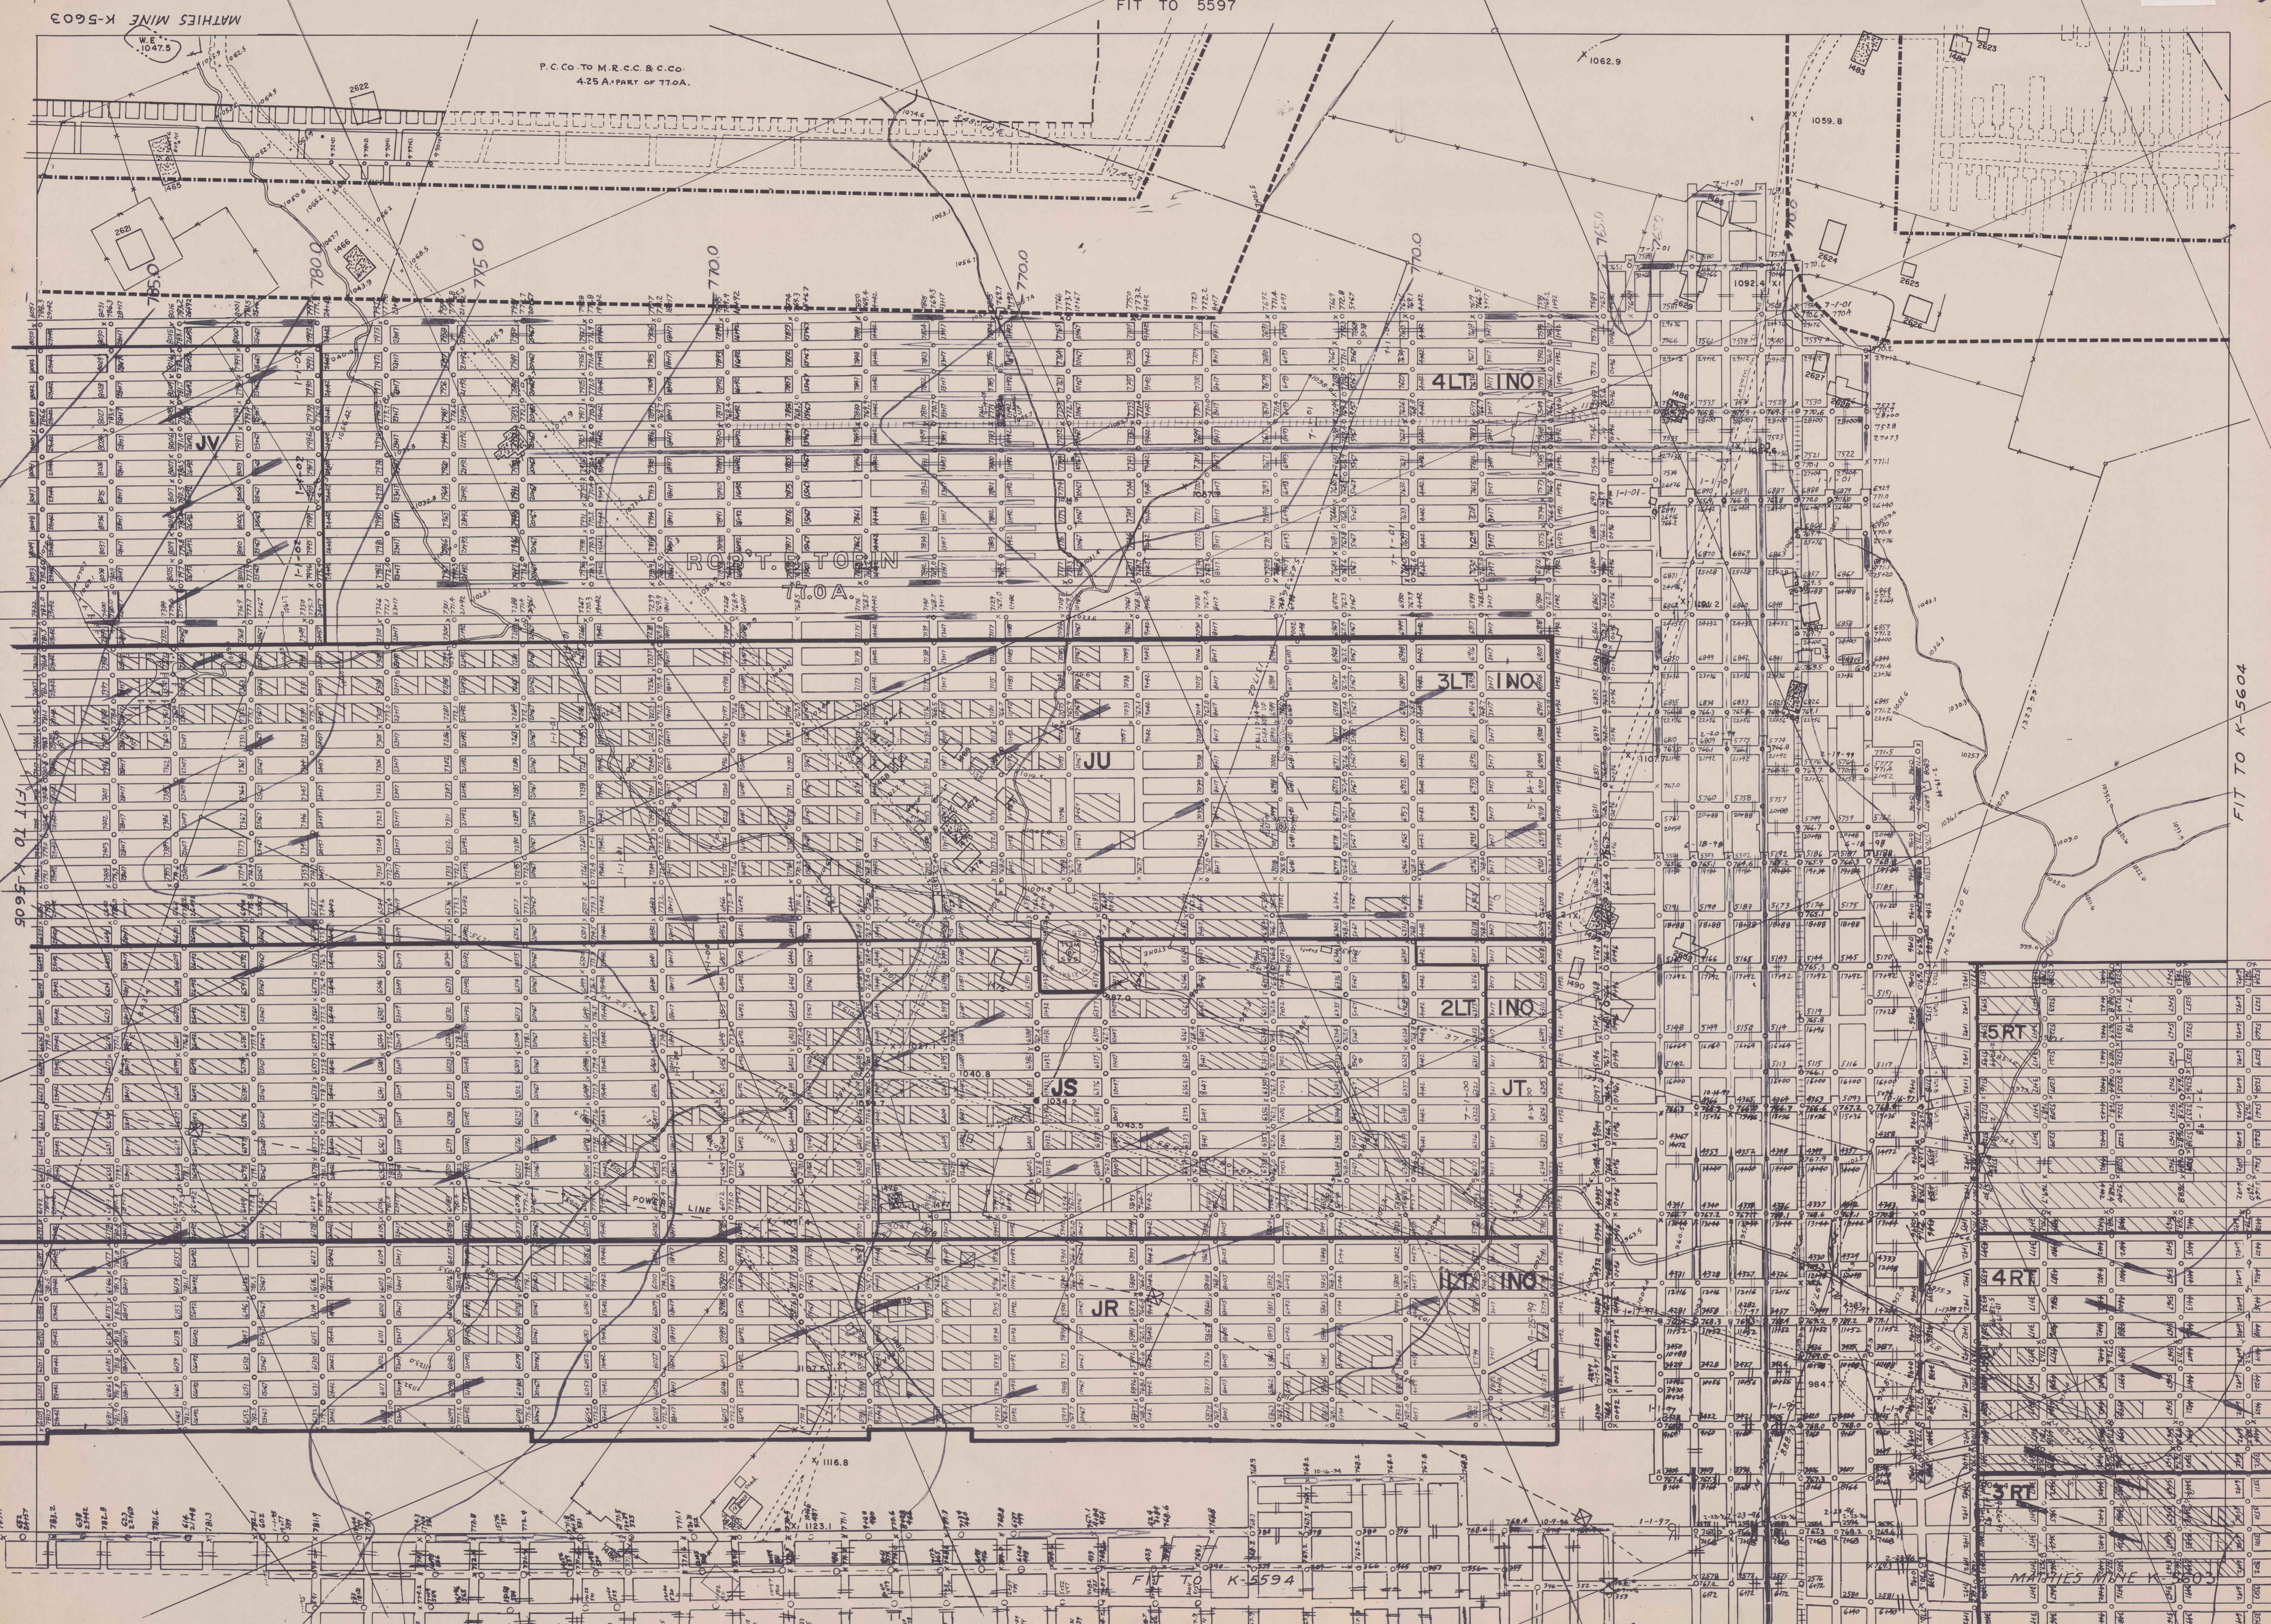

505
FIT TO

FIT TO K-5604