


NOTE:
CONCRETE SEALS

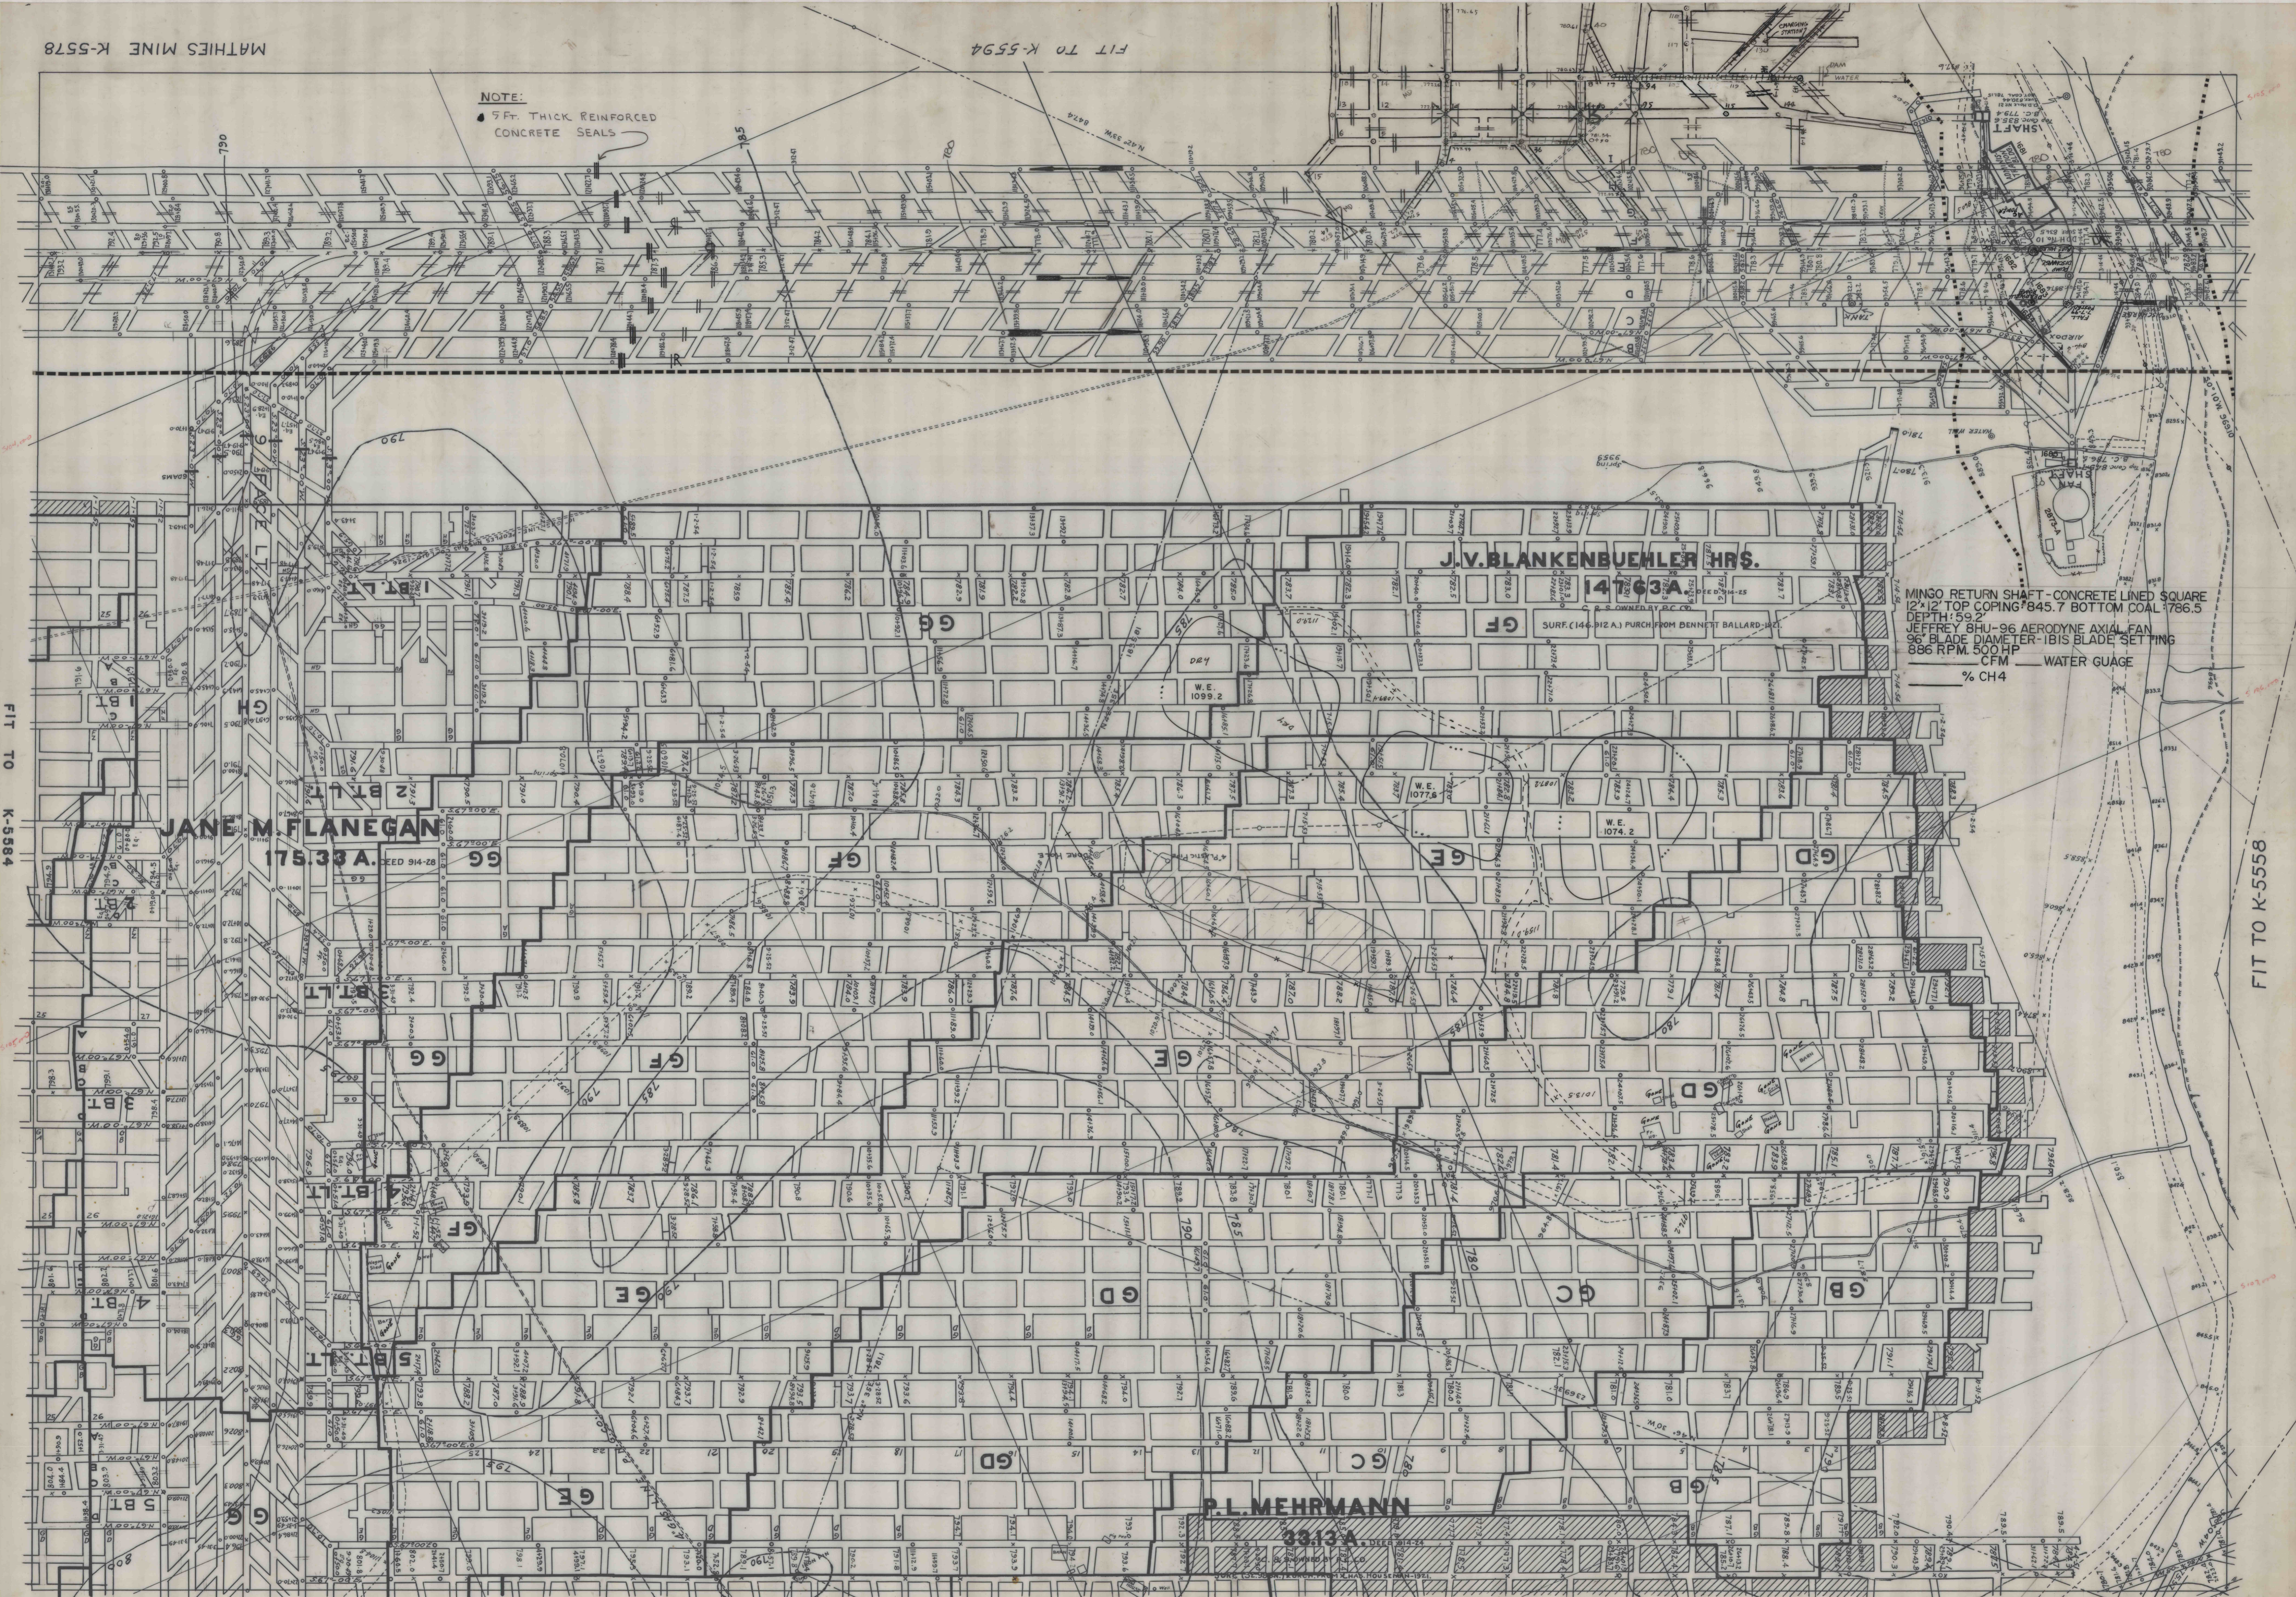

MINGO RETURN SHAFT - CONCRETE LINED SQUARE
12'x12' TOP COPING 845.7 BOTTOM COAL 786.5
DEPTH 59.2'
JEFFREY 8HJ-96 AERODYNE AXIAL FAN
96" BLADE DIAMETER - IBIS BLADE SETTING
886 RPM 500 HP
CFM WATER GAUGE
% CH 4