


FIT TO K-5557

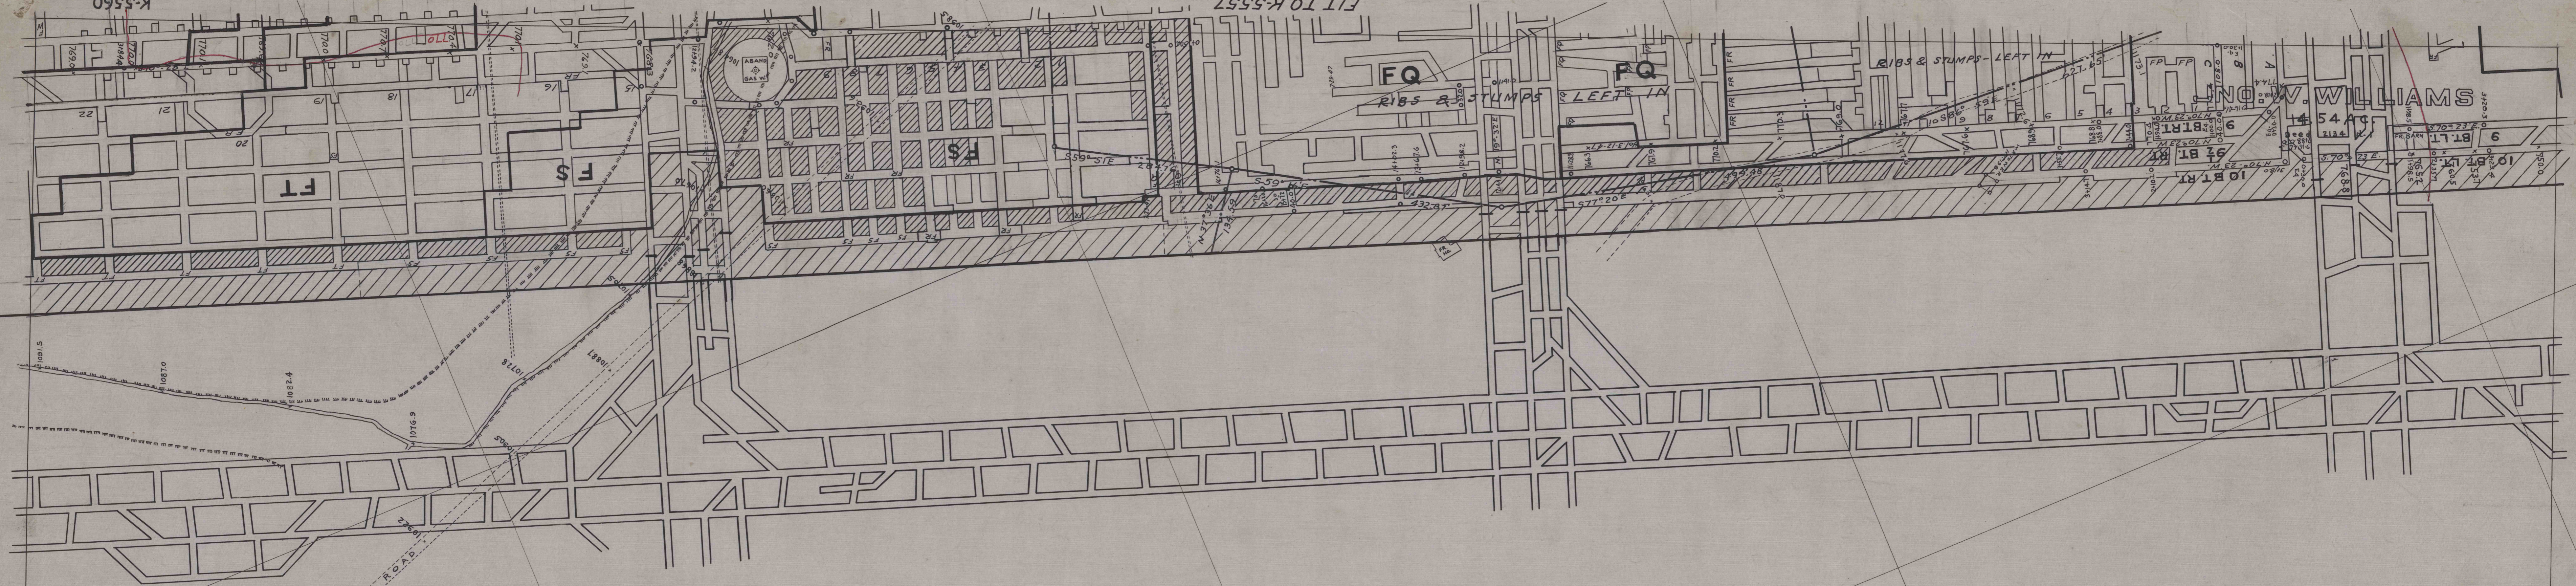

FIT TO K-5559

FIT TO K-5588