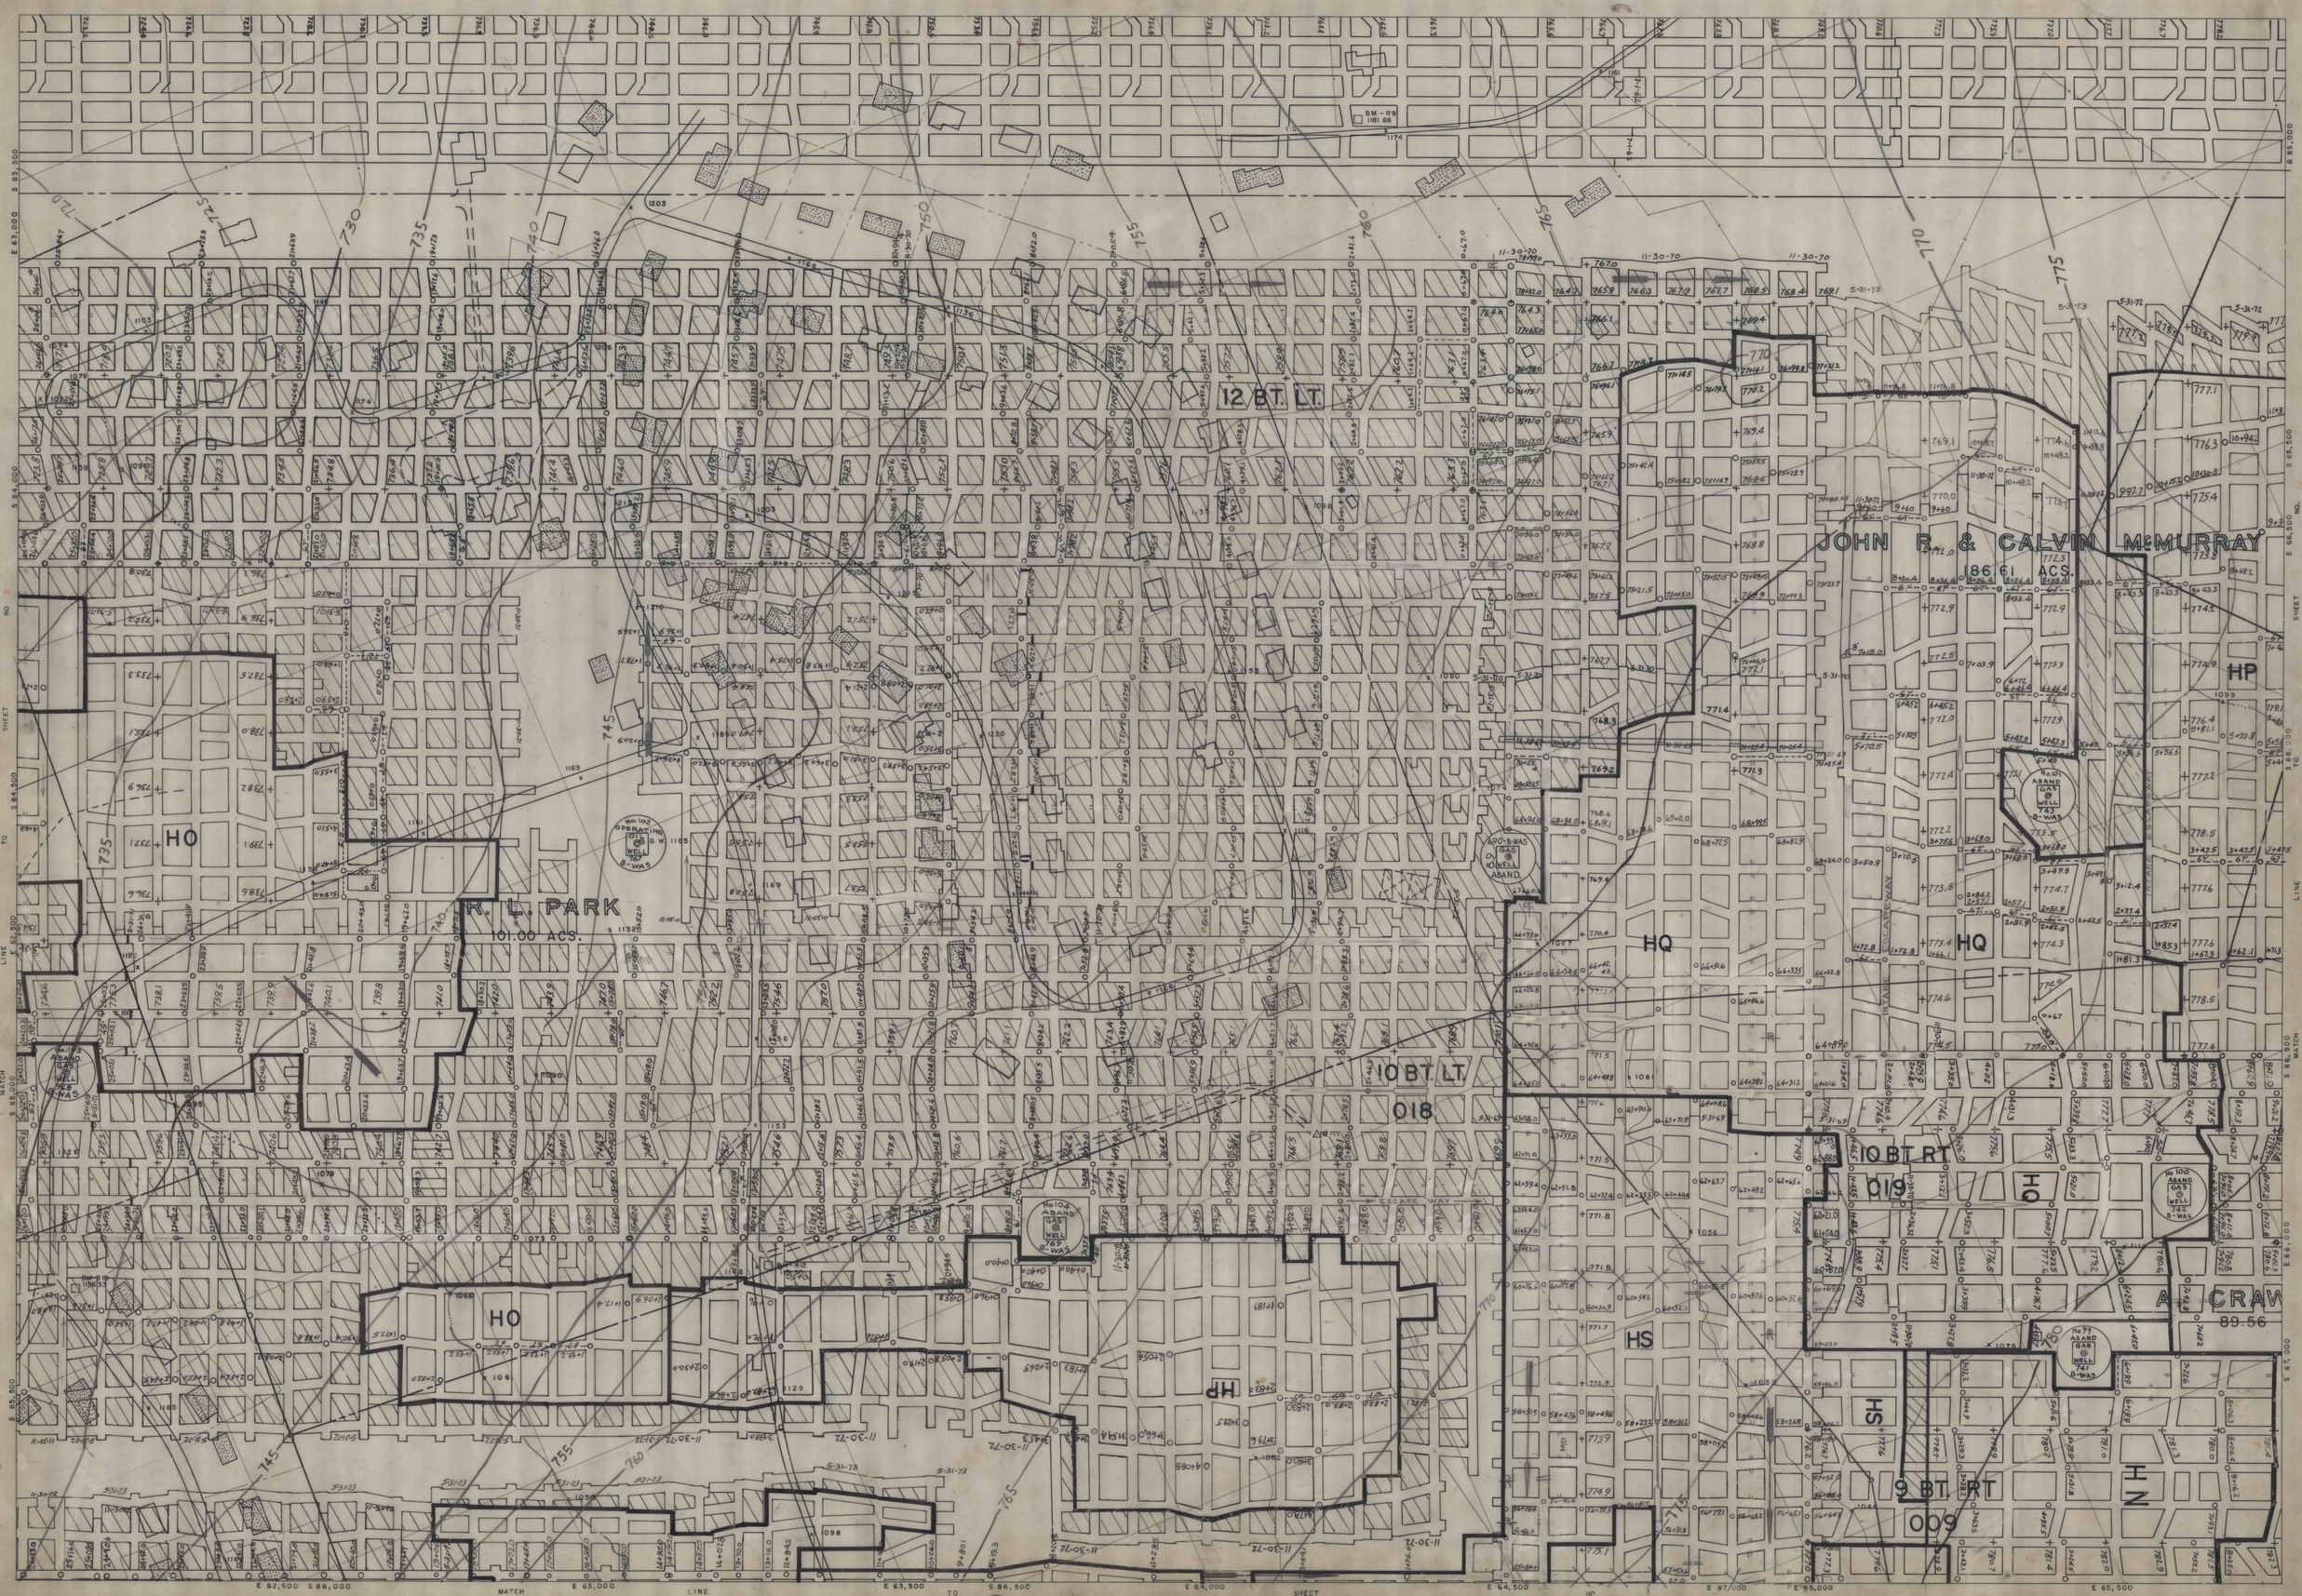
MATHIES MINE K-5642
FIT TO K-5664
FIT TO K-5662
FIT TO K-5641
MATHIES MINE AREA K-5642
12 BT. LT.
JOHN R. & CALVIN McMURRAY
186.61 ACS.
R. L. PARK
101.00 ACS.
10 BT. LT.
018
10 BT. RT.
019
9 BT. RT.
009
HO
HP
HQ
HS
HN
A. CRAW
89.56
Aerial Map Service Co. PITTSBURGH, PA.
SCALE 1"=100'