


J. M. THOMAS  
440 9.90 AC.

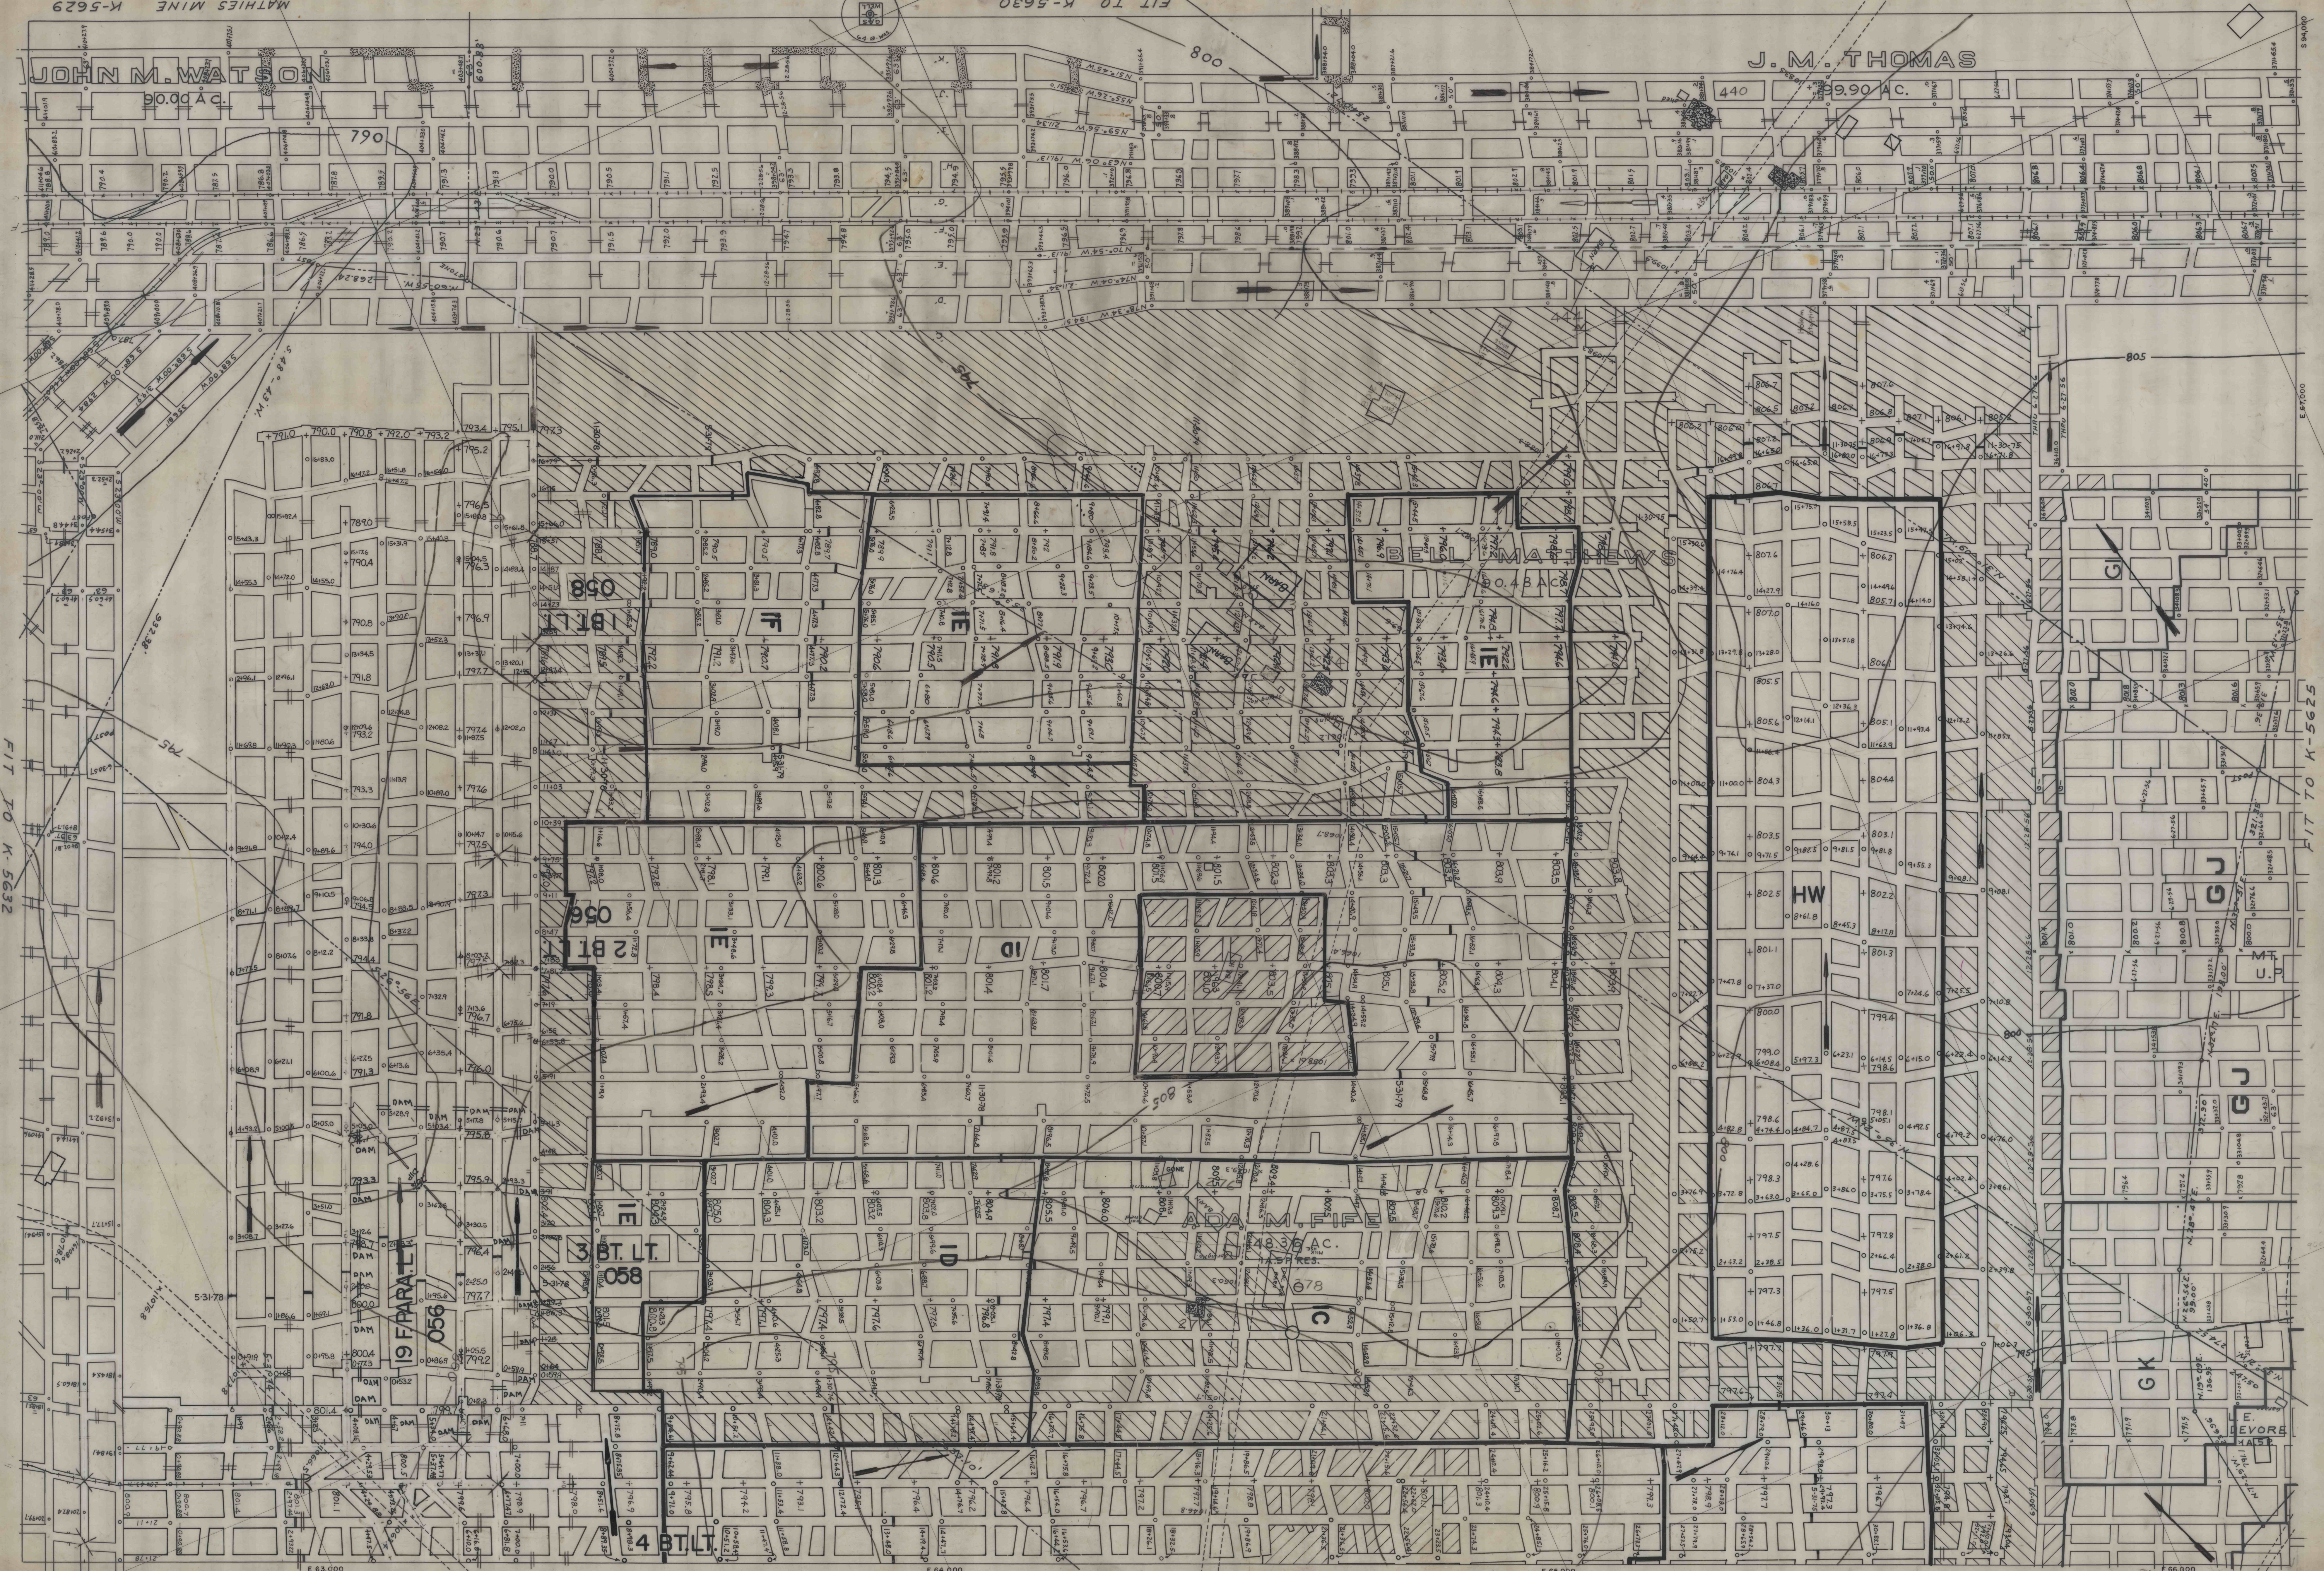

FIT TO K-5632

FIT TO K-5625