


MATHIES MINE  
K-5622  
5105

FIT TO K-5621

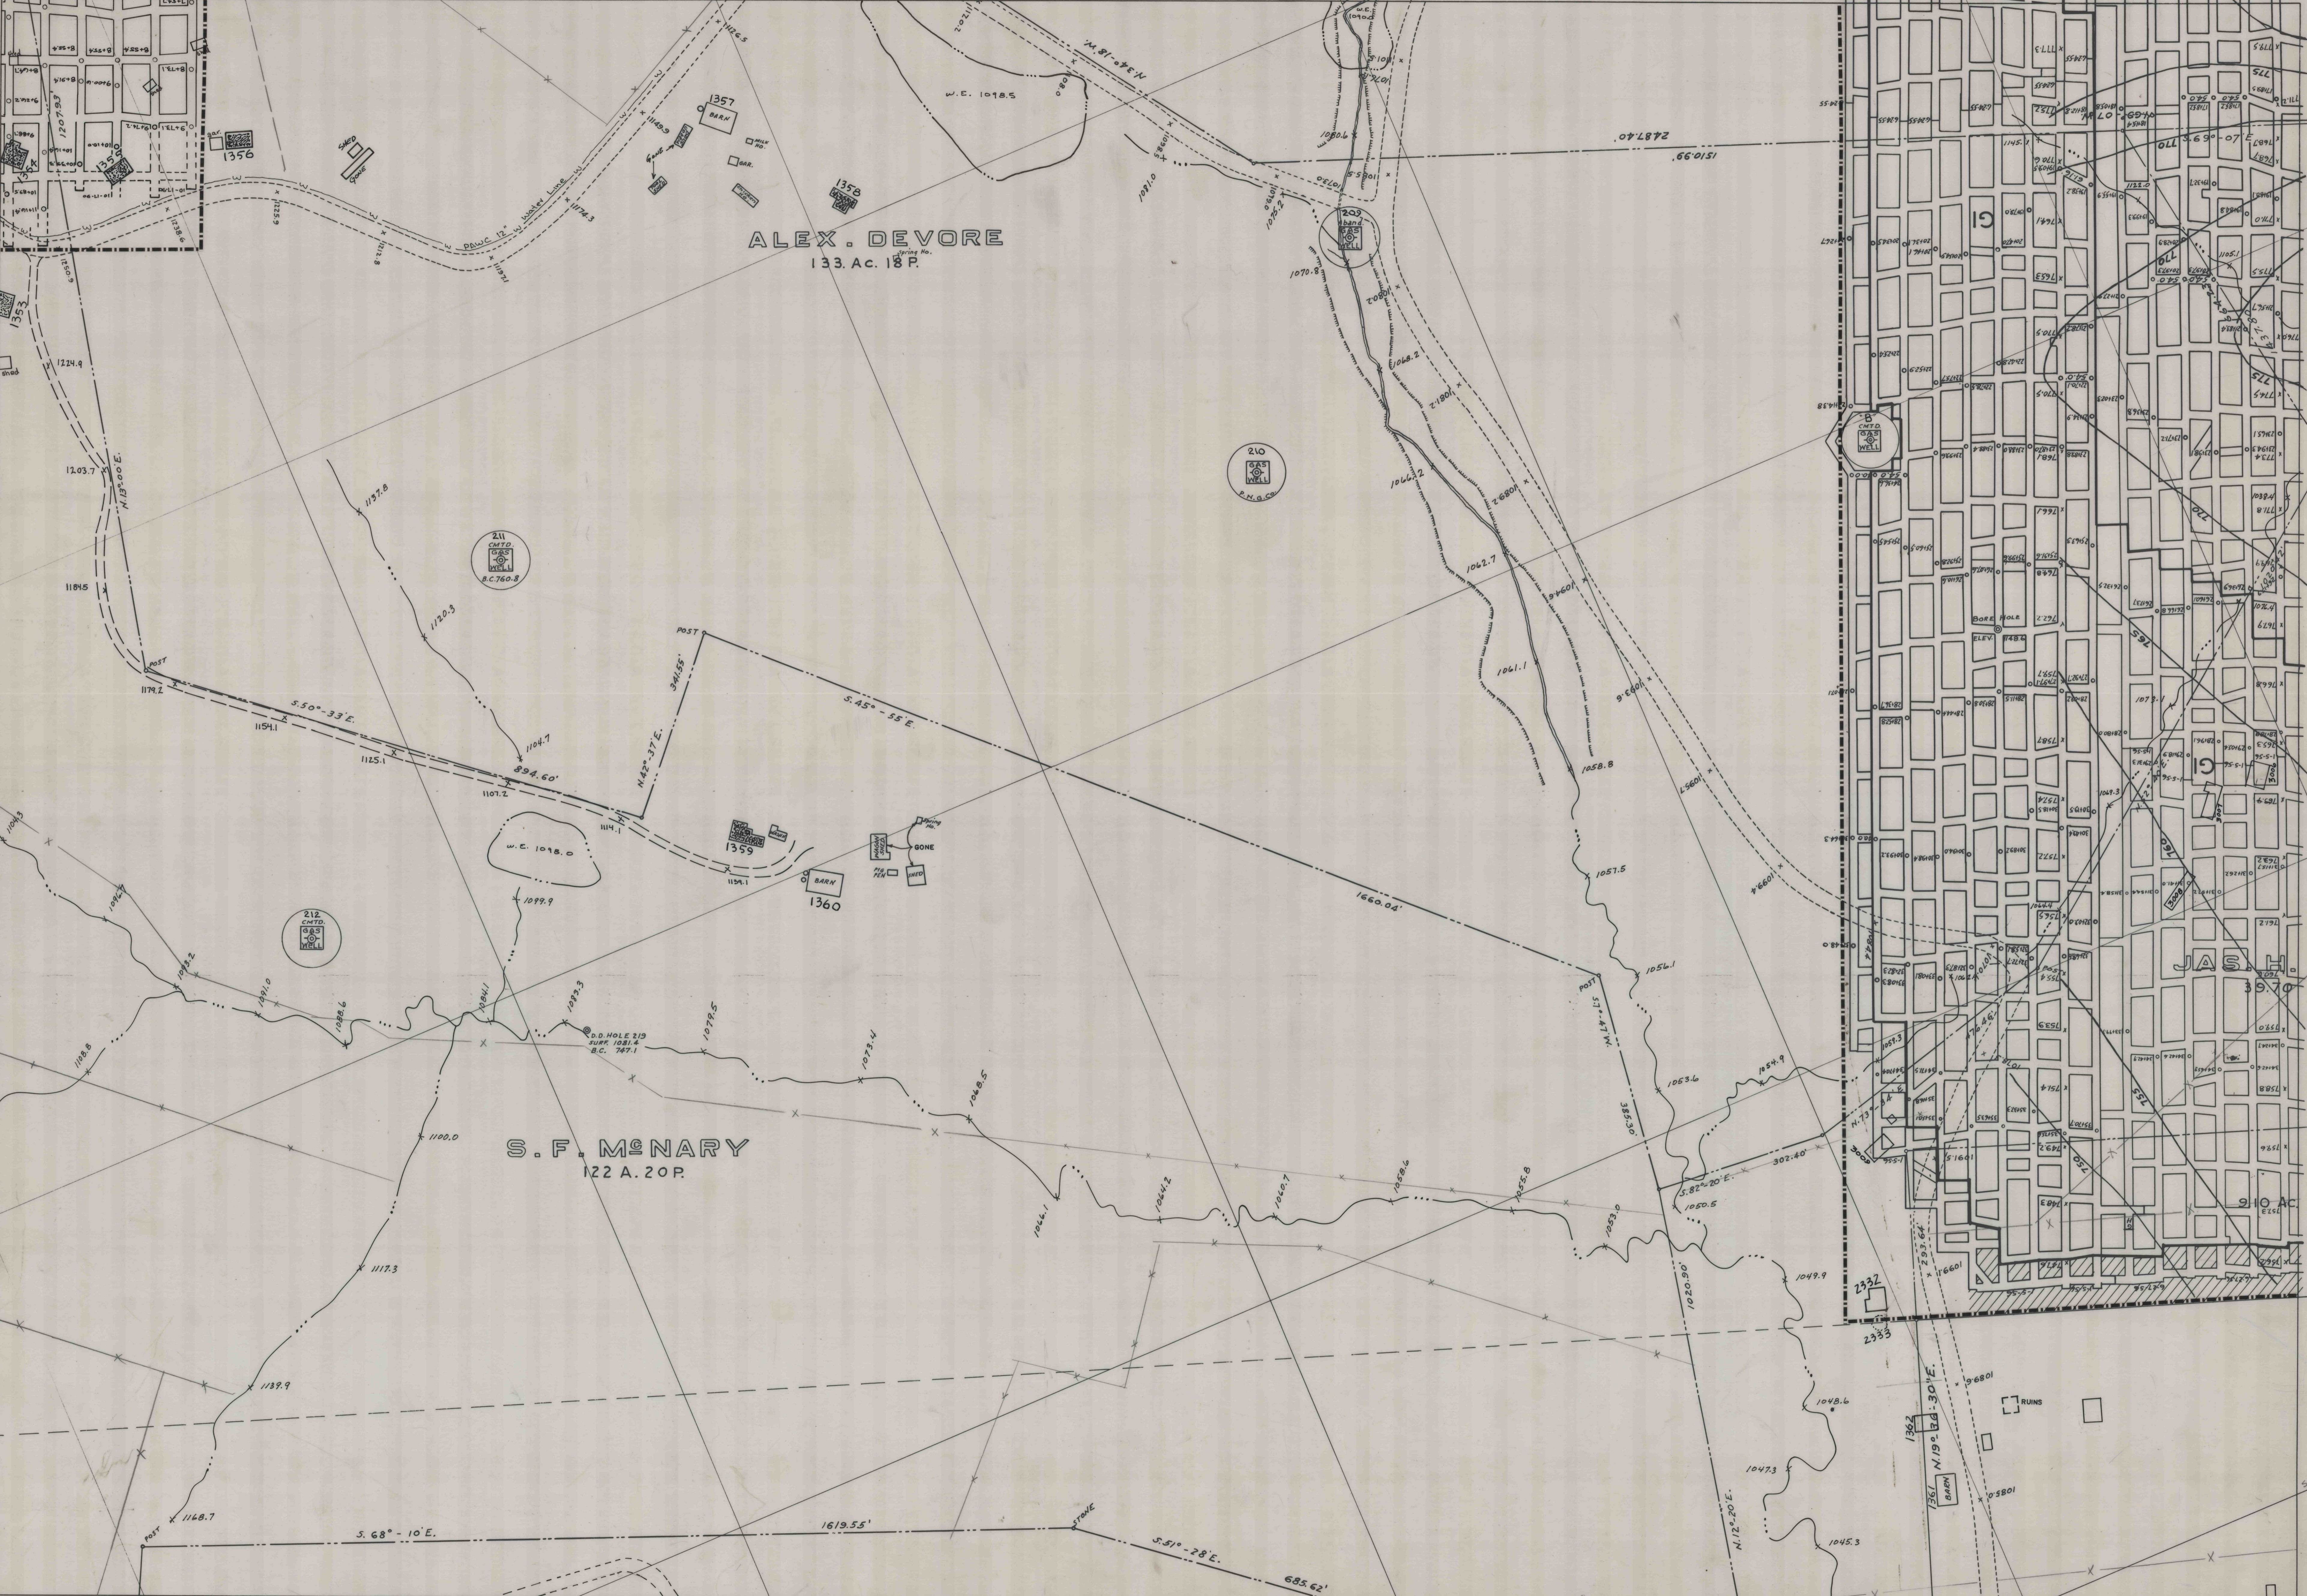

ALEX. DEVORE  
133 AC. 18 P.

S. F. McNARY  

MATHIES MINE  
K-5622

FIT TO K-5634

FIT TO K-5613