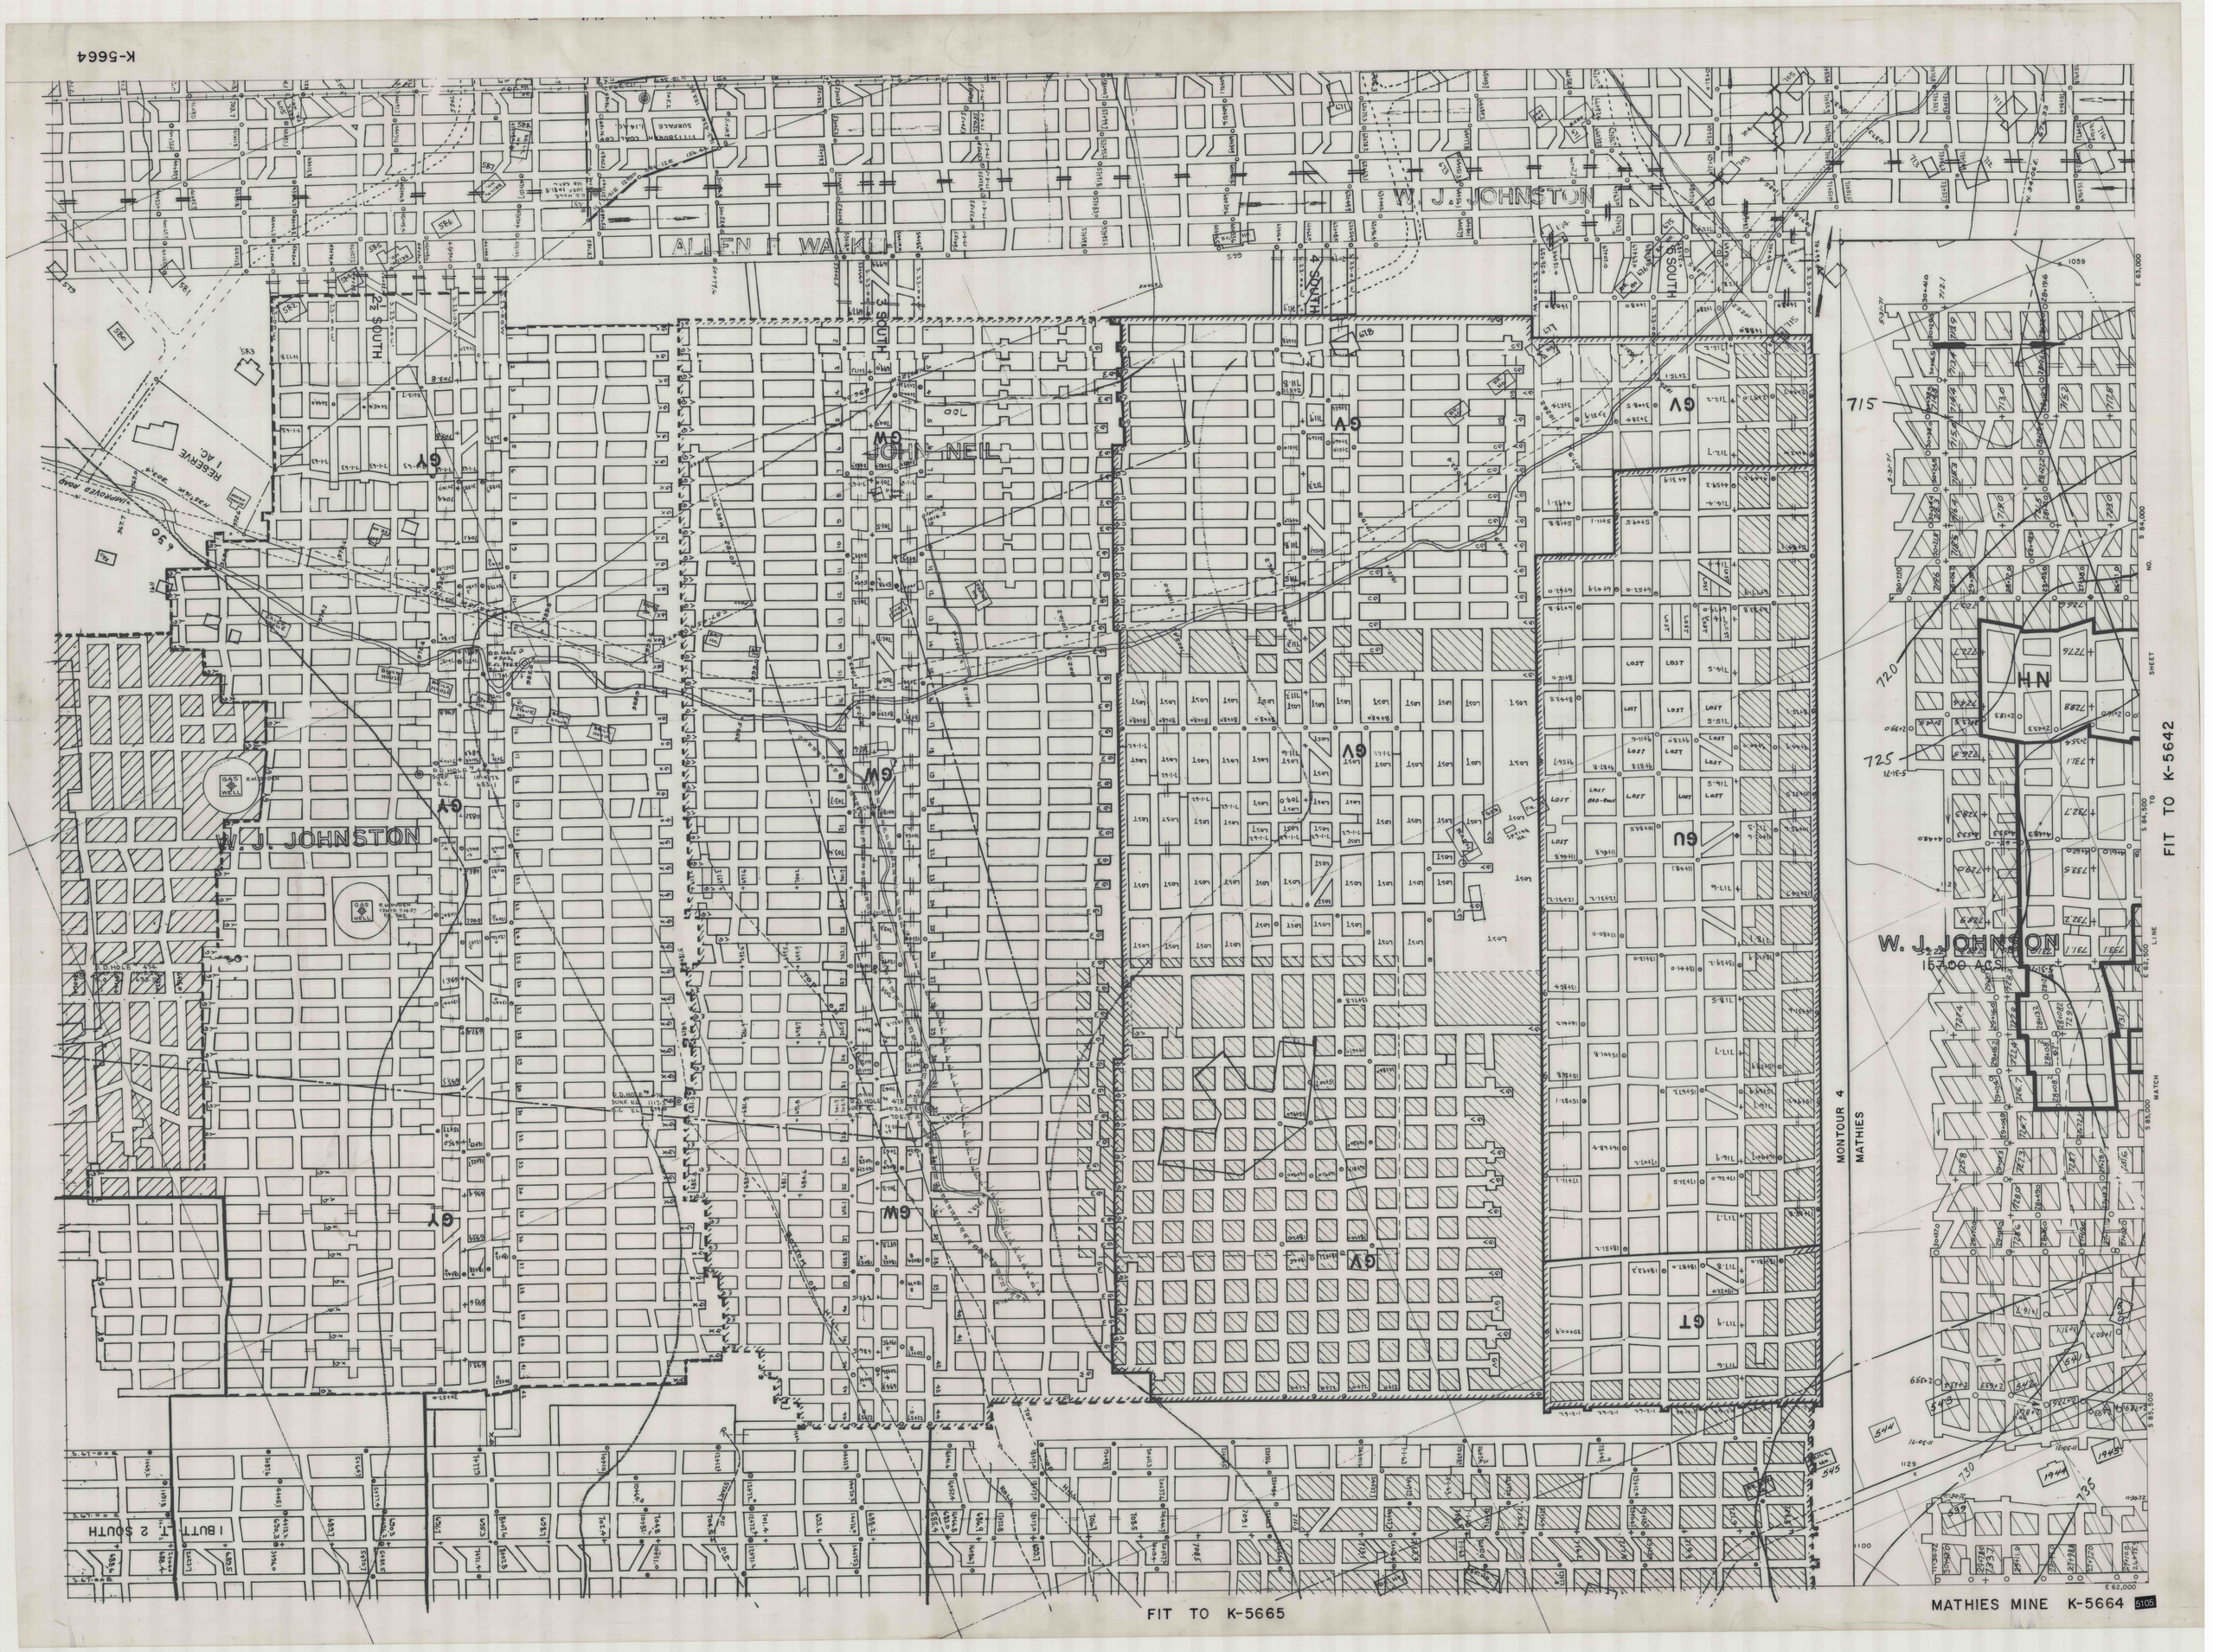
K-5664
W. J. JOHNSTON
ALLEN F. WAKILL
JOHN NEIL
W. J. JOHNSTON
W. J. JOHNSTON
157.00 ACS
RESERVE 1 AC.
IMPROVED ROAD
2½ SOUTH
3 SOUTH
4 SOUTH
5 SOUTH
1 BUTT 1, 2 SOUTH
MONTOUR 4
MATHIES
715
720
725
730
735
FIT TO K-5642
FIT TO K-5665
MATHIES MINE K-5664