


JOSIAH KERR
69.12 ACS.

JOHN S. PATTERSON
62.56 ACS.

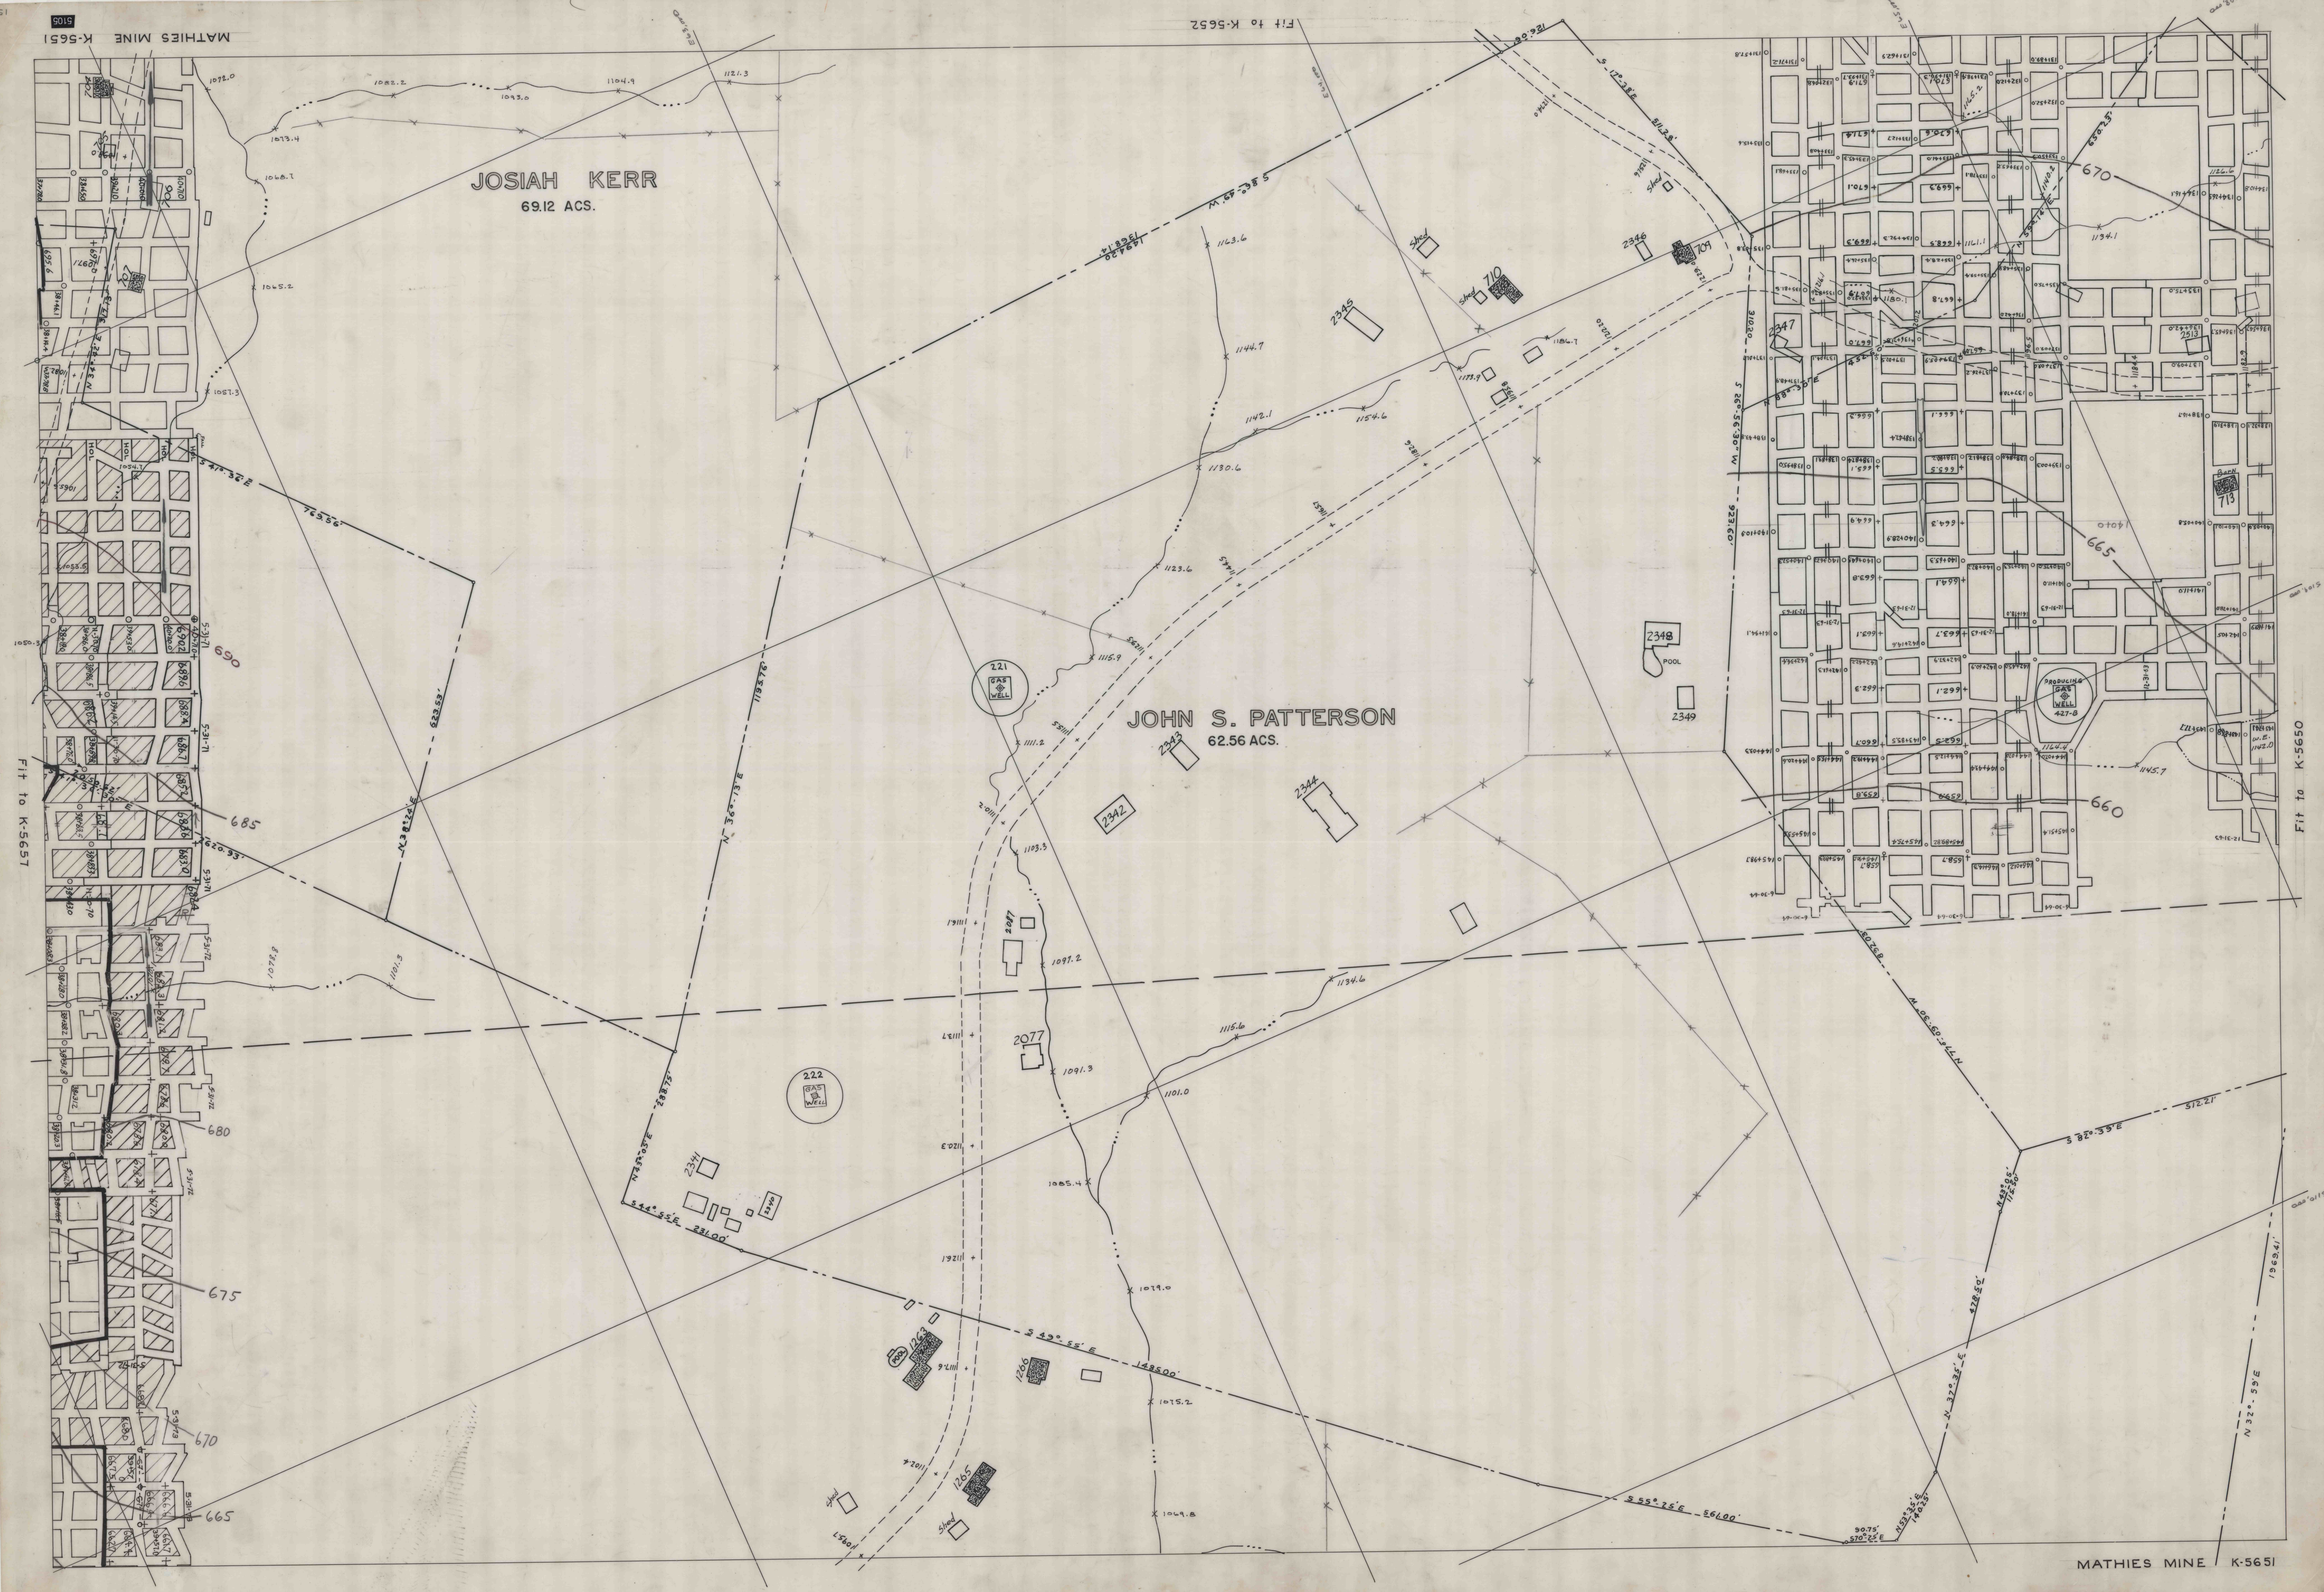

Fit to K-5657

Fit to K-5650