


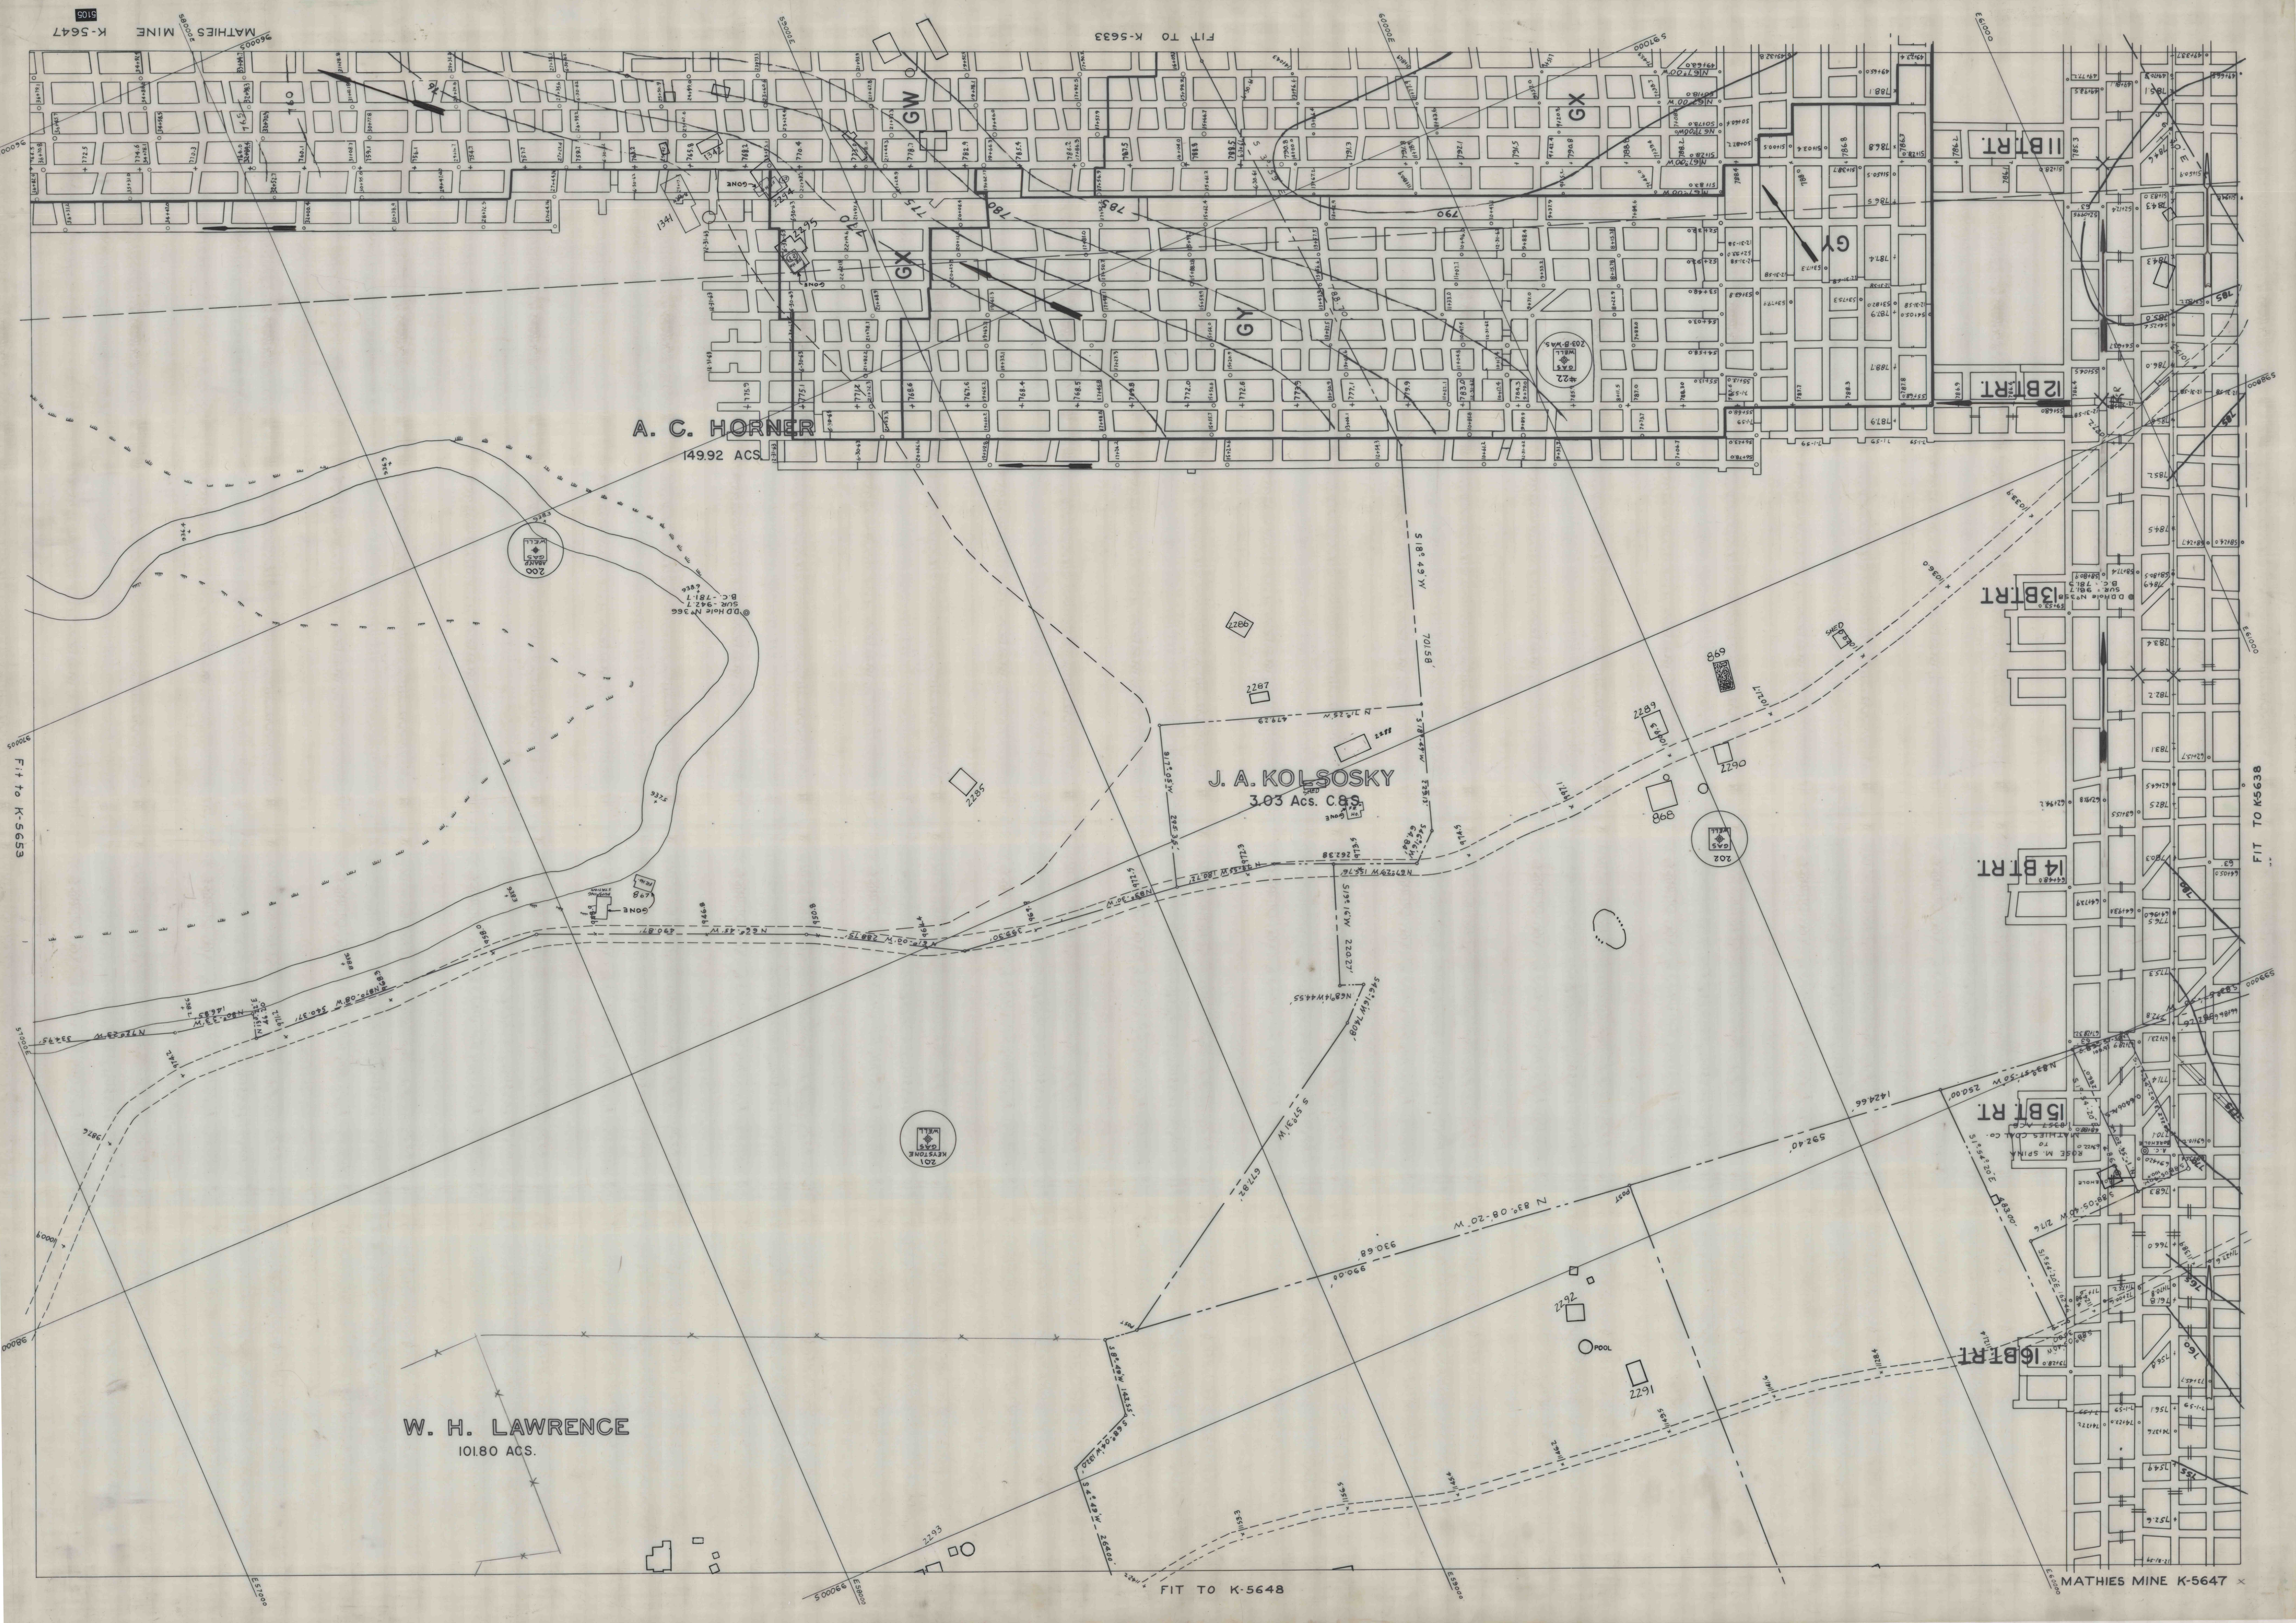

A. C. HORNER

149.92 ACS

J. A. KOLOSKY
3.03 ACS. C.B.S.

W. H. LAWRENCE
101.80 ACS.

11B RT.

12B RT.

13B RT.

14B RT.

15B RT.

16B RT.

FIT TO K-5638

MATHIES MINE K-5647

FIT TO K-5648

5108

MATHIES MINE K-5647

FIT TO K-5633