


JOHN B. MBRIDE 102.92 AC.

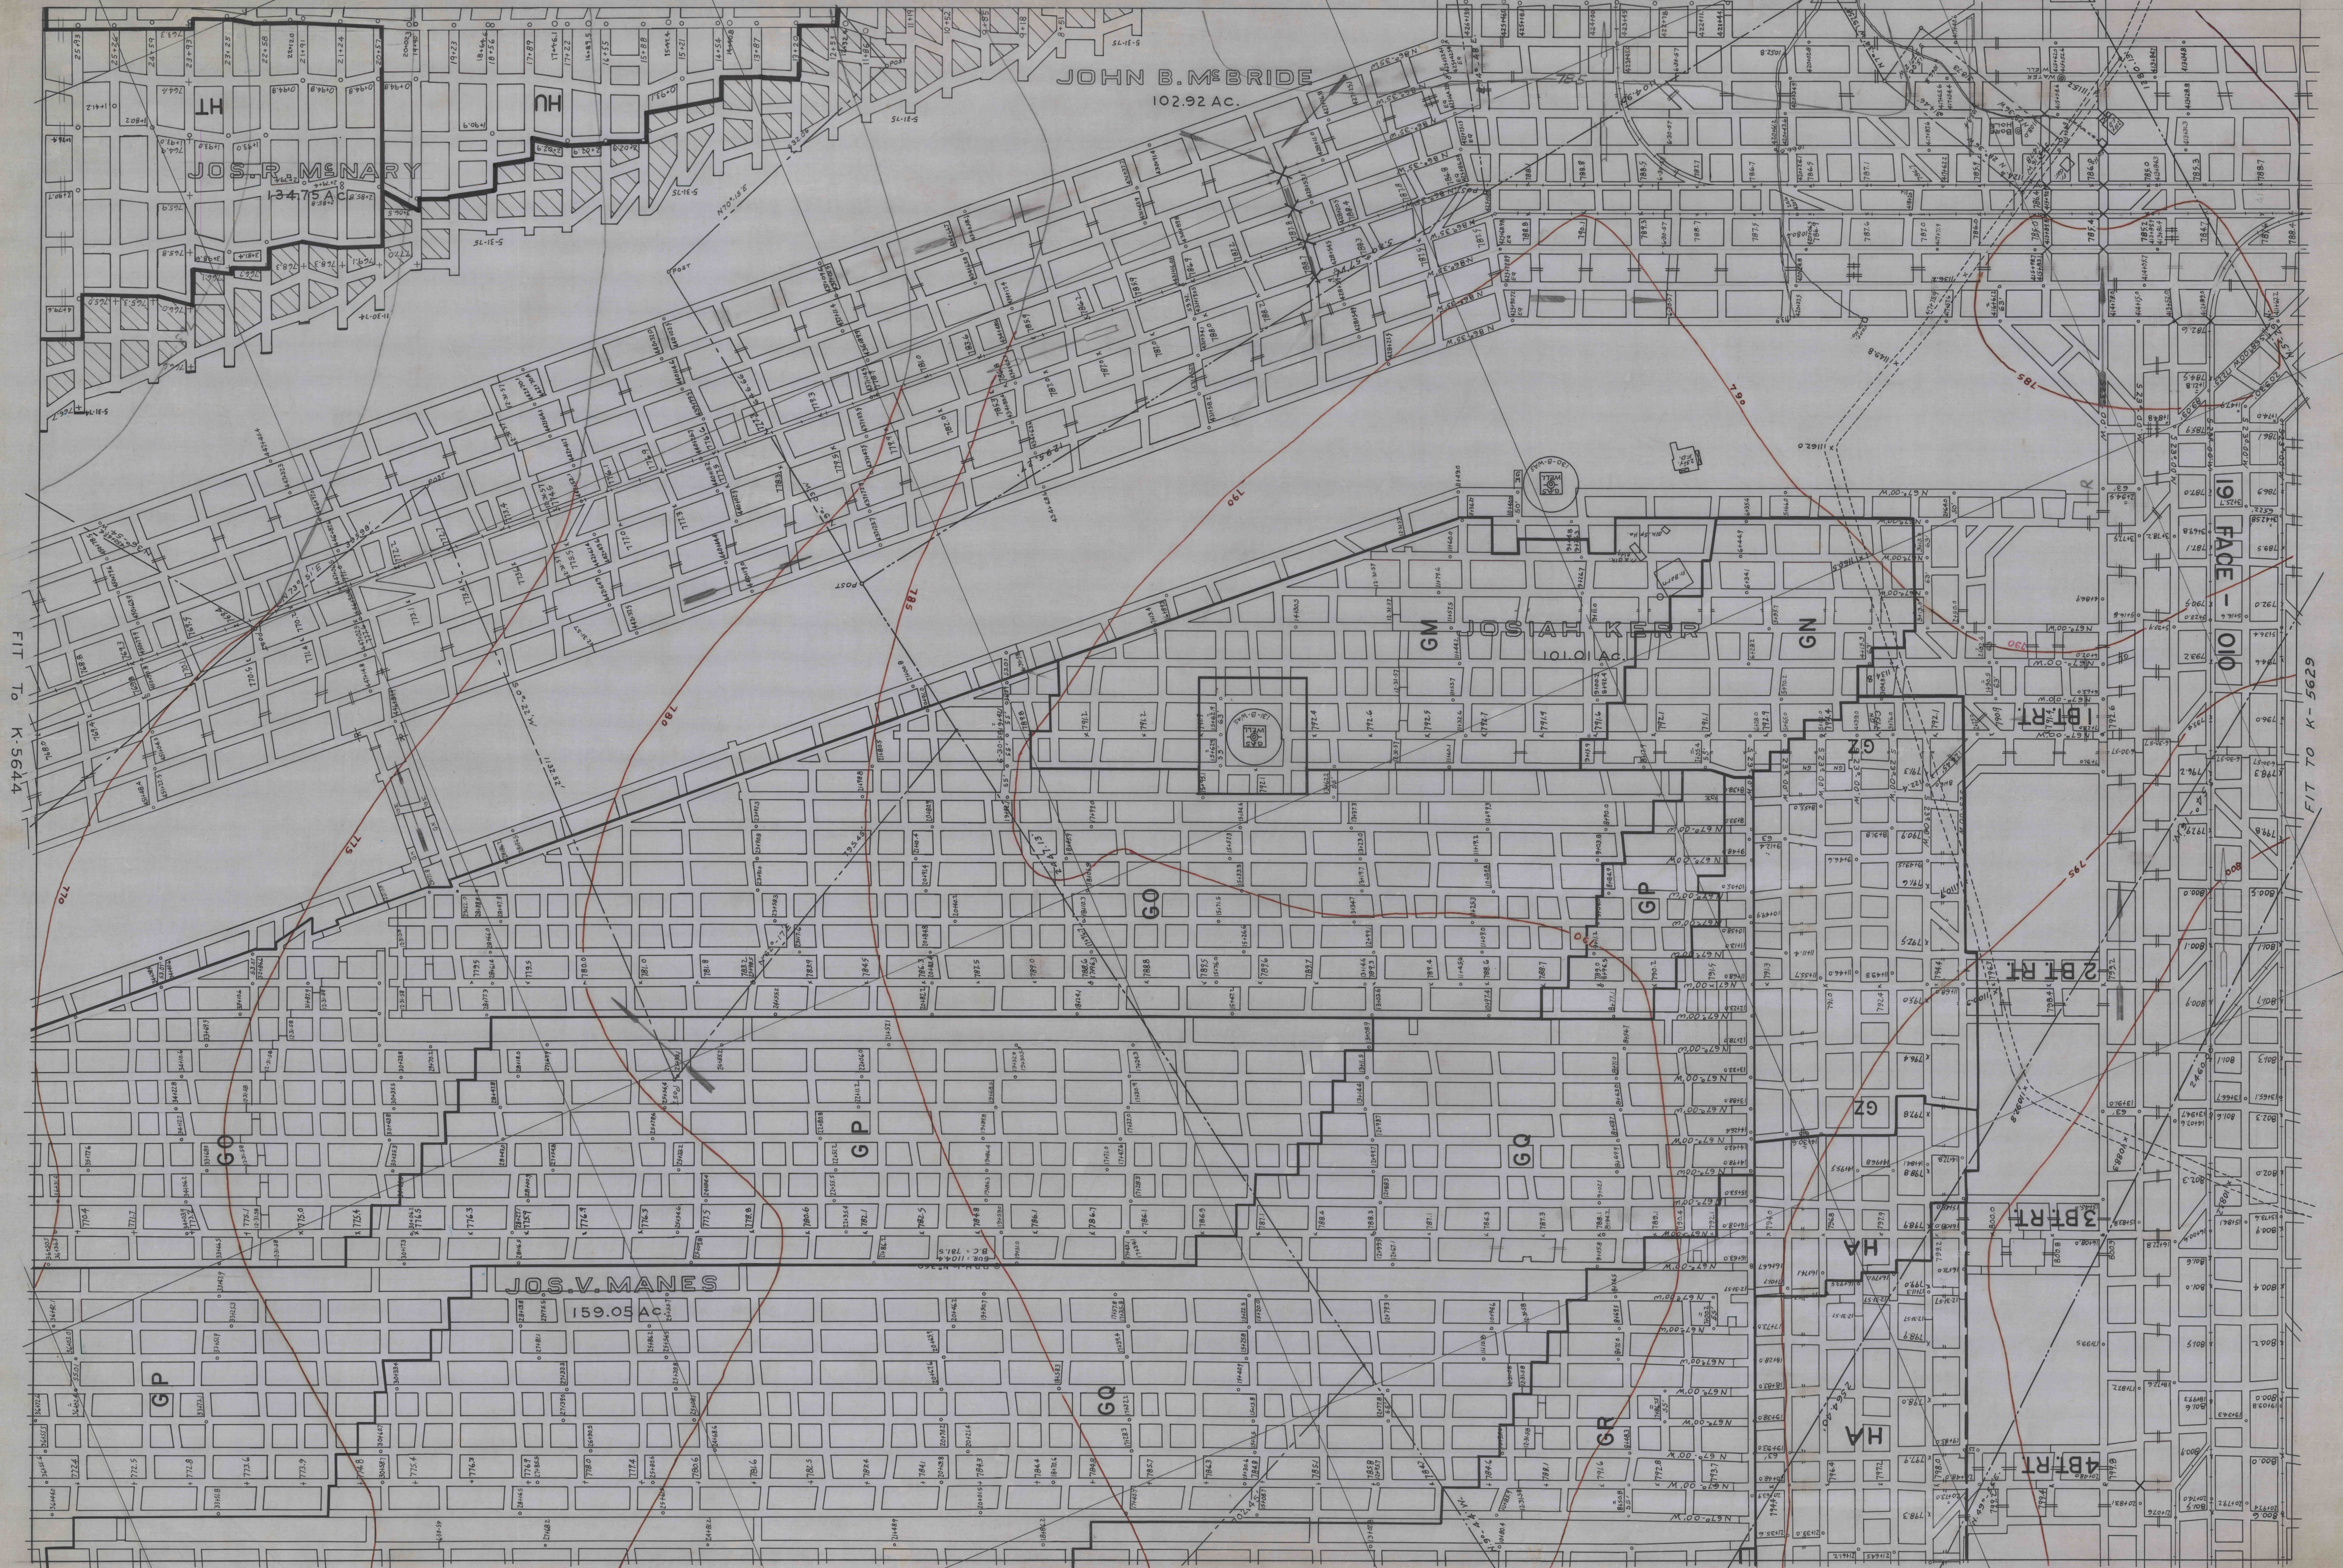

FIT TO K-5644

FIT TO K-5629