


FIT TO K-5636

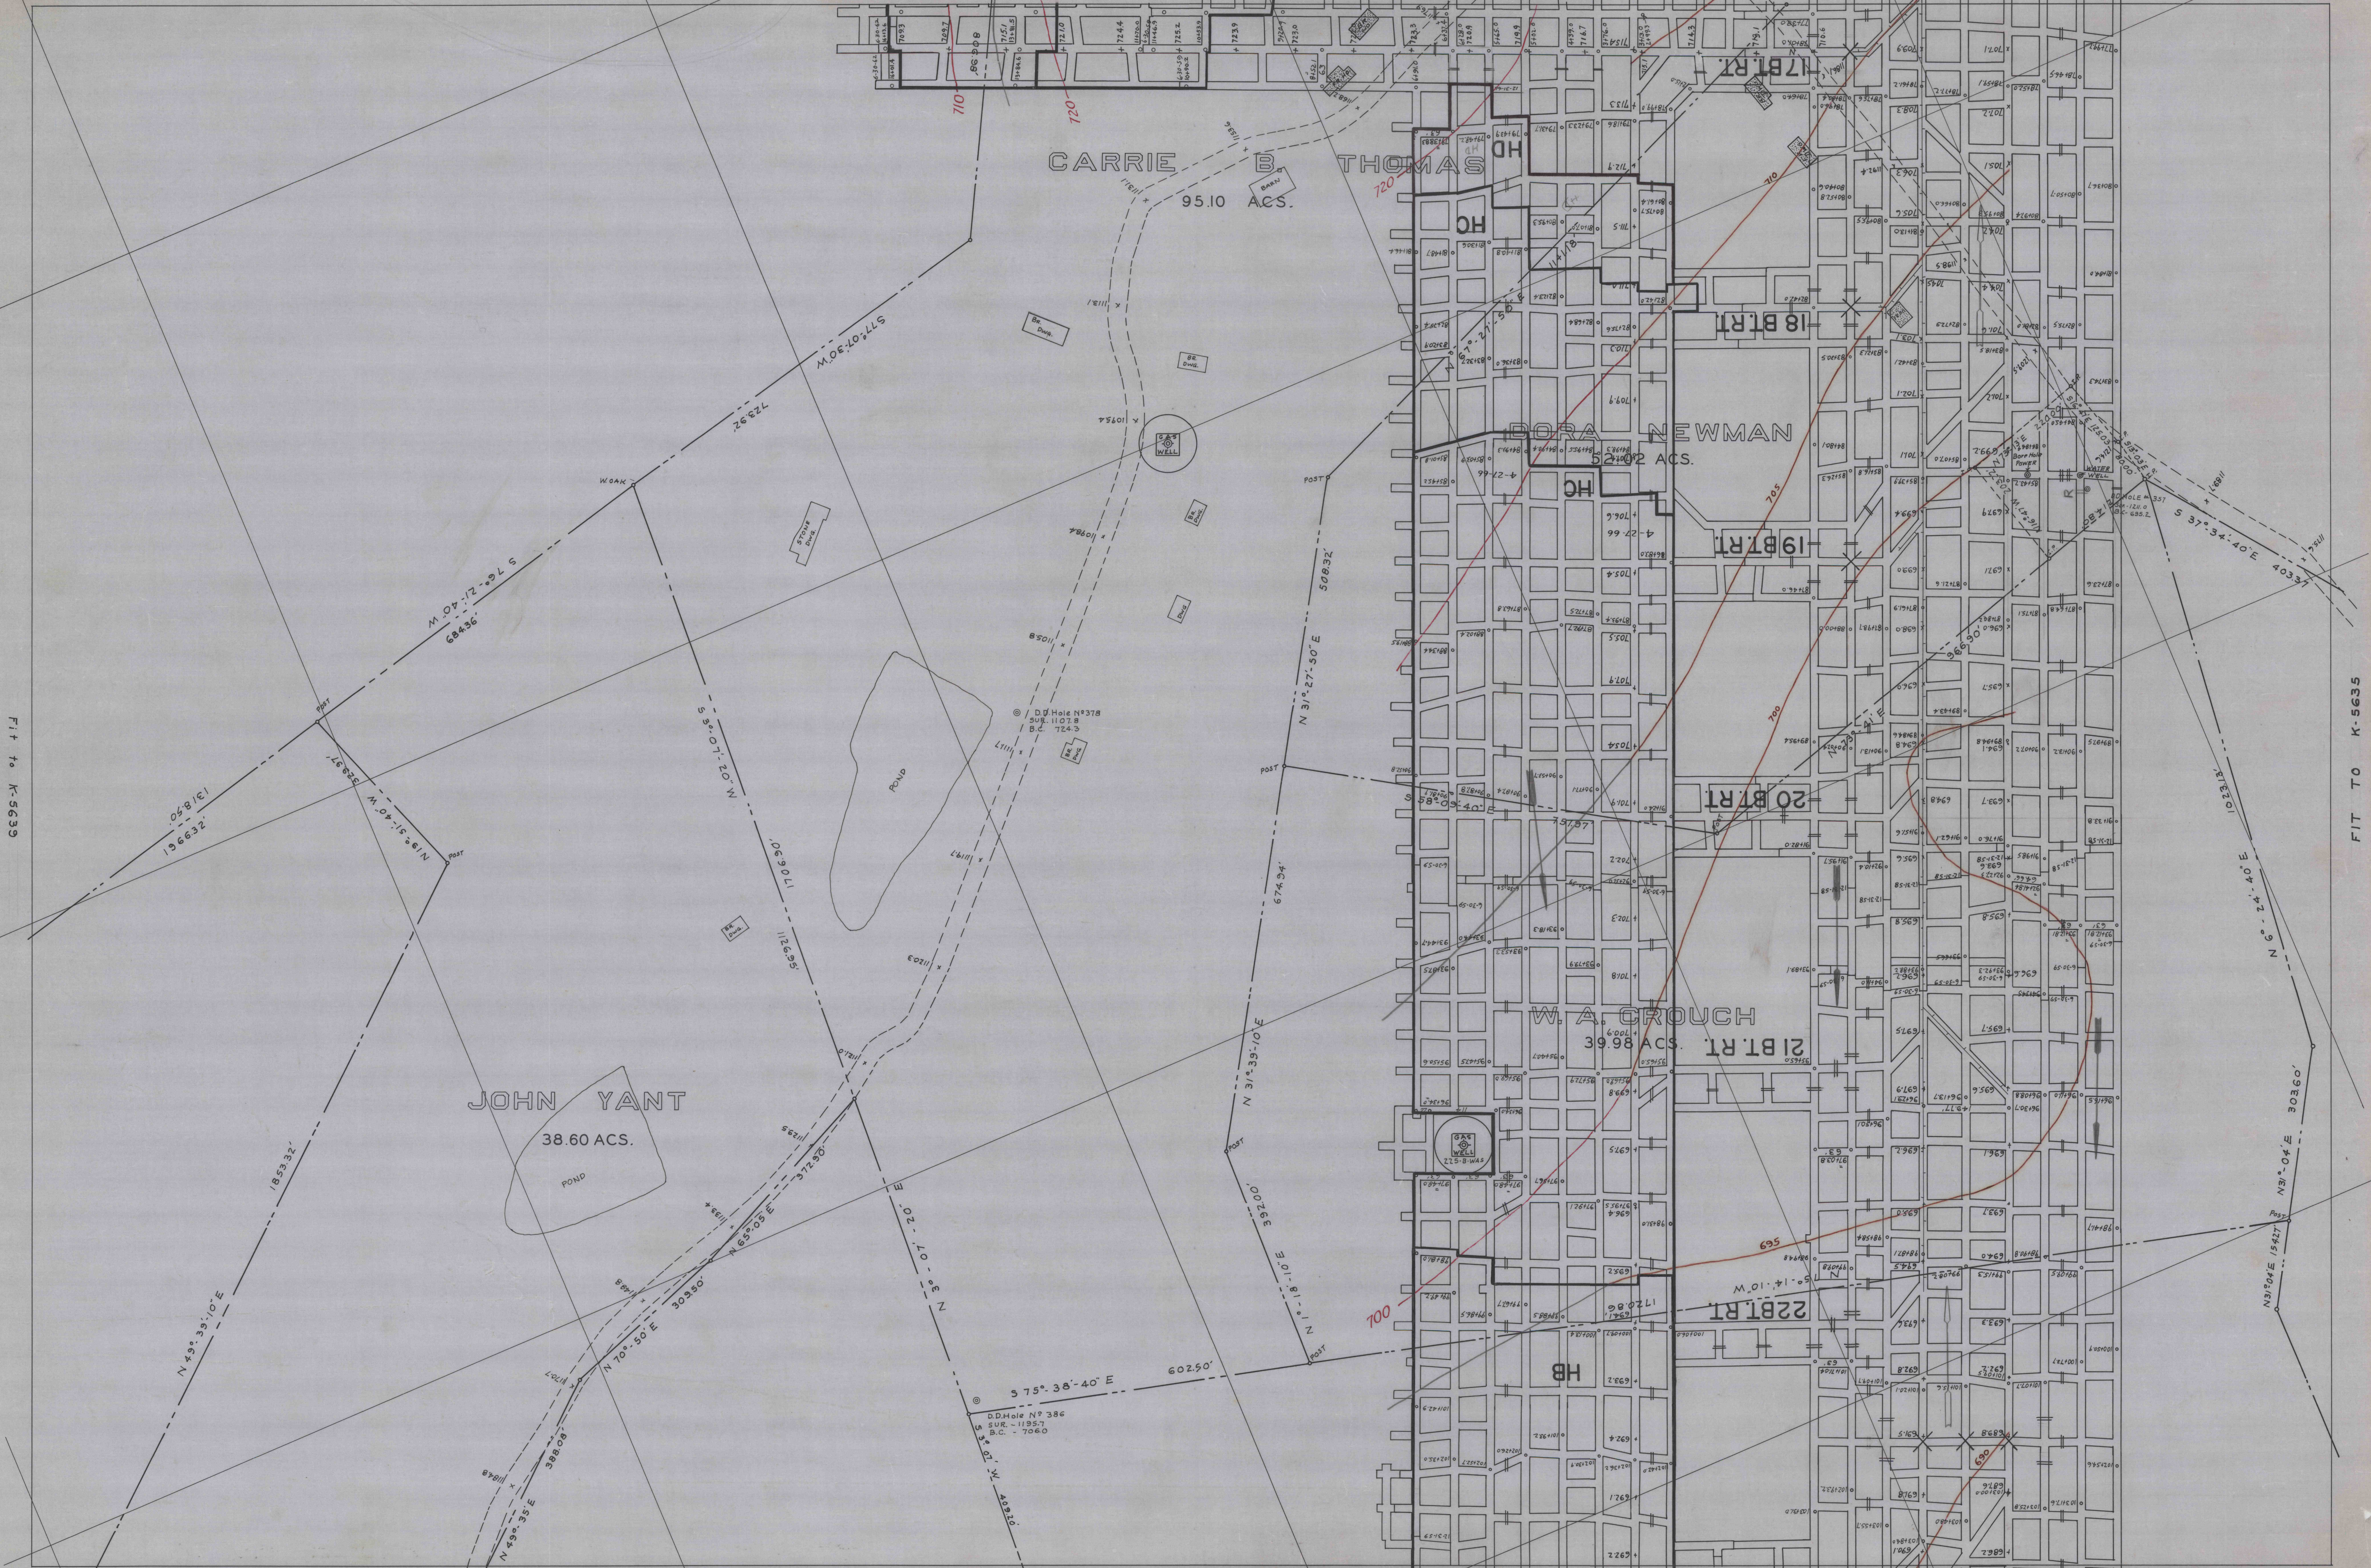

FIT TO K-5639

FIT TO K-5635

FIT TO K-5652

MATHIES MINE K-5637