



MATHIES MINE K-5666
See New Plastic K 5666

FIT TO K-5665

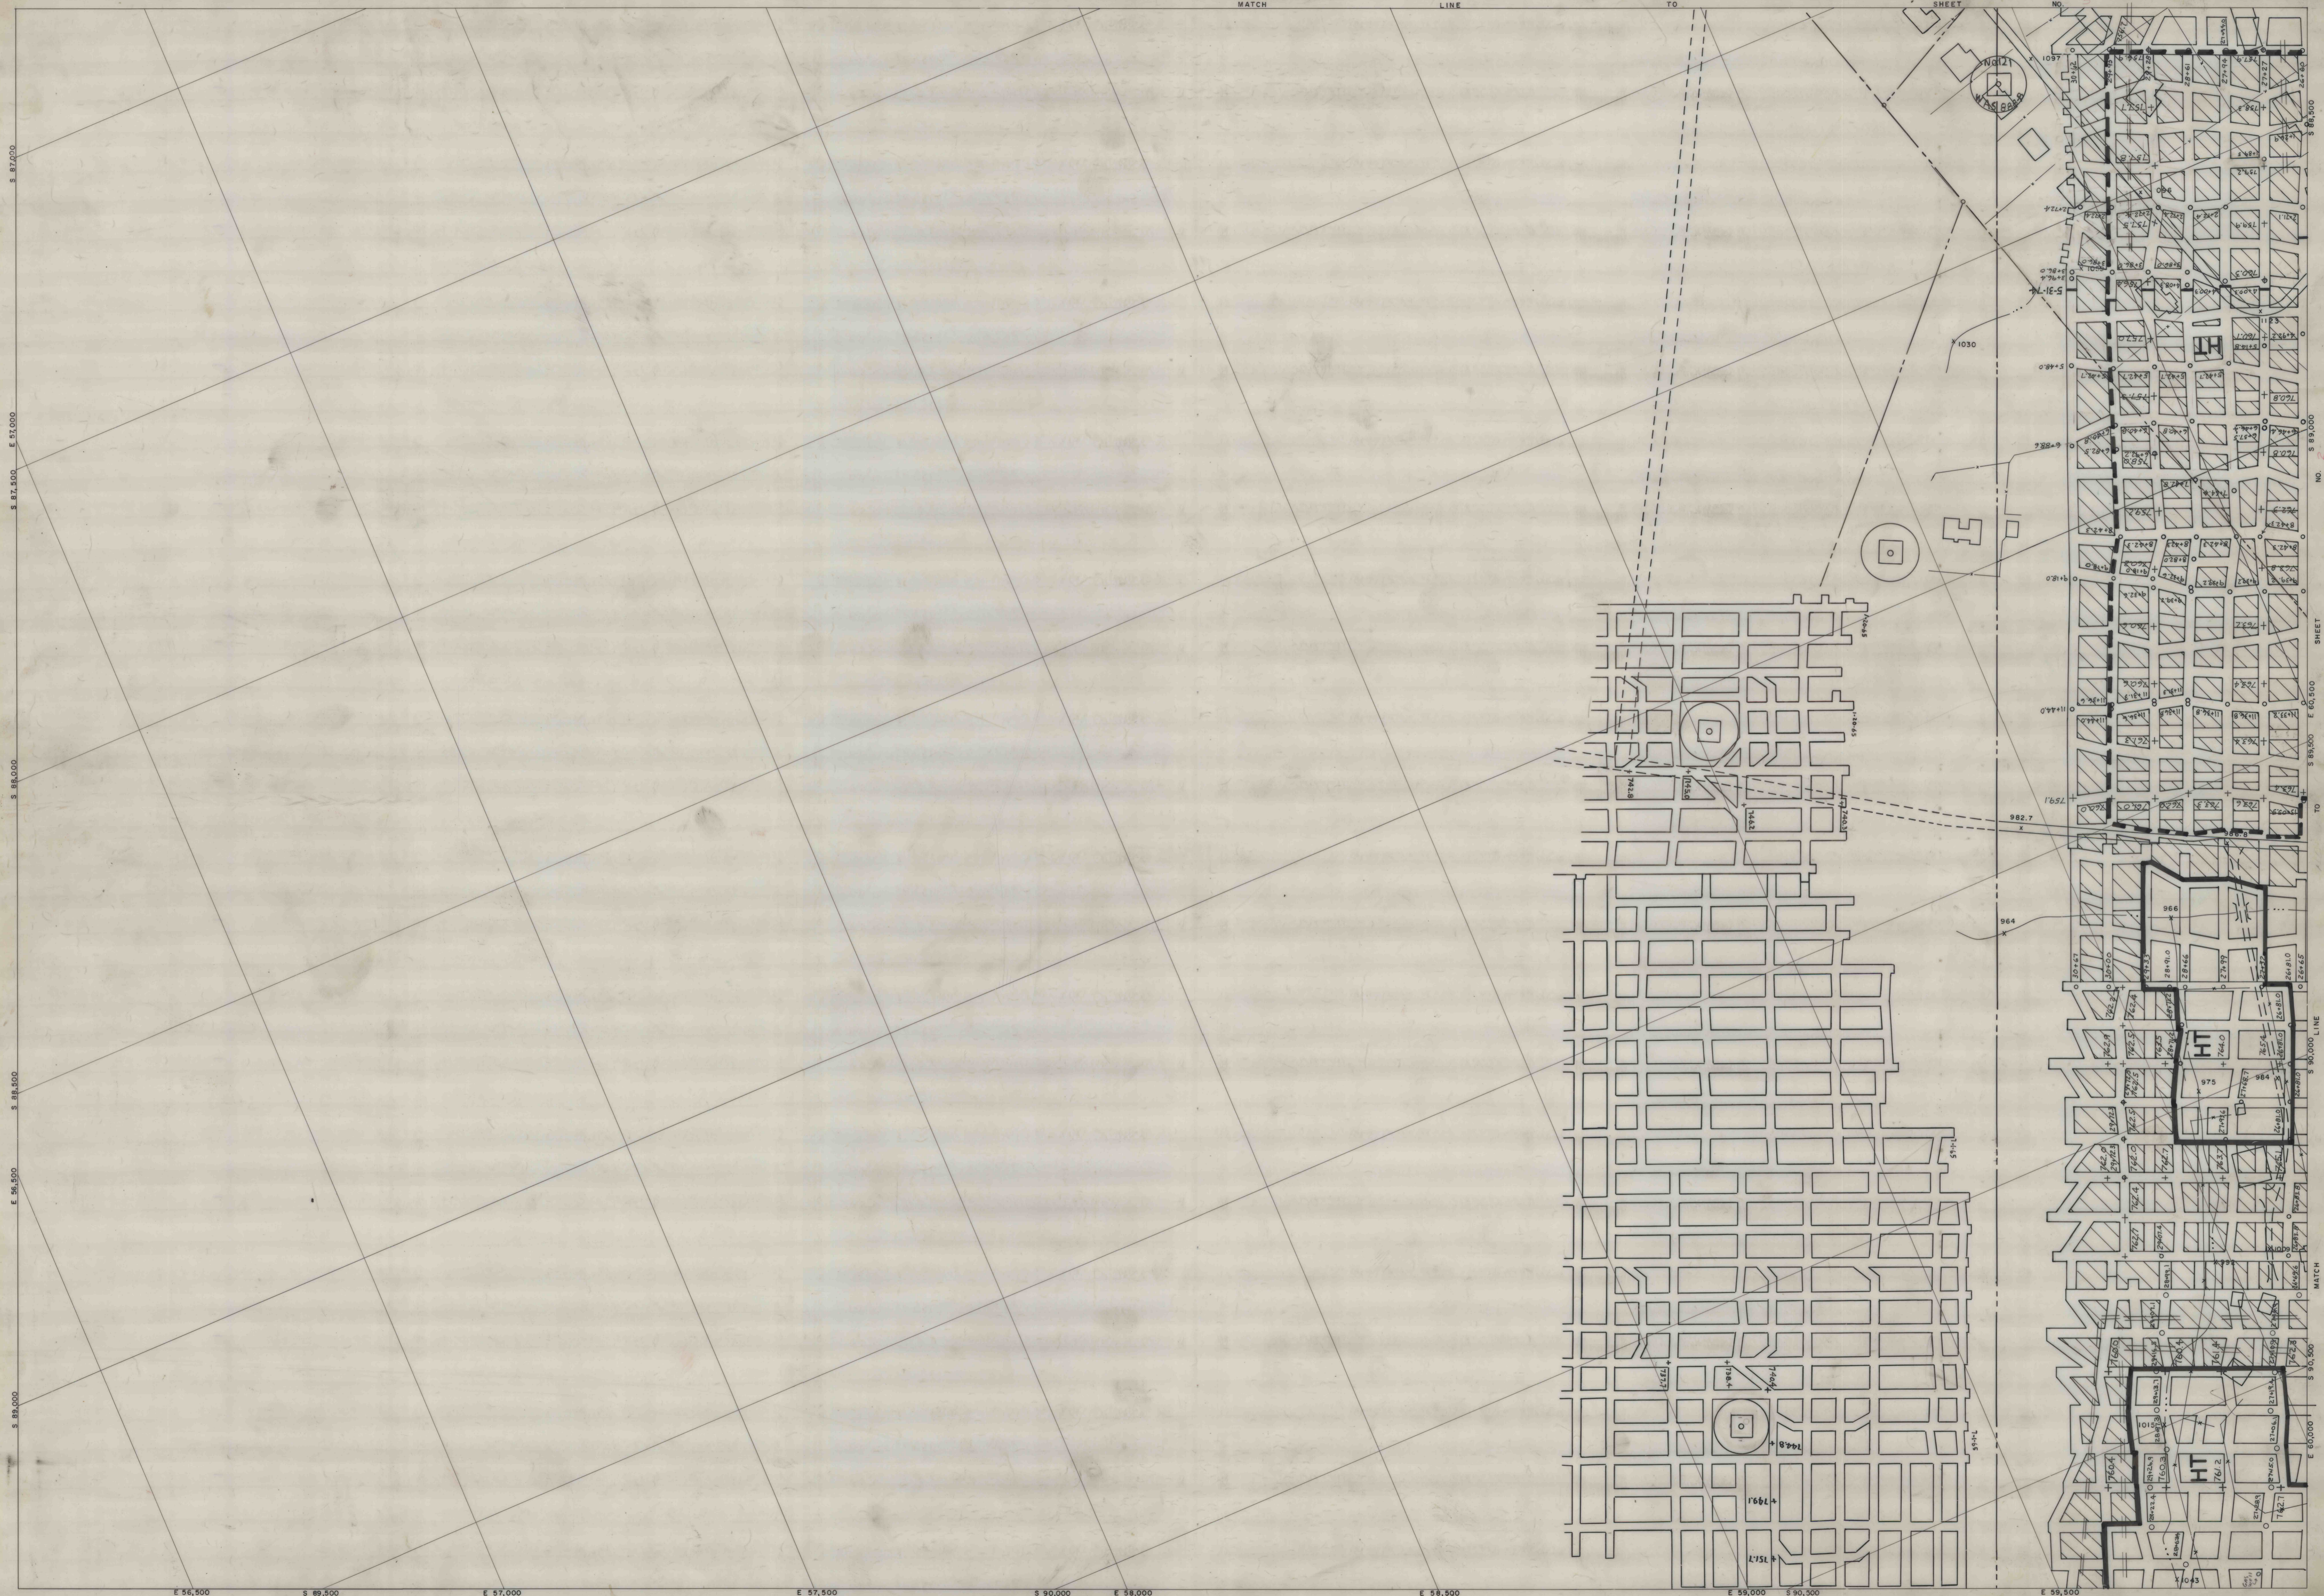

Aerial Map Service Co. PITTSBURGH, PA.

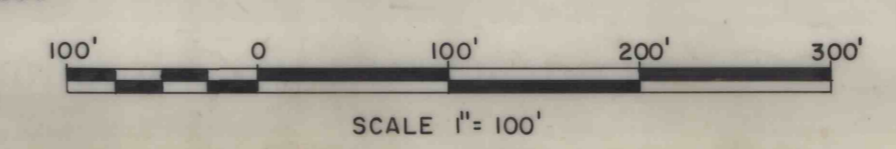

FIT TO K-5644

MATHIES MINE AREA K-5666

5109

FIT TO K-5640