
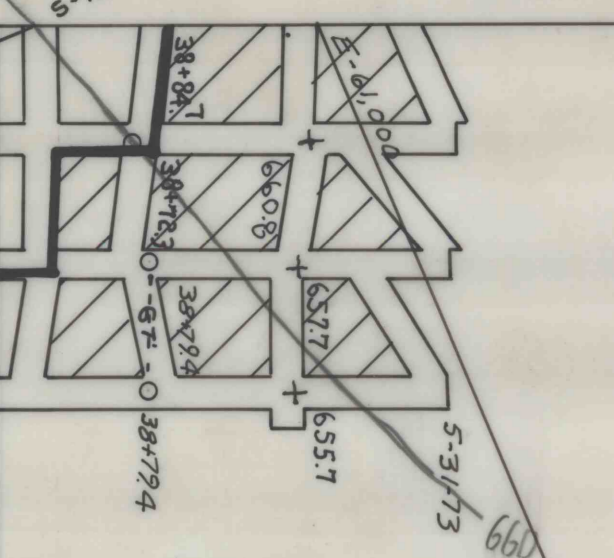


K-5674

Fit To 5651

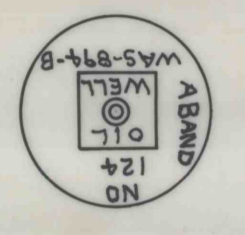

Fit To 5673

Fit To 5675

Fit To 5677

K-5674
See New K-5674