


VOID See New PLASTIC K-5621

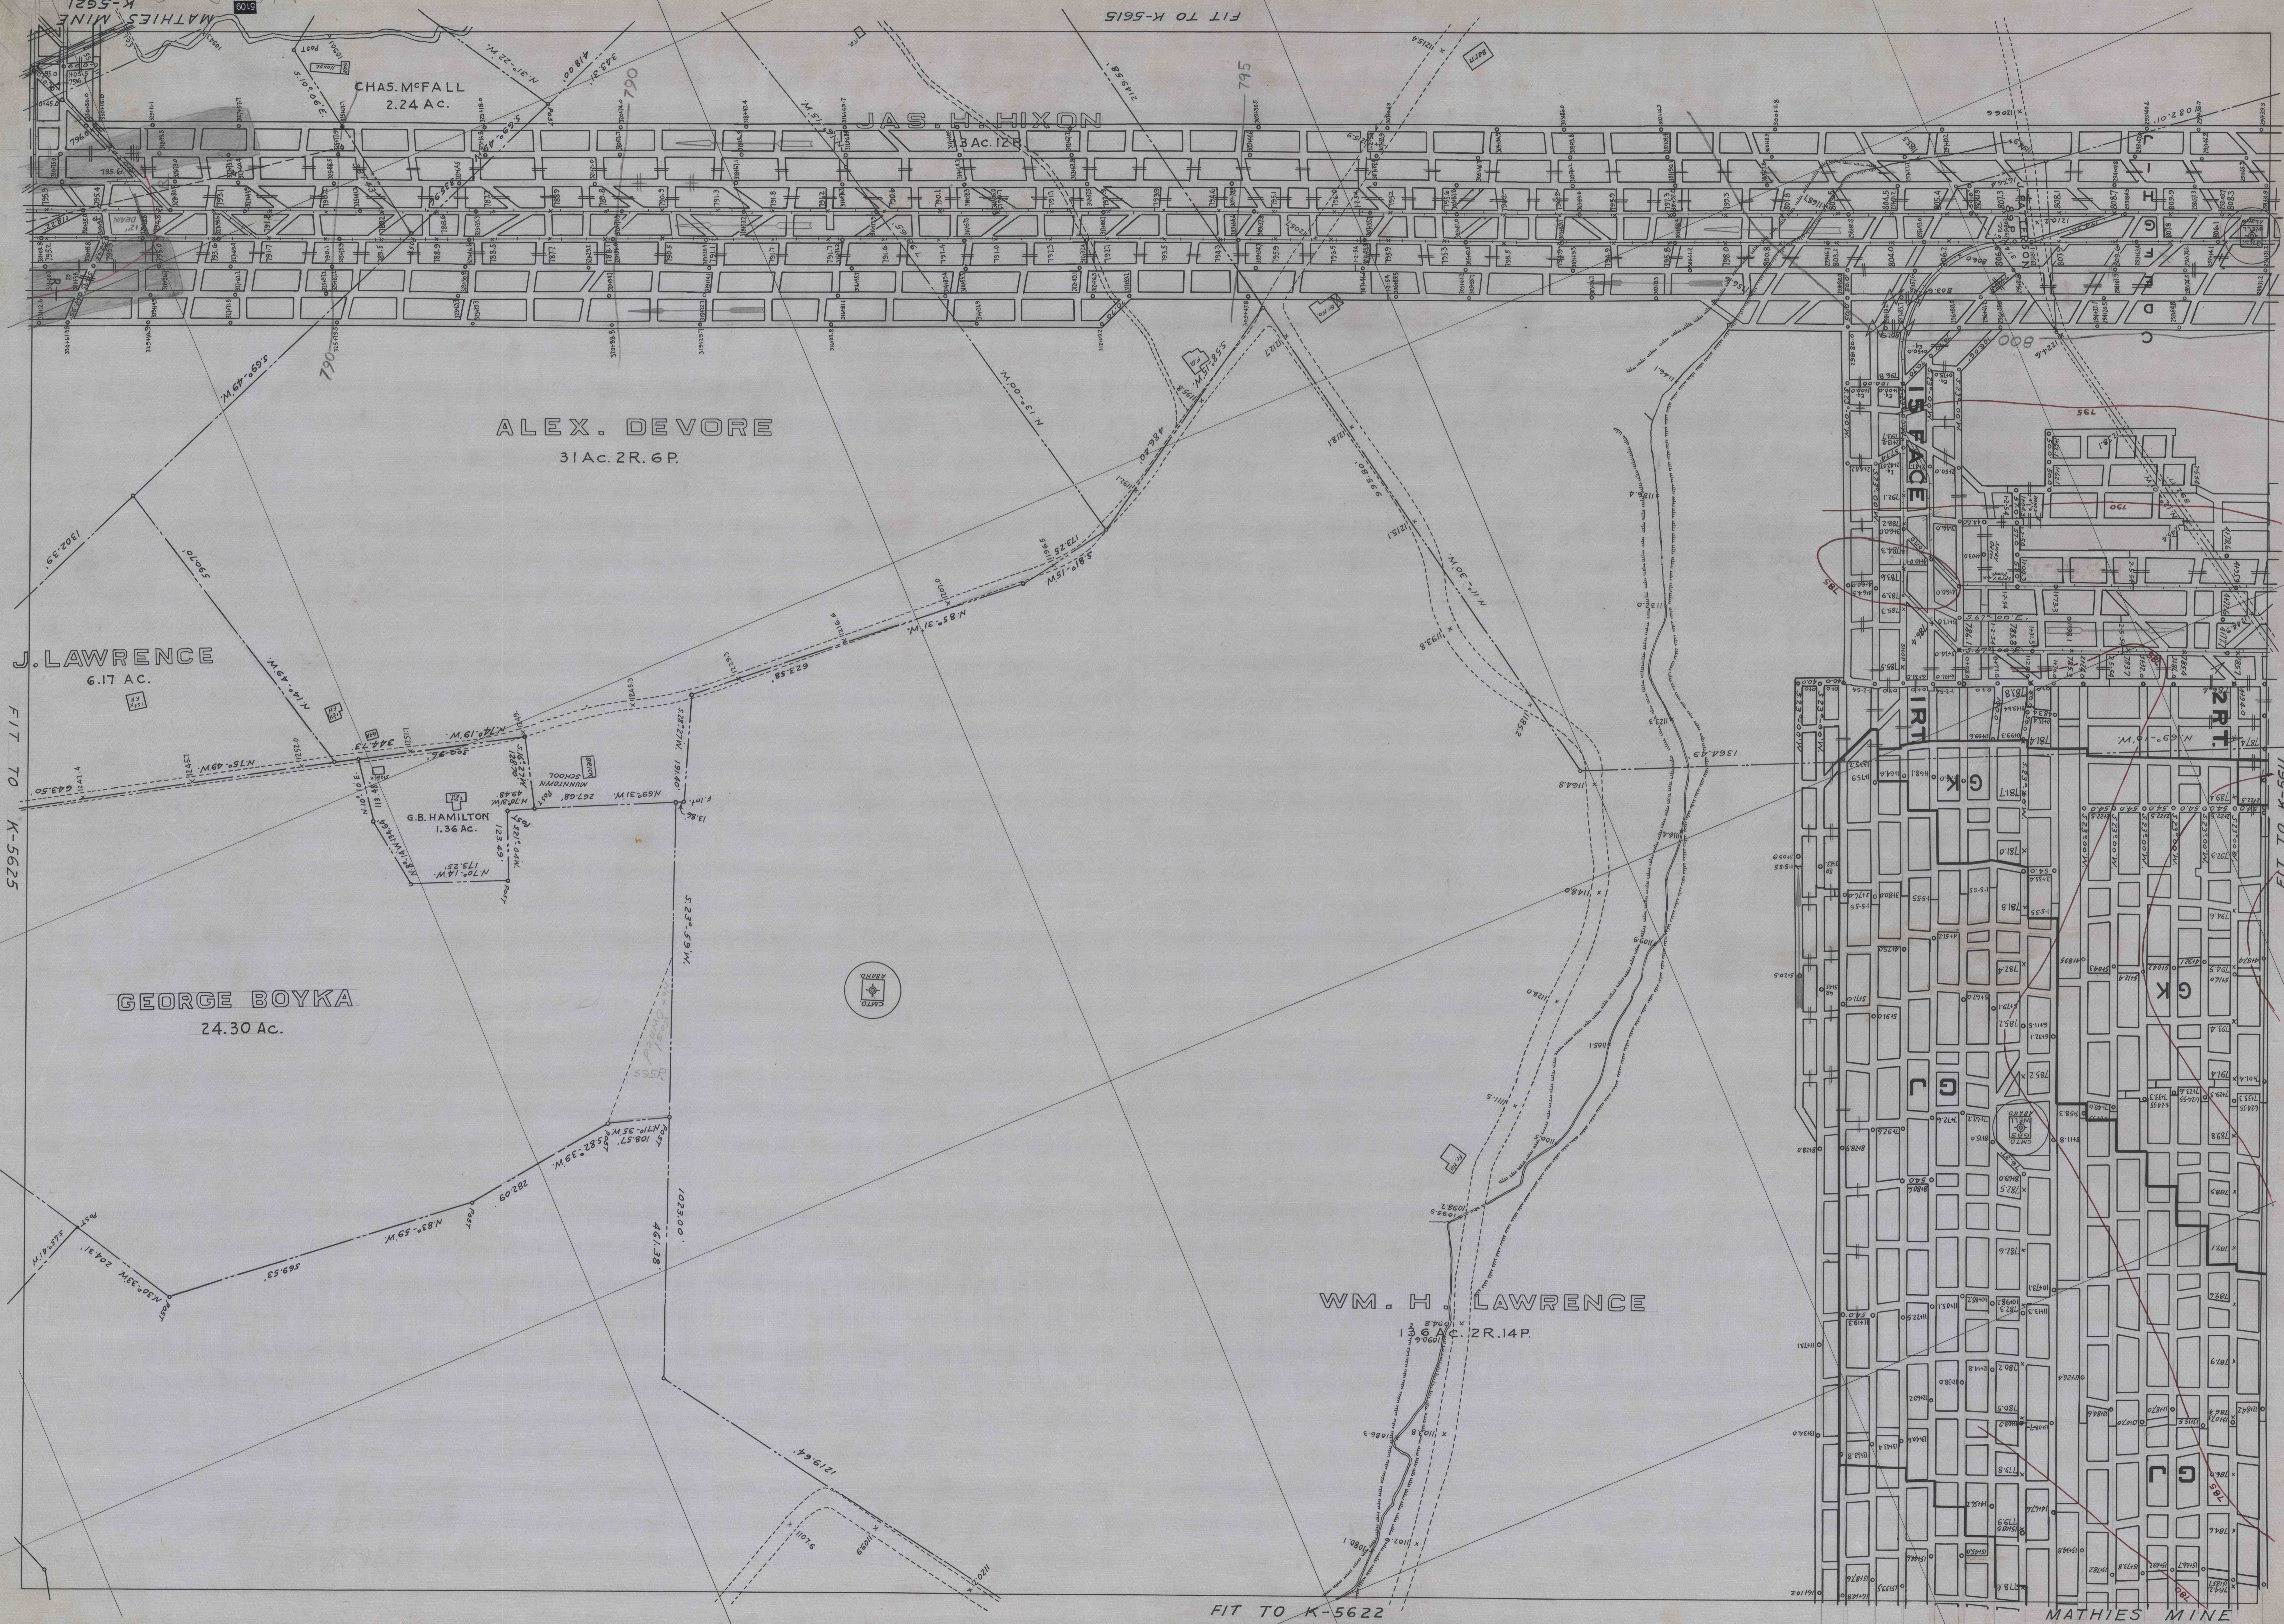

ALEX. DEVORE
31 Ac. 2R. 6P.

WM. H. LAWRENCE
13.6 AC. 2R. 14P.

GEORGE BOYKA
24.30 AC.

CHAS. McFALL
2.24 AC.

J. LAWRENCE
6.17 AC.

G.B. HAMILTON
1.36 AC.

MATHIES MINE

VOID See New PLASTIC K-5621

FIT TO K-5615

FIT TO K-5625

FIT TO K-5622

FIT TO K-5611