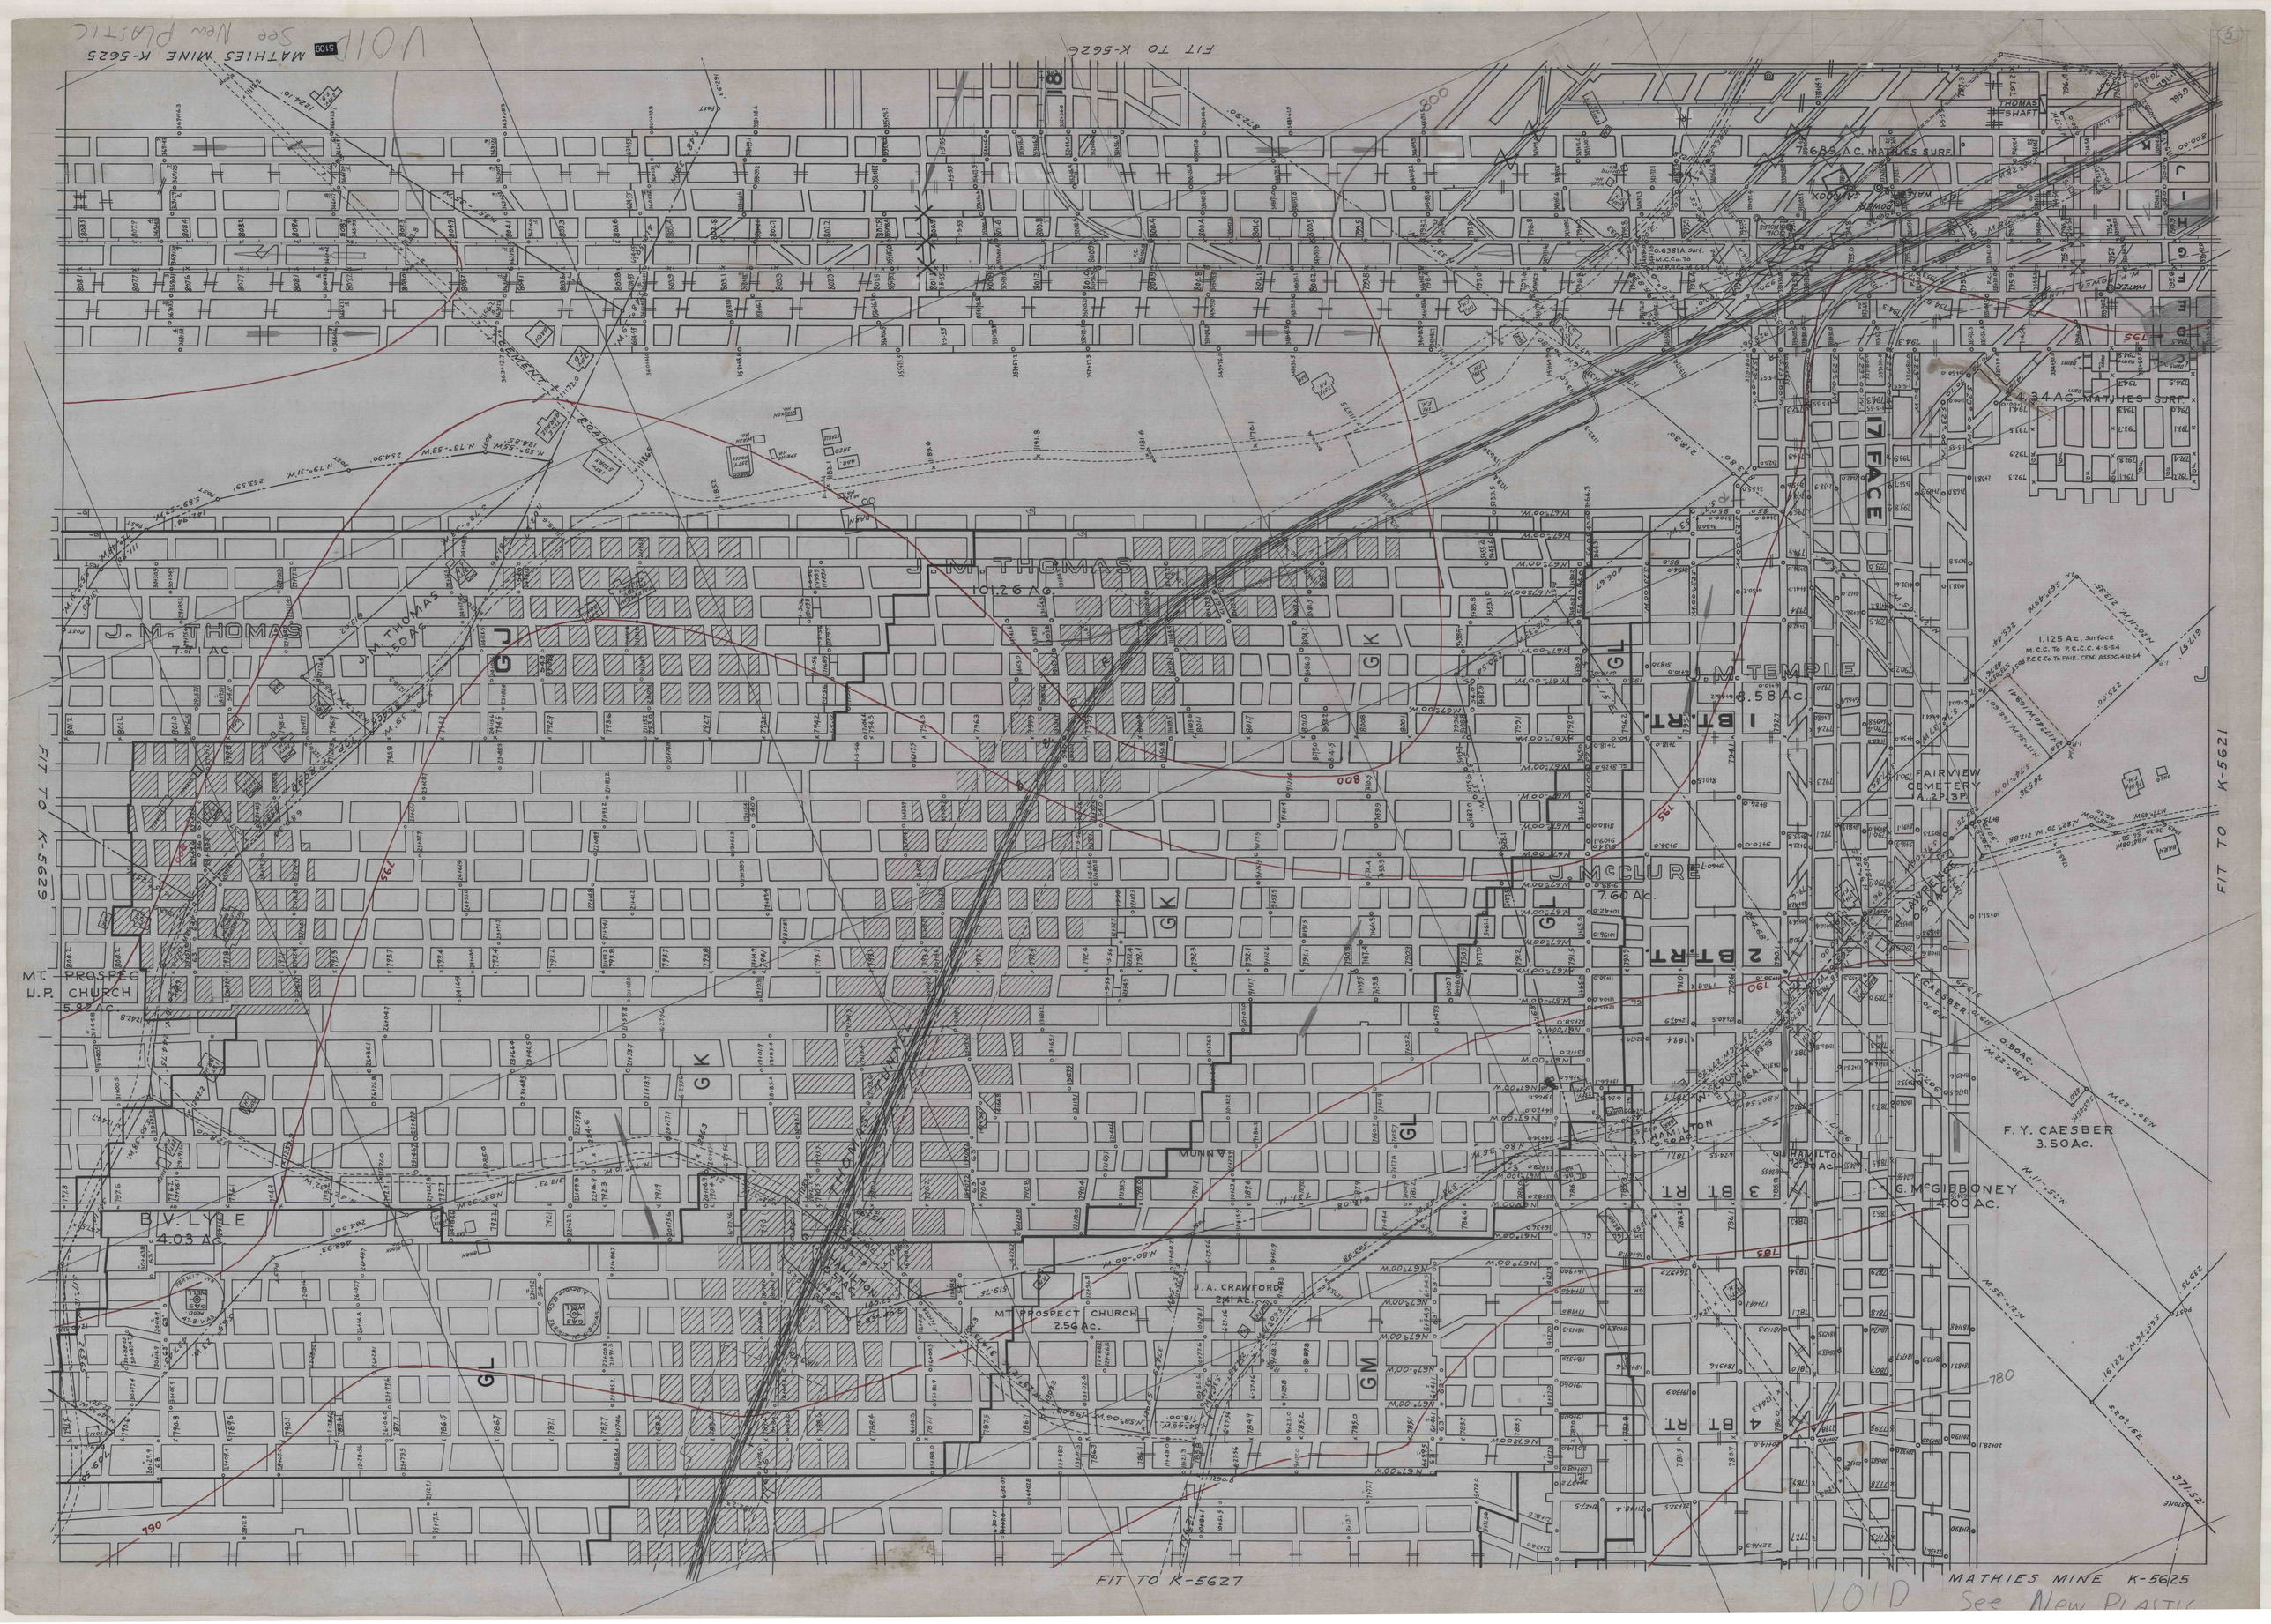

MATHIES MINE K-5625
VOID See New Plastic
FIT TO K-5626
FIT TO K-5629
FIT TO K-5627
FIT TO K-5621
J. M. THOMAS
101.26 Ac.
J. M. THOMAS
7.71 Ac.
J. M. THOMAS
1.50 Ac.
J. M. TEMPLE
8.58 Ac.
J. McCLURE
7.60 Ac.
B. V. LYLE
4.03 Ac.
MT. PROSPECT CHURCH
2.56 Ac.
J. A. CRAWFORD
2.41 Ac.
MT. PROSPECT U.P. CHURCH
5.82 Ac.
FAIRVIEW CEMETERY
A.2P.3P.
F. Y. CAESBER
3.50 Ac.
G. McGIBBONEY
4.00 Ac.
1.125 Ac. Surface
THOMAS SHAFT
7.689 Ac. MATHIES SURF.
4.34 Ac. MATHIES SURF.
17 FACE
1 BT. RT.
2 BT. RT.
3 BT. RT.
4 BT. RT.
GJ
GK
GL
GM
MATHIES MINE K-5625
VOID See New Plastic